

Fargo Public Schools Maintenance Projects

Fargo, ND & Moorhead MN (Various Locations)

ICON Job 24-060

Addendum 001

Date: 12/30/2024



ADDENDUM 001:

This Addendum consists of (12) pages and (21) drawing sheets.

Operations Center will be a part of GMP#2.

PART I- ADDENDUM FOR CIVIL SPECIFICATIONS AND DRAWINGS: ***SPECIFICATIONS***

DRAWINGS

Added Sheets:

Eagles Elementary:

E-C1

E-C2

E-C3

E-C4

E-C5

E-C6

E-C7

E-C8

Longfellow Elementary:

LO-C1

LO-C2

LO-C3

LO-C4

LO-C5

LO-C6

LO-C7

LO-C8

PART II- NOT USED (ADDENDUM FOR STRUCTURAL SPECIFICATIONS AND DRAWINGS)

PART III- ADDENDUM FOR ARCHITECTURAL SPECIFICATIONS AND DRAWINGS:

Fargo Public Schools Maintenance Projects

Fargo, ND & Moorhead MN (Various Locations)

ICON Job 24-060

Addendum 001

Date: 12/30/2024



SPECIFICATIONS

Specification Manual Cover

- 1) Updated with new ICON logo and information.

Table of Contents

- 2) Updated for added Section.

Section 08 8000

- 1) Changes noted in Red.

Section 09 6500

- 3) Section Added.

DRAWINGS

Sheet ND-G001

- 1) Drawing Index Updated.

Sheet MN-G001

- 1) Drawing Index Updated.

Sheet T-A001

- 1) General Note 2 added.
- 2) Replace Vinyl Flooring Comment added to sheet.

Sheet T-A101

- 1) General Notes added.
- 2) Keynote 6 added.
- 3) Vinyl flooring replacement noted on floor plan.

Sheet CE-A001

- 1) Missed Windows added.

PRIOR APPROVALS

Section 08 8000

Approved Substitution Request:

Manufacturer; Oldcastle Building Envelope

Address: 5334 Barthel Drive, Albertville, MN 55301

Phone: 763-497-4865

Fargo Public Schools Maintenance Projects

Fargo, ND & Moorhead MN (Various Locations)

ICON Job 24-060

Addendum 001

Date: 12/30/2024



PART IV – NOT USED (THEATER AND/OR FOOD SERVICE DRAWINGS AND SPECIFICATIONS)

PART V- ADDENDUM FOR MECHANICAL SPECIFICATIONS AND DRAWINGS: SPECIFICATIONS

DRAWINGS

PRIOR APPROVALS

Section 23 5216.20

Approved Substitution Request:

Manufacturer: Torus RBI

Make/Model: To match schedule and specifications

PART VI - ADDENDUM FOR ELECTRICAL SPECIFICATIONS AND DRAWINGS: SPECIFICATIONS

DRAWINGS

-END OF ADDENDUM 001-

SCOPE VERIFICATION CHECKLIST
(REQUIRED TO BE SUBMITTED WITH BID)

FPS MSA 2024
Construction Documents Dated 12/18/2024
Bid due date: 01/09/2025

Bidder Company: _____
Contact Name: _____
Contact Phone Number: _____

**** PLEASE INCLUDE THIS COMPLETED FORM WITH BID FORM WHEN SUBMITTING BID ****

09	General Bid Package Description - Select Demo, Misc. Steel Install, Carpentry, & Flooring (Add 1)	
	The Bid Amount (as indicated on Bid Form) is to include ALL work applicable to the Scope of Work as shown in the Drawings and Specifications. Listed below are additional clarifications for this Scope of Work. These are meant to be specific clarifications only and are not all inclusive. Any discrepancies noted by Bidder may result in disqualification of the Bid. This document may be included as an attachment to the Subcontract.	
	Inclusions	Please indicate "included" on each line below to confirm that each scope item is included
	Bid Documents:	
	Invitation to Bid	
	Sample Subcontract and Exhibits	
	Insurance Requirements and Sample COI	
	McGough Safety Standards	
	Project Schedule Dated 02/16/2024	
	Bid Form (Submit with Bid)	
	Specifications Dated 12/18/2024	
	Construction Drawings Dated 12/18/2024	
	Addendum(s) (please list recognized addendums)	
	Spec Sections	
	DIVISION 00 BIDDING AND CONTRACT REQUIREMENTS	
	DIVISION 01 GENERAL REQUIREMENTS	
	02 4100 - Demolition	
	06 1000 - ROUGH CARPENTRY	
	08 1113 - HOLLOW METAL DOORS AND FRAMES	
	09 6813 - TILE CARPETING	
	12 3600 - COUNTERTOPS	
	All other specifications as applies	
	General Inclusions	
	Subcontractor acknowledges that the Contract Documents are not fully complete. Subcontractor has included in its scope and "Lump Sum" price all items and necessary appurtenances that are required and/or are reasonably inferable to provide a complete scope of work	
	In conformance with the documents, Subcontractor's bid includes material, equipment, tools, hoisting, scaffolding, platforms, temporary bracing, labor, subsistence/per diem, travel expenses, shipping, project management, coordination, planning, permits required for this scope, bonds, insurance per McGough requirements, all federal, state and local taxes, fees, overhead costs and profits	
	Subcontractor agrees to provide scope of work in accordance with documents, industry standards and applicable building codes. Where any of the above conflict with another, Subcontractor is responsible for obtaining clarification from McGough prior to commencing work. Any rework resulting from a failure to do so or resulting from poor workmanship or quality of materials is the sole responsibility of the Subcontractor	
	Subcontractor has agreed to completing the McGough prequalification process	
	Subcontractor to provide schedule of values and cash flow projections each month w/ pay application	
	Subcontractor agrees to provide updated manpower projections to McGough as requested and has included all costs to do so	

SCOPE VERIFICATION CHECKLIST
(REQUIRED TO BE SUBMITTED WITH BID)

FPS MSA 2024

Construction Documents Dated 12/18/2024

Bid due date: 01/09/2025

	Include all required licenses, state and local permits	
	Subcontractor to provide additional pricing upon request from McGough within 5 business days for all scope of work changes. Pricing will need to be provided on a company letterhead cover sheet with additional backup provided on a McGough change order form. Backup at a minimum will need to provide material and labor breakouts. McGough reserves the right to request additional backup to solidify the proposed pricing submitted.	
	Change order profit and overhead cost for added work performed by Subcontractor's own forces 10% of the cost of work , For added work performed by sub Subcontractor's 5% of the cost due to the sub Subcontractor.	
	Subcontractor has accounted for providing an updated cost log to McGough on a monthly basis. Cost log should at a minimum show all executed and pending cost changes and their values	
	Include insurance in accordance with McGough requirements; including pollution insurance if scope of work requires	
	Include all specified submittals, warranties and mockups	
	Subcontractor to provide all closeout materials and warranties per the scope and duration noted in the documents. Warranties are to start at the date of substantial completion of the entire project and is irrespective of any use of work for temporary services during construction	
	Provide submittals in a timely manner to account for lead times and changes in design. Subcontractor shall be solely responsible for impacts due to providing late and/or incomplete submittals as well as submitting large quantities at once ("dumping") that hinders timely review	
	Use of tobacco is not permitted on FPS campus'. No smoking will be allowed anywhere on the project site.	
	No radios other than communication type radios will be permitted on the job site	
	Standard work hours are 7:00 am to 3:30 pm. Work outside these hours shall be coordinated with McGough. Crews expected to be onsite Monday through Friday	
	Subcontractors Superintendent or Foreman and Project manager shall attend weekly on-site coordination meetings as applicable to your scope. Supt. or Foreman shall also participate in "daily huddle" approx. 15 minutes to discuss that days activities	
	Subcontractor is responsible for adhering to the project schedule as issued by McGough. Subcontractor is solely responsible for any impacts caused to the Owner, Architect/Engineer, Subcontractor or other Sub Subcontractors as a result of schedule delays it causes and must provide resources including its own labor on overtime to recover delays. Subcontractor will also be responsible for costs borne by McGough and/or other Sub Subcontractors and Suppliers to recover delays it causes	
	Include participation in periodic schedule pull plan sessions and weekly project Sub Subcontractor meetings during or as appropriate to your scope. Subcontractor agrees to actively partake in project scheduling activities including providing accurate time estimates to McGough Superintendents and providing comments and feedback to schedules issued by McGough	
	Perform installation in sequences directed by McGough to support the construction schedule	
	Utility locates as required for any earthwork/underground/etc. is responsibility of Subcontractor	

SCOPE VERIFICATION CHECKLIST
(REQUIRED TO BE SUBMITTED WITH BID)

FPS MSA 2024

Construction Documents Dated 12/18/2024

Bid due date: 01/09/2025

	Subcontractor is responsible for coordinating with the testing agency and McGough superintendent and has accounted for costs associated with providing adequate access and time needed to perform such inspections and testing of its scope of work. Subcontractor shall bear sole responsibility and associated costs for retesting or additional testing as a result of poor workmanship or quality of materials	
	Mock-ups are required per the Documents. Subcontractor to build mock-ups that pertain to its scope of work as indicated in the documents, in a manner that they serve the intended purpose of review and adjustment by the owner, architect/engineer and Subcontractor. Mock-ups are to be constructed in a timely manner by the persons responsible for the final in-place construction and are to be coordinated between Subcontractor and McGough Project Superintendent	
	Subcontractor has included any costs associated with manufacturer field visits as noted in the documents or is standard in the field that Subcontractor performs this scope of work in	
	Subcontractor is responsible for all costs related to delayed construction and review of mock-ups	
	Subcontractor to conform to all safety regulations per applicable OSHA and McGough standards and participate in McGough Safety Program	
	Subcontractor shall provide their site-specific safety plan to McGough prior to starting work including all material SDS pertaining to your scope of work. Hard copies of SDS are required to be onsite and stored in McGough construction office	
	Except in designated break areas and office trailers, all Subcontractor personnel working on site need to wear shirts with minimum 4" sleeves (tank tops not allowed), full length pants, class II high vis vest/jacket, Type II safety helmets, Level III cut-resistant gloves, hard sole work boots, and ANSI's Z87.1-2003 rated safety glasses	
	All Subcontractors' employees working on site will be required to attend our on-site safety orientation prior to starting work. This orientation is approximately 45 mins to 1 hour in length and generally will be scheduled to occur once per week	
	Provide roof and leading edge fall protection (harnesses and retractable, etc. for your employees as required to meet 6-foot fall protection rule (any worker above 6 feet must be tied off 100% of time). This includes and all work occurring on the roof levels, at all times, as there is no temporary or permanent perimeter guardrail system	
	McGough will conduct a weekly safety meeting of approximately 30 mins. In length. Attendance is required for all workers onsite	
	Subcontractor shall provide all safety equipment (i.e. fire ext., PPE, fall protection, safety barricades, devices, covers, etc.) as required for the safe conduct of their work and in accordance w/ the latest OSHA requirements	
	Required that each Subcontractor has a competent person as determined by OSHA onsite when the Subcontractor is mobilized and performing work	
	Traffic control as required to complete scope of work	
	Site will have very limited space for laydown. All deliveries and any on site storage to be made in consultation with McGough project superintendent	
	Provide material handling within the building as applicable for their scope of work	
	Provide all survey, staking and layout associated with this work. Control points for the building will be provided by others	
	Subcontractor and all Sub-Subcontractors are required to provide cleanup of their materials and debris/dust created from completing their scope of work. McGough will not be providing general site cleanup.	

SCOPE VERIFICATION CHECKLIST
(REQUIRED TO BE SUBMITTED WITH BID)

FPS MSA 2024

Construction Documents Dated 12/18/2024

Bid due date: 01/09/2025

	Subcontractor is responsible for all design, engineering, procurement, construction and removal of any temporary bracing, supports etc. needed to complete Subcontractor's scope of work safely and without impacting existing work in place. If Subcontractor believes, contrary to McGough, that such controls are not needed for a given condition, it is responsible for conducting engineering to substantiate its claim	
	Subcontractor is responsible for removing all hazardous waste off-site in accordance with laws and regulations. Provide documentation of such removals to McGough within 24 hours. Owner has hired a third party abatement Subcontractor to remove all asbestos containing materials.	
	Subcontractor is responsible for removing all non-hazardous waste to the on-site dumpsters. Dumpsters to be provided by McGough.	
	Any and all Subcontractors installing materials or equipment after the permanent roofing is installed must provide proper and adequate protection of the roofing materials during their scope of work. Protection will be 1" insulation and 1/2" plywood	
	Subcontractor is responsible for providing power to their trailer(s), Connex boxes and any power connections for tools/equipment that are beyond typical 20amp outlet.	
	Include distribution of temp power, extension cords and task lighting for your scope	
	Subcontractor shall provide their own temp. elec. power and lighting as required until the elec. Subcontractor completes the initial temp. service and wiring installation for the project. Once the initial service is completed, temp. power, wiring, lighting and distribution will be provide in accordance w/ current OSHA requirements. Any requirements in excess of these shall be at the expense of the Subcontractor. Any electrical service in excess of single phase, 120V power shall be the responsibility of the Subcontractor. All temp. work shall be removed by the installing Subcontractor	
	Subcontractor is responsible for cutting and patching of all penetrations through walls, partitions, floors, ceilings and roofs necessary for the installation of its work	
	Subcontractor is responsible for maintaining a current set of construction documents for use by its crew. Changes to construction documents will be distributed electronically by McGough to all Subcontractors. Extra hard copies will not be provided by McGough for use by Subcontractors	
	Subcontractor has included all costs associated with maintaining and submitting on request, electronic copies of all as-builts pertaining to its scope of work	
	Subcontractor shall respect the work of others and shall be responsible for costs incurred in repairing work by others damaged by its personnel	
	Subcontractor to submit Quality Control Program to McGough a minimum of 15 days prior to starting its scope of work. McGough to review and provide recommendations on changes if any are required	
	Subcontractor to conduct quality control steps as noted in the Quality Control Program and specifications and documents. Submit all reports and inspection records to McGough within 24 hours of completion	
	Subcontractor agrees to rectify any deficient work within 3 days of being notified by Owner, Architect/Engineer, AHJ, Third Party Testing Agency, Manufacturer or Subcontractor. Documentation of remedial action is the responsibility of the Subcontractor. Subcontractor shall bear sole responsibility for costs where such deficiencies impact the work of others	

SCOPE VERIFICATION CHECKLIST
(REQUIRED TO BE SUBMITTED WITH BID)

FPS MSA 2024

Construction Documents Dated 12/18/2024

Bid due date: 01/09/2025

	Subcontractor acknowledges that it is responsible for all its tiered Sub Subcontractors and that McGough reserves the right to reasonably object to any tiered Sub Subcontractor with a current EMR greater than 1.0 may be awarded work on this project	
	3rd party engineering of scope of work per contract documents and/or standard trade practices required	
	Attend preinstallation meeting prior to start of work	
	The Prime Contract includes terms and conditions requiring certain information pertaining to Registered Sex Offenders ("RSO"). By signing this Subcontract, Subcontractor acknowledges and certifies its compliance with the terms of Section 3.4.3 of the Prime Contract requiring notification of RSOs, including, to the extent possible, background checks. The Owner reserves the right to not allow RSOs to work on State Institution property.	
	Specific Scope Inclusions	
	General	
	This package captures all pertinent items included in both the "Renovation" and "New Construction" extents. Please reference the document titled "NDSU ROEC New Construction vs Renovation Extents" provided as part of the bidding documents for clarification	
	This package will require the contractor to work on multiple spaces at the same time. Contractor is to assume the use of two separate crews while renovations and new construction are ongoing together. Contractor to provide one foreman for new construction work and one foreman for Renovation work.	
	The Project schedule will require this package to work overtime to meet the durations required for a completed scope of work. Contractor to verify schedule and include the necessary overtime to meet the scheduled durations.	
	Site will have very limited space for laydown. All deliveries and any on site storage to be made in consultation with McGough project superintendent	
	Provide material handling within the building as applicable for their scope of work	
	Subcontractor is responsible for maintaining a clean job site as it relates to its scope of work. Additional cleanup maybe required by Subcontractor as determined by McGough. Include equipment for your scope including trash carts for material transfer from floors. Note, McGough will not perform general site cleanup. All trades are responsible for cleanup of their activity and materials to include the dumping of materials into jobsite dumpsters.	
	Provide 40 labor hours to be utilized at the discretion of McGough for site services such as periodic cleanup, material handling, temporary provisions, jobsite safety, etc. Subcontractor will be responsible for tracking these hours and submitting monthly usage reports to McGough. (ADD 1)	
	Select Demo	
	Subcontractor shall remove / demolish all materials as indicated in the architectural drawings. MEP & masonry materials removals to be by others.	
	Subcontractor shall provide all interior demolition in existing buildings as indicated in the construction documents. Masonry material removals to be by others.	

SCOPE VERIFICATION CHECKLIST
(REQUIRED TO BE SUBMITTED WITH BID)

FPS MSA 2024

Construction Documents Dated 12/18/2024

Bid due date: 01/09/2025

	Subcontractor to provide a site specific demolition plan to McGough for review 2 weeks prior to beginning work onsite.	
	No demolition activities can occur in active buildings or without first coordinating with FPS and McGough. Subcontractor will be responsible for barricading off demolition area from pedestrians and construction workers alike.	
	Removal of demolition debris is the responsibility of this Subcontractor. McGough will provide dumpsters onsite.	
	All demolition debris to be cleaned up and removed at the end of each working day at a minimum.	
	Subcontractor shall provide all PPE, material handling equipment, and tools to their workers to facilitate demolition.	
	Per OSHA guidelines, Subcontractor understands no dry cutting of masonry or concrete products will be allowed onsite. Wet cutting or vacuums will be required.	
	Provide dust mitigation. Plan to be reviewed and approved by McGough personnel prior to work beginning on site. Dust mitigation is not limited to what is shown on the construction documents.	
	Subcontractor has reviewed the provided asbestos reports and understand all asbestos containing materials will be abated by the Owner. No cost for demoing asbestos containing materials are included.	
	Protection of existing finishes to remain in place.	
	Air quality monitoring included and addressed as needed utilizing proper equipment such as air scrubbers, hepa filters, negative air machines, etc.	
	Temp barricades / protection provided by this subcontract as needed when performing demo in active areas. Keep dust out of active areas and protect / keep pedestrians out of demolition extents	
	Subcontractor is responsible for maintaining a clean job site as it relates to its scope of work. Additional cleanup maybe required by Subcontractor as determined by McGough. Include equipment for your scope including trash carts for material transfer from floors. Note, McGough will not perform general site cleanup. All trades are responsible for cleanup of their activity and materials to include the dumping of materials into jobsite dumpsters.	
	Contract to include allowance of 80 Man hours for the demolition of unforeseen conditions encountered onsite. These hours will need to be tracked and submitted to McGough when used.	
	Remove, store & protect stadium seating for reinstalltion as described in the construction documents.	
	Remove popped & spalding grout cover from precast embed plates at Operations Center	
	Dismantle, store, & protect Centennial Mezzanine stair.	
	Provide, install, maintain, & dismantle temporary structural shoring of precast floor structure at South high for Masonry repairs.-(Add 1)	
	Demo, salvage, & protect wood doors & hardware.	
	Remove, salvage, & protect Carpet flooring as described in the construction documents.	
	Steel Install	
	All misc metals and handrails / guardrails for skywalk structures	
	Install all misc steel angles and equipment supports as shown in the architectural drawings.	
	All steel assemblies and handrails / Guardrails	
	Provide and install required Shims	
	Coordinate sequence and deliveries with steel fabricator, assume on-time deliveries and no on-site storage.	
	Provided all surveying and layout associated with this scope of work.	

SCOPE VERIFICATION CHECKLIST
(REQUIRED TO BE SUBMITTED WITH BID)

FPS MSA 2024

Construction Documents Dated 12/18/2024

Bid due date: 01/09/2025

	Provide rigger and signal person for steel erection	
	All equipment: including hoist, hoisting equipment, tools and acc. to complete this scope of work.	
	Grind all exposed welds to receive paint or at public spaces smooth	
	Grouting of all steel baseplates	
	Site will have very limited space for laydown. All deliveries and any on site storage to be made in consultation with McGough project superintendent	
	Re-weld & grout embed plates at Operations Center-(Add 1)	
	Re-install steel mezzanine stair at Centennial	
	Rough Carpentry	
	All exterior rough carpentry (ext. walls, parapets, opening blocking, roof blocking, guardrails, handrails, etc.) sheathing and wood blocking.	
	Wood Blocking around all openings as detailed.	
	Finish Carpentry and Millwork	
	Provide and install Architectural sills and acc.	
	Verify all finishes with specifications. Contractor to provide all samples for approval.	
	Provide finished ends where indicated.	
	Field verifications required to complete scope of work. This will be required to be completed in a timely fashion to align w/ installation of scope of work per construction schedule (i.e. if this requires field verifications measure from rough openings or framing and factor in finishes dimensions, that will be responsibility of contractor). This will need to be reviewed w/ McGough prior to completing verifications	
	Door Frames and Doors	
	Provide and install all hollow metal frame.	
	Install salvaged wood doors and hardware	
	Bondo all holes in frames from fasteners or installation	
	Receive and distribute all hollow metal doors and frames	
	Verify frames with additional prep for hardware	
	Factory finishing as specified	
	Hollow metal frames in masonry / concrete openings to be grouted by this subcontractor	
	Provide temporary protection of existing wood, metal, & Aluminum doors during construction extents through paths of travel.	
	Flooring	
	Replace salvaged flooring as indicated in the construction documents.	
	furnish & install new flooring finishes as indicated in the construction documents.	
	Specialties and Accessories	
	Reinstall Fixed Audience Seating system including all accessories	
	Miscellaneous	
	Install wood safety railing at all pits and floor openings. Maintain these during construction	
	Miscellaneous Requested Information:	
	Quantities	
	Confirm you can meet schedule or provide overall estimated duration (in Weeks) to complete scope of work If Differs from McGough Project Schedule	
	What is your anticipated crew size	

SCOPE VERIFICATION CHECKLIST
(REQUIRED TO BE SUBMITTED WITH BID)

FPS MSA 2024

Construction Documents Dated 12/18/2024

Bid due date: 01/09/2025

	Indicate the number of mobilizations included	
	Provide names of any tiered subSubcontractors	
	Specify scope of work to be done by tiered subSubcontractors	
	Value of Select Demo Package	
	Value of Misc. Metals Install Package	
	Value of Rough & Finish Carpentry Package.	
	Value of Flooring Package	
	Lead Times	
	Door frames	
	Exclusions	List any Specific Exclusions
	setting of hollow metal door and window frames in metal stud framed walls	
	Payment and performance bonds	
	Prefinished metal coping, gutters & downspout removals	
	EIFS Demo	
	Brick or CMU Demo.	
	Existing aluminum or wood glazing system Demo.	
	Playground structure Demo or modification.	
	Asphaltic Roof shingle demo.	
	Window & Door demo or replacement at Trollwood.	
	Estimate Breakout	Value Included in Bid
	Voluntary Alt. - Demo & dispose of Asphaltic Roofing, Existing roof sheathing & Install of new roof sheathing at North High.	
	Value of Select Demo Package	
	Value of Misc. Metals Install Package	
	Value of Rough & Finish Carpentry Package.	
	Value of Flooring Package	
	Bid Unit Pricing - wages, fringes, taxes, insurance, benefits, etc. Mark-ups for Overhead and Profit (OH&P) will be allowed however, DO NOT include mark-ups for OH&P in the Unit Pricing Below:	
	Labor Unit Pricing	Fully Loaded Labor Wage/Hour
	Trade	Regular Overtime Double-time
	Foreman	
	Laborer	
	Operator	
	Unit Pricing	Cost/Unit Unit

END OF CHECKLIST

FARGO PUBLIC SCHOOLS MAINTENANCE PROJECTS

PROJECT MANUAL

PROJECT NUMBER: 24-060

Bennett Elementary School
Carl Ben Eielson Middle School
Davies High School
Fargo Public Schools District Office
Eagles Elementary School
Lincoln Elementary School
Longfellow Elementary School
North High School
Fargo Public Schools Operations Center
South High School
Trollwood Performing Arts **Separated for City Review*
Washington Elementary School

ISSUE DATE: 12/18/2024

ISSUED BY:
ICON ARCHITECTURAL GROUP
3187 Bluestem Drive, STE 2
West Fargo, ND 58078

ICONARCHITECTS.COM | 701.772.4266

ICON ARCHITECTURAL GROUP

D. OFFUTT COMPANY **RDO**

**SECTION 00 0110
TABLE OF CONTENTS**

PROCUREMENT AND CONTRACTING REQUIREMENTS

1.01 DIVISION 00 -- PROCUREMENT AND CONTRACTING REQUIREMENTS

00 0103 - Project Directory

00 0107 - Seals Page

00 0110 - Table of Contents

SPECIFICATIONS

2.01 DIVISION 01 -- GENERAL REQUIREMENTS

01 2300 - Alternates

01 2500 - Substitution Procedures

01 4000 - Quality Requirements

01 7000 - Execution and Closeout Requirements

01 7800 - Closeout Submittals

01 7900 - Demonstration and Training

2.02 DIVISION 02 -- EXISTING CONDITIONS

02 4100 - Demolition

2.03 DIVISION 03 -- CONCRETE

2.04 DIVISION 04 -- MASONRY

04 0511 - Masonry Mortaring and Grouting

04 2000 - Unit Masonry

04 7200 - Cast Stone Masonry

2.05 DIVISION 05 -- METALS

05 5213 - Pipe and Tube Railings

2.06 DIVISION 06 -- WOOD, PLASTICS, AND COMPOSITES

06 1000 - Rough Carpentry

2.07 DIVISION 07 -- THERMAL AND MOISTURE PROTECTION

07 2400 - Exterior Insulation and Finish Systems

07 2600 - Vapor Retarders

07 2700 - Air Barriers

07 4113 - Metal Roof Panels

07 6200 - Sheet Metal Flashing and Trim

07 7123 - Manufactured Gutters and Downspouts

07 9200 - Joint Sealants

2.08 DIVISION 08 -- OPENINGS

08 1113 - Hollow Metal Doors and Frames

08 4313 - Aluminum-Framed Storefronts

08 8000 - Glazing

2.09 DIVISION 09 -- FINISHES

09 6500 – Resilient Flooring

- 09 6813 - Tile Carpeting
- 09 9113 - Exterior Painting
- 09 9300 - Staining and Transparent Finishing

2.10 DIVISION 10 -- SPECIALTIES

2.11 DIVISION 11 -- EQUIPMENT

2.12 DIVISION 12 -- FURNISHINGS

- 12 2400 - Window Shades
- 12 3600 – Countertops (Windowsill)

2.13 DIVISION 13 -- SPECIAL CONSTRUCTION

2.14 DIVISION 14 -- CONVEYING EQUIPMENT

2.15 DIVISION 21 -- FIRE SUPPRESSION

2.16 DIVISION 22 -- PLUMBING

- 22 0100.10 – Plumbing General Requirements (Bennett, Carl Ben, Centennial & Davies)
- 22 0110.10 – Plumbing Demolition (Bennett, Carl Ben, Centennial & Davies)
- 22 0553.10 – Plumbing Identification (Bennett, Carl Ben, Centennial & Davies)
- 22 0719.10 – Plumbing Piping Insulation (Bennett, Carl Ben, Centennial & Davies)
- 22 1005.10 – Plumbing Piping (Bennett, Carl Ben, Centennial & Davies)

2.17 DIVISION 23 -- HEATING, VENTILATING, AND AIR-CONDITIONING (HVAC)

- 23 0100.10 – HVAC General Requirements (Bennett, Carl Ben, Centennial & Davies)
- 23 0110.10 – HVAC Demolition (Bennett, Carl Ben, Centennial & Davies)
- 23 0500.20 – Basic HVAC Requirements (Lincoln & Longfellow)
- 23 0514.10 – Variable-Frequency Motor Controllers (Bennett, Carl Ben, Centennial & Davies)
- 23 0519.10 – Meters and Gauges for HVAC Piping (Bennett, Carl Ben, Centennial & Davies)
- 23 0519.20 – Meters and Gauges for HVAC Piping (Lincoln & Longfellow)
- 23 0553.10 – HVAC Identification (Bennett, Carl Ben, Centennial & Davies)
- 23 0593.10 – Testing, Adjusting and Balancing (Bennett, Carl Ben, Centennial & Davies)
- 23 0593.20 – Testing, Adjusting and Balancing for HVAC (Lincoln & Longfellow)
- 23 0713.10 – Duct Insulation (Bennett, Carl Ben, Centennial & Davies)
- 23 0716.10 – HVAC Equipment Insulation (Bennett, Carl Ben, Centennial & Davies)
- 23 0719.10 – HVAC Piping Insulation (Bennett, Carl Ben, Centennial & Davies)
- 23 0719.20 – HVAC Piping Insulation (Lincoln & Longfellow)
- 23 0913.10 – Instrumentation and Control Devices (Bennett, Carl Ben, Centennial & Davies)
- 23 0923.10 – Direct-Digital Control System (Bennett, Carl Ben, Centennial & Davies)
- 23 0950.20 – Gas Detection and Alarm (Lincoln & Longfellow)
- 23 1123.20 – Facility Natural-Gas Piping (Lincoln & Longfellow)
- 23 2112.10 – Ground-Coupled Heat Exchanger (Bennett, Carl Ben, Centennial & Davies)
- 23 2113.10 – Hydronic Piping (Bennett, Carl Ben, Centennial & Davies)
- 23 2113.20 – Hydronic Piping (Lincoln & Longfellow)
- 23 2114.10 – Hydronic Specialties (Bennett, Carl Ben, Centennial & Davies)
- 23 2114.20 – Hydronic Specialties (Lincoln & Longfellow)

- 23 2123.10 – Hydronic Pumps (Bennett, Carl Ben, Centennial & Davies)
- 23 2123.20 – Hydronic Pumps (Lincoln & Longfellow)
- 23 2500.10 – Chemical Water Treatment (Bennett, Carl Ben, Centennial & Davies)
- 23 2500.20 – HVAC Water Treatment (Lincoln & Longfellow)
- 23 3100.10 – HVAC Ducts and Casings (Bennett, Carl Ben, Centennial & Davies)
- 23 3300.10 – Air Duct Accessories (Bennett, Carl Ben, Centennial & Davies)
- 23 3413.10 – Axial HVAC Fans (Bennett, Carl Ben, Centennial & Davies)
- 23 3423.10 – HVAC Power Ventilators (Bennett, Carl Ben, Centennial & Davies)
- 23 3700.10 – Air Outlets and Inlets (Bennett, Carl Ben, Centennial & Davies)
- 23 5100.20 – Breechings, Chimneys and Stacks (Lincoln & Longfellow)
- 23 5216.20 – Condensing Boilers (Lincoln & Longfellow)
- 23 5234.10 – Finned Modular Boilers (Bennett, Carl Ben, Centennial & Davies)
- 23 5235.10 – Stainless Steel Modular Boilers (Bennett, Carl Ben, Centennial & Davies)
- 23 7313.10 – Air-Handling Units (Bennett, Carl Ben, Centennial & Davies)
- 23 8101.10 – Terminal Heat Transfer Units (Bennett, Carl Ben, Centennial & Davies)

2.18 DIVISION 25 -- INTEGRATED AUTOMATION

2.19 DIVISION 26 -- ELECTRICAL

- 26 0000 – Electrical General Requirements
- 26 0100 – Electrical Systems Close Out Documentation
- 26 0500 – Common Work Results for Electrical
- 26 0505 – Selective Demolition for Electrical
- 26 0519 – Low-Voltage Electrical Power Conductors and Cables
- 26 0526 – Grounding and Bonding for Electrical Systems
- 26 0529 – Hangers and Supports for Electrical Systems
- 26 0533.13 – Conduit for Electrical Systems
- 26 0533.16 – Boxes for Electrical Systems
- 26 0553 – Identification for Electrical Systems
- 26 0923 – Lighting Controls
- 26 2416 – Panelboards
- 26 2419 – Motor-Control Centers
- 26 2726 – Wiring Devices
- 26 2813 – Fuses
- 26 2816.16 – Enclosed Switches
- 26 5600 – Exterior Lighting

2.20 DIVISION 27 -- COMMUNICATIONS

2.21 DIVISION 28 -- ELECTRONIC SAFETY AND SECURITY

2.22 DIVISION 31 -- EARTHWORK

2.23 DIVISION 32 -- EXTERIOR IMPROVEMENTS

- 32 0519 - Geosynthetics for Exterior Improvements
- 32 1313 - Concrete Paving

32 1623 - Sidewalks

32 1816.13 - Playground Protective Surfacing

32 1823.39 - Synthetic Running Track Surfacing

2.24 DIVISION 33 -- UTILITIES

2.25 DIVISION 34 -- TRANSPORTATION

2.26 DIVISION 40 -- PROCESS INTEGRATION

2.27 DIVISION 46 -- WATER AND WASTEWATER EQUIPMENT

END OF SECTION 00 0110

SECTION 08 8000
GLAZING
(CENTENNIAL ELEMENTARY)

PART 1 GENERAL**1.01 SECTION INCLUDES**

- A. Insulating glass units.
- B. Glazing compounds.

1.02 RELATED REQUIREMENTS

- A. **Section 07 2700 - Air Barriers.**

1.03 REFERENCE STANDARDS

- A. ASTM C864 - Standard Specification for Dense Elastomeric Compression Seal Gaskets, Setting Blocks, and Spacers; 2005 (Reapproved 2019).
- B. ASTM C1036 - Standard Specification for Flat Glass; 2021.
- C. ASTM C1048 - Standard Specification for Heat-Strengthened and Fully Tempered Flat Glass; 2018.
- D. ASTM C1376 - Standard Specification for Pyrolytic and Vacuum Deposition Coatings on Flat Glass; 2021a.
- E. ASTM E1300 - Standard Practice for Determining Load Resistance of Glass in Buildings; 2016.
- F. ASTM E2190 - Standard Specification for Insulating Glass Unit Performance and Evaluation; 2019.
- G. NFRC 100 - Procedure for Determining Fenestration Product U-factors; 2023.
- H. NFRC 200 - Procedure for Determining Fenestration Product Solar Heat Gain Coefficient and Visible Transmittance at Normal Incidence; 2023.
- I. NFRC 300 - Test Method for Determining the Solar Optical Properties of Glazing Materials and Systems; 2023.

1.04 ADMINISTRATIVE REQUIREMENTS

- A. Preinstallation Meeting: Convene a preinstallation meeting one week before starting work of this section; require attendance by each of the affected installers.

1.05 SUBMITTALS

- A. See Section 01 3000 - Administrative Requirements for submittal procedures.
- B. Product Data on Insulating Glass Unit Glazing Types: Provide structural, physical and environmental characteristics, size limitations, special handling and installation requirements.
- C. Product Data on Glazing Compounds and Accessories: Provide chemical, functional, and environmental characteristics, limitations, special application requirements, and identify available colors.
- D. Samples: Submit two samples 12" by 12" inch in size **of glass units, showing coloration and design.**
- E. Certificate: Certify that products of this section meet or exceed specified requirements.
- F. Manufacturer's qualification statement.
- G. Installer's qualification statement.
- H. Warranty Documentation: Submit manufacturer warranty and ensure that forms have been completed in Owner's name and registered with manufacturer.

1.06 QUALITY ASSURANCE

- A. Manufacturer Qualifications: Company specializing in manufacturing the products specified in this section with minimum three years of documented experience.

- B. Installer Qualifications: Company specializing in performing work of the type specified and with at least three years documented experience.

1.07 MOCK-UPS

- A. See Section 01 4000 - Quality Requirements for additional requirements.
- B. Provide on-site glazing mock-up with the specified glazing components.
- C. Locate where directed.
- D. Mock-ups may remain as part of the Work.

1.08 FIELD CONDITIONS

- A. Do not install glazing when ambient temperature is less than 40 degrees F.
- B. Maintain minimum ambient temperature before, during and 24 hours after installation of glazing compounds.

1.09 WARRANTY

- A. See Section 01 7800 - Closeout Submittals for additional warranty requirements.
- B. Insulating Glass Units: Provide a five (5) year manufacturer warranty to include coverage for seal failure, interpane dusting or misting, including providing products to replace failed units.

PART 2 PRODUCTS

2.01 MANUFACTURERS

- A. Glass Fabricators:
 - 1. Trulite Glass & Aluminum Solutions, LLC: www.trulite.com/#sle.
 - 2. Viracon, Inc: www.viracon.com/#sle.
 - 3. Oldcastle; www.obe.com.
 - 4. Substitutions: See Section 01 6000 - Product Requirements.

2.02 PERFORMANCE REQUIREMENTS - EXTERIOR GLAZING ASSEMBLIES

- A. Provide type and thickness of exterior glazing assemblies to support assembly dead loads, and to withstand live loads caused by positive and negative wind pressure acting normal to plane of glass.
 - 1. Comply with ASTM E1300 for design load resistance of glass type, thickness, dimensions, and maximum lateral deflection of supported glass.
 - 2. Provide glass edge support system sufficiently stiff to limit the lateral deflection of supported glass edges to less than 1/175 of their lengths under specified design load.
 - 3. Glass thicknesses listed are minimum.
- B. Weather-Resistive Barrier Seals: Provide completed assemblies that maintain continuity of building enclosure water-resistive barrier, vapor retarder, and/or air barrier.
 - 1. In conjunction with weather barrier related materials described in other sections, as follows:
 - a. **Air Barriers: See Section 07 2700.**
 - 2. **To utilize inner pane of multiple pane insulating glass units for continuity of vapor retarder and/or air barrier seal.**
 - 3. **To maintain a continuous vapor retarder and/or air barrier throughout glazed assembly from glass pane to heel bead of glazing sealant.**
- C. Thermal and Optical Performance: Provide exterior glazing products with performance properties as indicated. Performance properties are in accordance with manufacturer's published data as determined with the following procedures and/or test methods:
 - 1. Center of Glass U-Value: Comply with NFRC 100 using Lawrence Berkeley National Laboratory (LBNL) WINDOW 6.3 computer program.
 - 2. Center of Glass Solar Heat Gain Coefficient (SHGC): Comply with NFRC 200 using Lawrence Berkeley National Laboratory (LBNL) WINDOW 6.3 computer program.
 - 3. Solar Optical Properties: Comply with NFRC 300 test method.

2.03 GLASS MATERIALS

- A. Float Glass: Provide float glass based glazing unless otherwise indicated.
1. Annealed Type: ASTM C1036, Type I - Transparent Flat, Class 1 - Clear, Quality - Q3.
 2. Kind FT - Fully Tempered Type: Complies with ASTM C1048.

2.04 INSULATING GLASS UNITS

- A. Manufacturers:
1. Cardinal Glass Industries: www.cardinalcorp.com/#sle.
 2. Guardian Glass, LLC: www.guardianglass.com/#sle.
 3. Pilkington North America Inc: www.pilkington.com/na/#sle.Pilkington North America Inc : www.pilkington.com/na/#sle.
 4. Viracon, Apogee Enterprises, Inc: www.viracon.com/#sle.
 5. Vitro Architectural Glass (formerly PPG Glass): www.vitroglazings.com/#sle.
 6. **Oldcastle; www.obe.com.**
 7. Substitutions: See Section 01 6000 - Product Requirements.
- B. Fabricator: Certified by glass manufacturer for type of glass, coating, and treatment involved and capable of providing specified warranty.
- C. Insulating Glass Units: Types as indicated.
1. Durability: Certified by an independent testing agency to comply with ASTM E2190.
 2. Coated Glass: Comply with requirements of ASTM C1376 for pyrolytic (hard-coat) or magnetic sputter vapor deposition (soft-coat) type coatings on flat glass; coated vision glass, Kind CV; coated overhead glass, Kind CO; or coated spandrel glass, Kind CS.
 3. **Metal-Edge Spacers: Aluminum, bent and soldered corners.**
 4. Spacer Color: Black.
 5. Edge Seal:
 - a. Dual-Sealed System: Provide polyisobutylene sealant as primary seal applied between spacer and glass panes, and silicone, polysulfide, or polyurethane sealant as secondary seal applied around perimeter.
 - b. Color: Black.
 6. Purge interpane space with dry air, hermetically sealed.
- D. Insulating Glass Units: Vision glass, double glazed.
1. Applications: Exterior glazing unless otherwise indicated.
 2. Space between lites filled with argon.
 3. Outboard Lite: **Fully tempered float glass**, 1/4 inch thick, minimum.
 - a. Tint: Clear.
 - b. Coating: Self-cleaning type, on #1 surface.
 - c. Coating: **Low-E (solar control type)**, on #2 surface.
 4. Metal edge spacer.
 5. Inboard Lite: **Fully tempered** float glass, 1/4 inch thick, minimum.
 - a. Tint: Clear.
 6. Total Thickness: 1 inch.
 7. Thermal Transmittance (U-Value) **per applicable energy code: .29**, nominal.
 8. Visible Light Transmittance (VLT): **70** percent, nominal.
 9. **Shading Coefficient: .45, nominal.**
 10. Solar Heat Gain Coefficient (SHGC): **.39**, nominal.
 11. **Visible Light Reflectance, Outside: 11 percent, nominal.**
 12. Glazing Method: Dry glazing method, gasket glazing.

2.05 BASIS OF DESIGN - INSULATING GLASS UNITS

- A. Basis of Design - Insulating Glass Units: Vision glazing, with low-e coating.
1. Applications: Exterior insulating glass glazing unless otherwise indicated.

2. Space between lites filled with argon.
3. Total Thickness: 1 inch.
4. Thermal Transmittance (U-Value), Summer - Center of Glass: .27, nominal.
5. Visible Light Transmittance (VLT): 70 percent, nominal.
6. Shading Coefficient: .45, nominal.
7. Solar Heat Gain Coefficient (SHGC): .39, nominal.
8. Visible Light Reflectance, Outside: 11 percent, nominal.
9. Glazing Method: Dry glazing method, gasket glazing.
10. Coated Glass: Comply with requirements of ASTM C1376 for pyrolytic (hard-coat) or magnetic sputter vapor deposition (soft-coat) type coatings on flat glass; coated vision glass, Kind CV; coated overhead glass, Kind CO; or coated spandrel glass, Kind CS.
11. Spacer Color: Black.
12. Edge Seal:
 - a. Dual-Sealed System: Provide polyisobutylene sealant as primary seal applied between spacer and glass panes, and silicone, polysulfide, or polyurethane sealant as secondary seal applied around perimeter.
13. Color: Black.
14. Purge interpane space with dry air, hermetically sealed.
15. Basis of Design - Vitro Architectural Glass (formerly PPG Glass): www.vitroglazings.com/#sle.
16. Outboard Lite: Fully tempered float glass, 1/4 inch thick, minimum.
 - a. Low-E Coating: Vitro Architectural Glass (formerly PPG Glass) Solarban 60 on #2 surface.
 - b. Glass: Clear.
17. Inboard Lite: Fully tempered float glass, 1/4 inch thick.

ACCESSORIES

- B. Setting Blocks: Silicone, with 80 to 90 Shore A durometer hardness; ASTM C864 Option II. Length of 0.1 inch for each square foot of glazing or minimum 4 inch by width of glazing rabbet space minus 1/16 inch by height to suit glazing method and pane weight and area.
- C. Glazing Splines: Resilient silicone extruded shape to suit glazing channel retaining slot; ASTM C864 Option II; color black.

PART 3 EXECUTION

3.01 VERIFICATION OF CONDITIONS

- A. Verify that openings for glazing are correctly sized and within tolerances, including those for size, squareness, and offsets at corners.
- B. Verify that surfaces of glazing channels or recesses are clean, free of obstructions that may impede moisture movement, weeps are clear, and support framing is ready to receive glazing system.

3.02 PREPARATION

- A. Clean contact surfaces with appropriate solvent and wipe dry within maximum of 24 hours before glazing. Remove coatings that are not tightly bonded to substrates.
- B. Seal porous glazing channels or recesses with substrate compatible primer or sealer.
- C. Prime surfaces scheduled to receive sealant where required for proper sealant adhesion.

3.03 INSTALLATION, GENERAL

3.04 INSTALLATION - DRY GLAZING METHOD (GASKET GLAZING)

- A. Application - Exterior and/or Interior Glazed: Set glazing infills from either the exterior or the interior of the building.
- B. Place setting blocks at 1/4 points with edge block no more than 6 inch from corners.
- C. Rest glazing on setting blocks and push against fixed stop with sufficient pressure on gasket to attain full contact.

- D. Install removable stops without displacing glazing gasket; exert pressure for full continuous contact.

3.05 INSTALLATION - PLASTIC FILM

- A. Install plastic film with adhesive, applied in accordance with film manufacturer's instructions.
- B. Place without air bubbles, creases or visible distortion.
- C. Install film tight to perimeter of glass and carefully trim film with razor sharp knife. Provide 1/16 inch to 1/8 inch gap at perimeter of glazed panel unless otherwise required. Do not score the glass.

3.06 FIELD QUALITY CONTROL

- A. Glass and Glazing product manufacturers to provide field surveillance of the installation of their products.
- B. Monitor and report installation procedures and unacceptable conditions.

3.07 CLEANING

- A. Remove excess glazing materials from finish surfaces immediately after application using solvents or cleaners recommended by manufacturers.
- B. Remove nonpermanent labels immediately after glazing installation is complete.
- C. Clean glass and adjacent surfaces after sealants are fully cured.
- D. Clean glass on both exposed surfaces not more than 4 days prior to Date of Substantial Completion in accordance with glass manufacturer's written recommendations.

3.08 PROTECTION

- A. After installation, mark pane with an 'X' by using removable plastic tape or paste; do not mark heat absorbing or reflective glass units.
- B. Remove and replace glass that is damaged during construction period prior to Date of Substantial Completion.

END OF SECTION 08 8000

SECTION 09 6500
RESILIENT FLOORING
(TROLLWOOD PERFORMING ARTS)

PART 1 GENERAL**1.01 SECTION INCLUDES**

- A. Resilient sheet flooring.
- B. Resilient base.
- C. Installation accessories.

1.02 REFERENCE STANDARDS

- A. ASTM F1303 - Standard Specification for Sheet Vinyl Floor Covering with Backing; 2004 (Reapproved 2021).
- B. ASTM F1861 - Standard Specification for Resilient Wall Base; 2021.
- C. RFCI (RWP) - Recommended Work Practices for Removal of Resilient Floor Coverings; 2018.

1.03 SUBMITTALS

- A. See Section 01 3000 - Administrative Requirements for submittal procedures.
- B. Product Data: Provide data on specified products, describing physical and performance characteristics; including sizes, patterns and colors available; and installation instructions.
- C. Selection Samples: Submit manufacturer's complete set of color samples for Architect's initial selection.
- D. Verification Samples: Submit two samples, 12 by 12 inch in size illustrating color and pattern for each resilient flooring product specified.

1.04 DELIVERY, STORAGE, AND HANDLING

- A. Upon receipt, immediately remove any shrink-wrap and check materials for damage and the correct style, color, quantity and run numbers.
- B. Store all materials off of the floor in an acclimatized, weather-tight space.
- C. Protect roll materials from damage by storing on end.

1.05 FIELD CONDITIONS

- A. Store materials for not less than 48 hours prior to installation in area of installation at a temperature of 70 degrees F to achieve temperature stability.

PART 2 PRODUCTS**2.01 SHEET FLOORING**

- A. Vinyl Sheet Flooring: Color and pattern throughout wear layer thickness, with backing.
 - 1. Manufacturers:
 - a. Mannington Commercial: www.manningtoncommercial.com#sle.
 - b. Substitutions: See Section 01 6000 - Product Requirements.
 - 2. Minimum Requirements: Comply with ASTM F1303, Type II, with Class A fibrous backing.
 - 3. Wear Layer Thickness: 0.050 inch minimum.
 - 4. Total Thickness: 0.080 inch minimum.
 - 5. Pattern: Choose Cost Effective for small space called out.
 - 6. Color: To be selected by Architect from manufacturer's standard range.

2.02 RESILIENT BASE

- A. Resilient Base: ASTM F1861, Type TV, vinyl, thermoplastic; Style B, Cove.
 - 1. Manufacturers:
 - a. Flexco Corporation; Base Sculptures: www.flexcofloors.com/#sle.

- b. Johnsonite, a Tarkett Company: www.johnsonite.com/#sle.
- c. Mannington Commercial: www.manningtoncommercial.com/#sle.
2. Height: 4 inches.
3. Thickness: 0.125 inch.
4. Finish: Satin.
5. Length: Roll.
6. Color: To be selected by Architect from manufacturer's full range.

2.03 ACCESSORIES

- A. Adhesive for Vinyl Flooring:
- B. Moldings, Transition and Edge Strips: Metal.
 1. Manufacturers:
 - a. Mannington Commercial: www.manningtoncommercial.com/#sle.
 - b. Schluter-Systems; VinPro: www.schluter.com/#sle.

PART 3 EXECUTION

3.01 EXAMINATION

- A. Verify that surfaces are flat to tolerances acceptable to flooring manufacturer, free of cracks that might telegraph through flooring, clean, dry, and free of curing compounds, surface hardeners, and other chemicals that might interfere with bonding of flooring to substrate.

3.02 PREPARATION

- A. Remove existing resilient flooring and flooring adhesives.
- B. Prepare floor substrates as recommended by flooring and adhesive manufacturers.
- C. Prohibit traffic until filler is fully cured.
- D. Clean substrate.

3.03 INSTALLATION - GENERAL

- A. Starting installation constitutes acceptance of subfloor conditions.
- B. Install in accordance with manufacturer's written instructions.
- C. Adhesive-Applied Installation:
 1. Spread only enough adhesive to permit installation of materials before initial set.
 2. Fit joints and butt seams tightly.
 3. Set flooring in place, press with heavy roller to attain full adhesion.

3.04 INSTALLATION - SHEET FLOORING

- A. Lay flooring with joints and seams parallel to longer room dimensions, to produce minimum number of seams. Lay out seams to avoid widths less than 1/3 of roll width; match patterns at seams.

3.05 INSTALLATION - RESILIENT BASE

- A. Fit joints tightly and make vertical. Maintain minimum dimension of 18 inches between joints.
- B. Install base on solid backing. Bond tightly to wall and floor surfaces.

3.06 CLEANING

- A. Remove excess adhesive from floor, base, and wall surfaces without damage.
- B. Clean in accordance with manufacturer's written instructions.

3.07 PROTECTION

- A. Prohibit traffic on resilient flooring for 48 hours after installation.

END OF SECTION 09 6500

EAGLES ELEMENTARY SCHOOL SITE IMPROVEMENTS

3502 SOUTH UNIVERSITY DRIVE
FARGO, NORTH DAKOTA 58104

OWNER'S REPRESENTATIVE
ICON ARCHITECTURAL GROUP
ALYSSA OMMEN, PROJECT ARCHITECT
3187 BLUESTEM DRIVE, SUITE 2
WEST FARGO, ND 58078
PH: 701-364-4007
EMAIL: alyssa.ommen@iconarchitects.com

CIVIL ENGINEER
LOWRY ENGINEERING
DREW MESSMER, P.E.
5306 51ST AVENUE SOUTH, SUITE A
FARGO, ND 58104
PH: 701-235-0199
EMAIL: dmessmer@lowryeng.com



4000 GARDEN VIEW DRIVE, SUITE 101
GRAND FORKS, ND 58201
P: 701.772.4266 | F: 701.772.4275
WWW.ICONARCHITECTS.COM



FARGO PUBLIC SCHOOLS

**EAGLES ELEMENTARY
3502 S UNIVERSITY DR
FARGO, ND 58104**

CIVIL
LOWRY ENGINEERING
5306 51ST AVE S STE A
FARGO, ND 58104
(701) 235.0199 OFFICE


SITE INFORMATION	
SURVEY INFORMATION	
DATE OF SURVEY	NOVEMBER 26, 2024
COORDINATE SYSTEM	CITY OF FARGO
DRAWING UNITS	US SURVEY FEET
VERTICAL DATUM	NAVD 88

BENCHMARK #1:
THE TOP NUT OF EX. HYDRANT NORTH OF THE PLAYGROUND IMPROVEMENTS AND ON THE SOUTH SIDE OF 35TH AVENUE SOUTH ROW.
ELEV.=906.00 (NAVD88)


BENCHMARK #2:
THE TOP NUT OF EX. HYDRANT NORTHWEST OF THE PLAYGROUND IMPROVEMENTS AND ON THE SOUTH SIDE OF 35TH AVENUE SOUTH ROW.
ELEV.=905.59 (NAVD88)

BASIS OF BEARING: CITY OF FARGO COORDINATE SYSTEM (NAD83)


VICINITY MAP

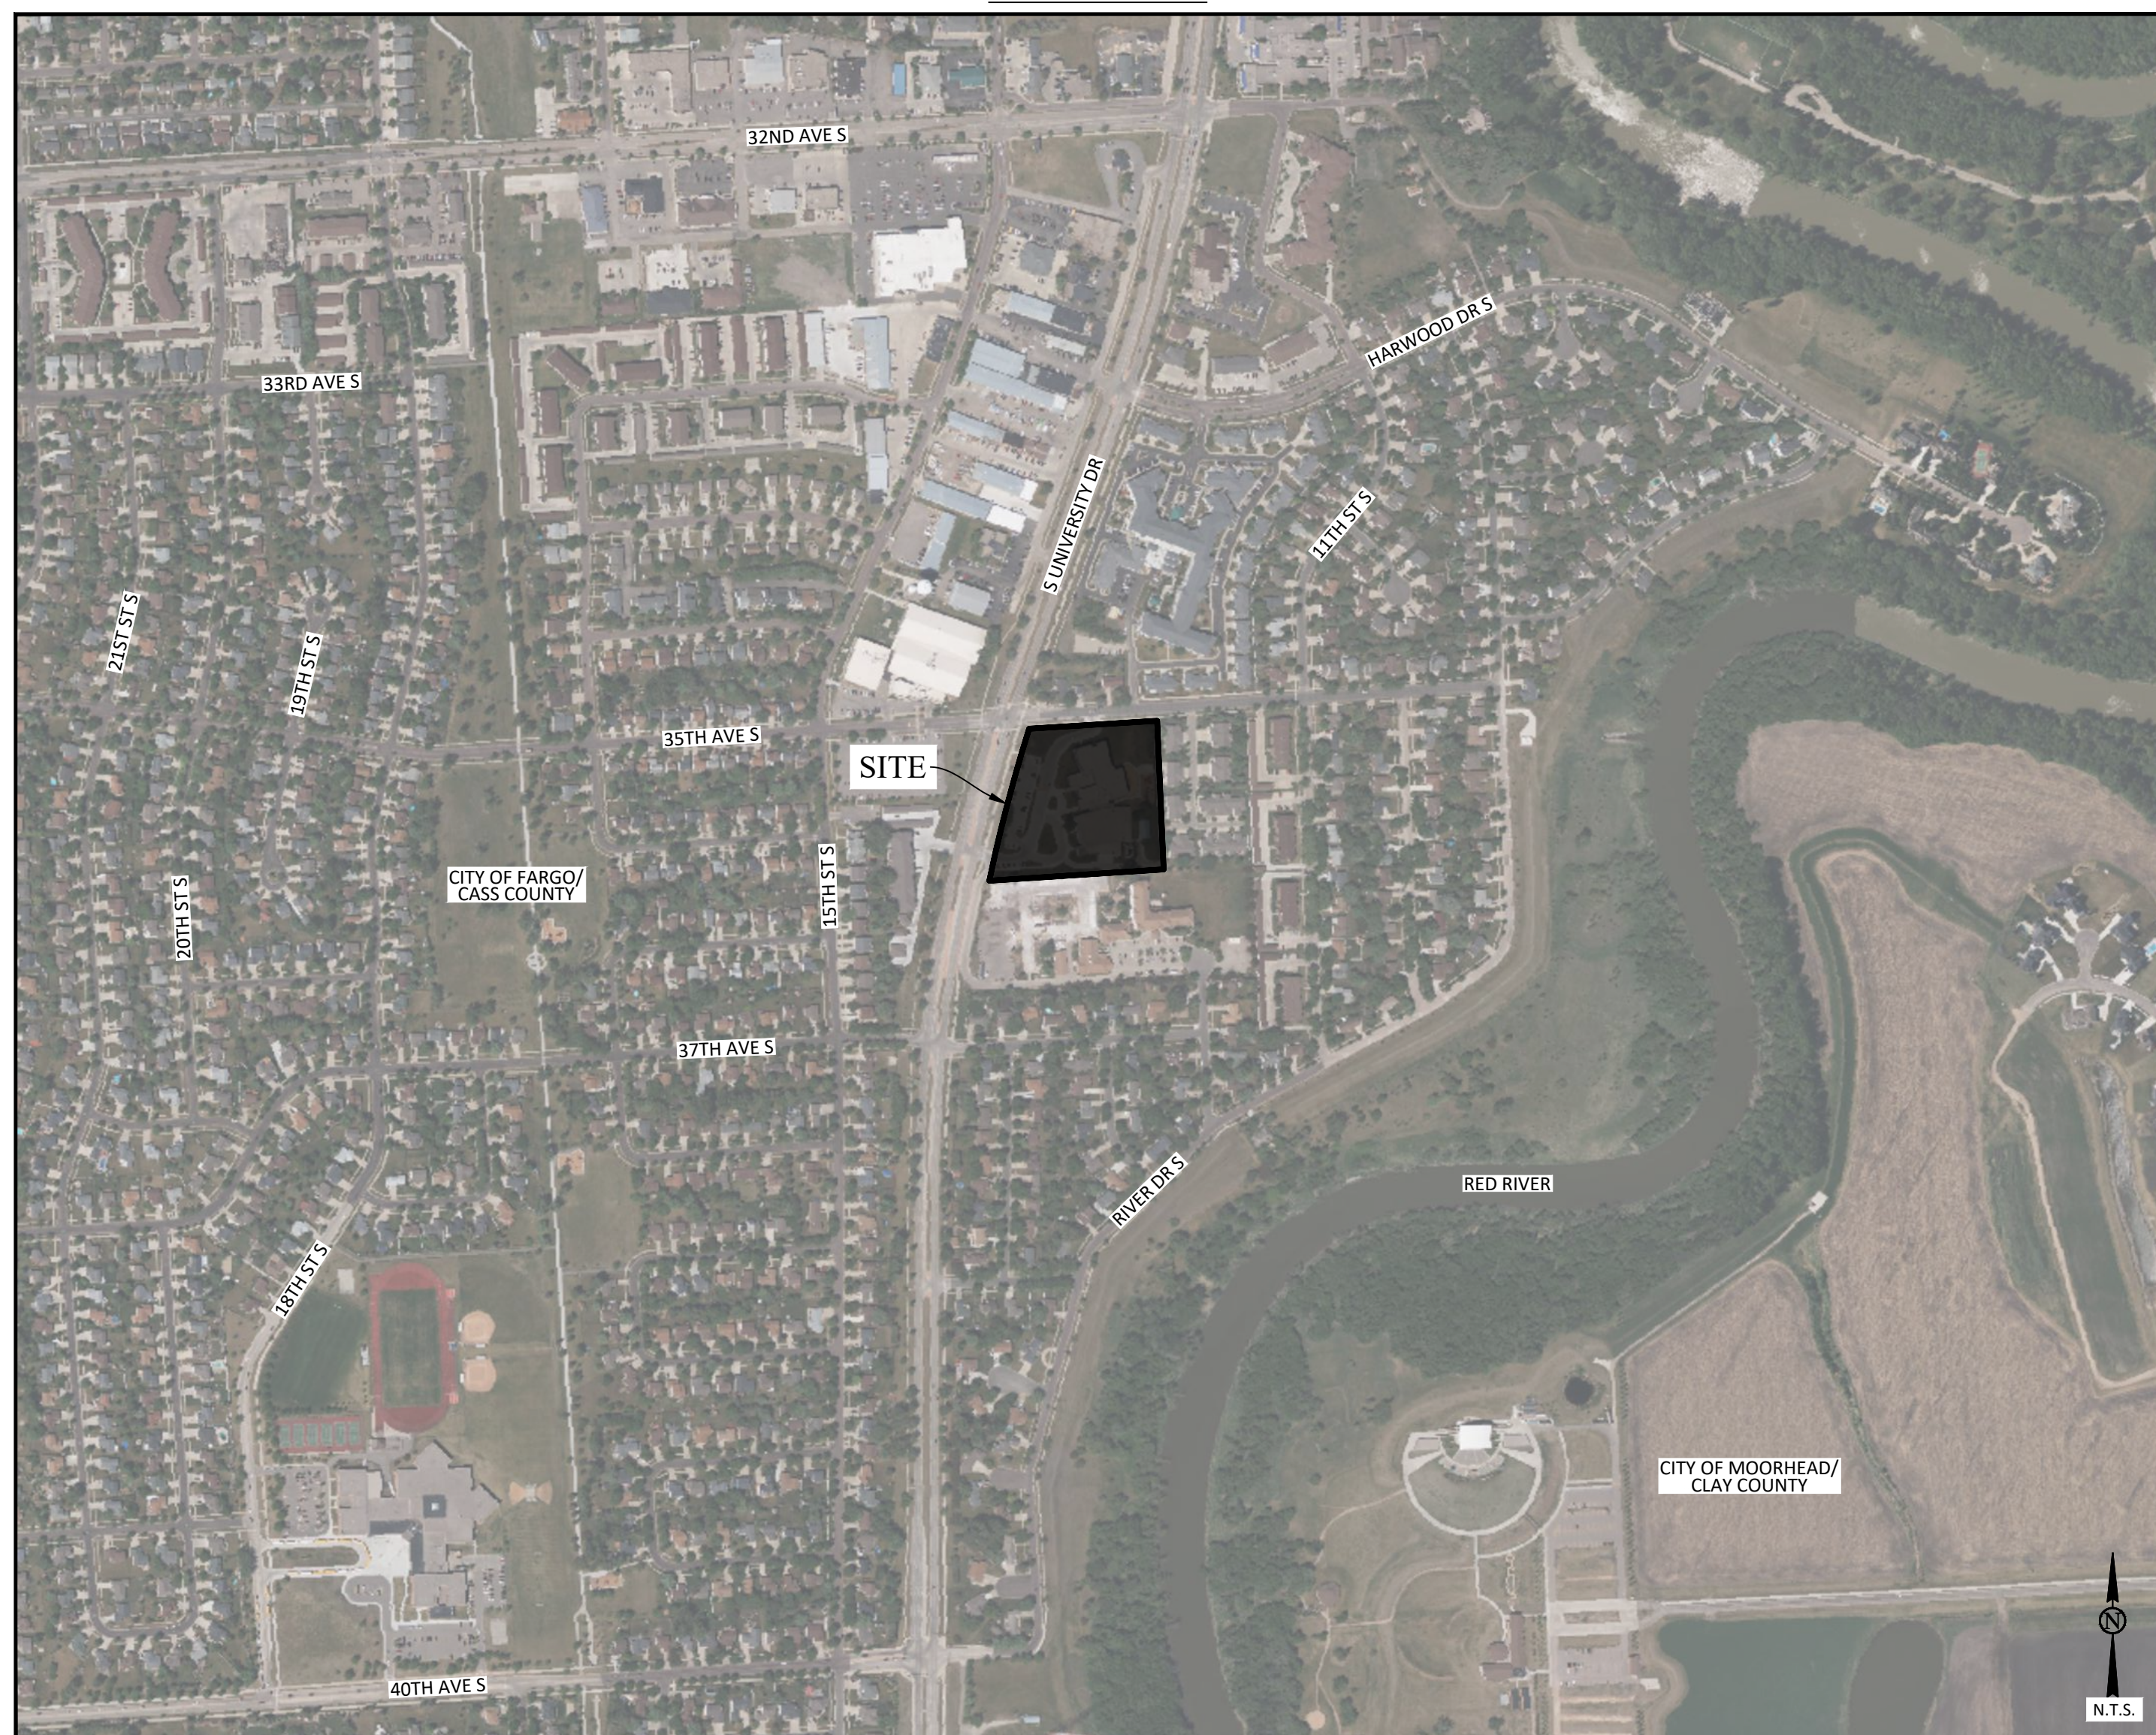

SHEET INDEX	
E-C1	COVER SHEET
E-C2	GENERAL NOTES & LEGEND
E-C3	SURVEY OVERLAY & DEMOLITION PLAN
E-C4	OVERALL SITE PLAN
E-C5	GRADING & UTILITY PLAN
E-C6	EROSION & SEDIMENT CONTROL PLAN
E-C7	DETAILS
E-C8	DETAILS

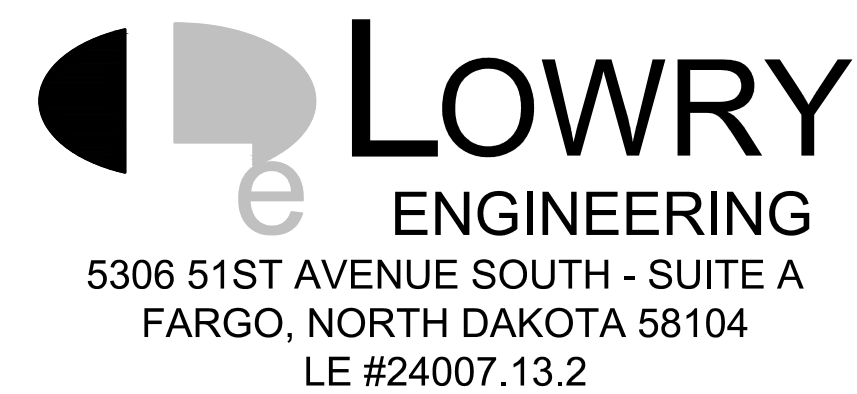

CALL BEFORE YOU DIG
NORTH DAKOTA
UTILITIES UNDERGROUND LOCATION SERVICE
1-800-795-0555

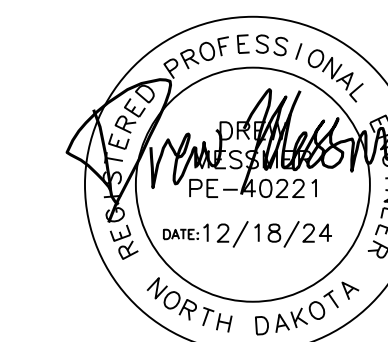

DRAWING HISTORY


NO.	DESCRIPTION	DATE
1	ADDENDUM #1	12/30/24

DRAWN BY: JT / KD JN: 24-060


**COVER SHEET
EAGLES**

SHEET

E-C1

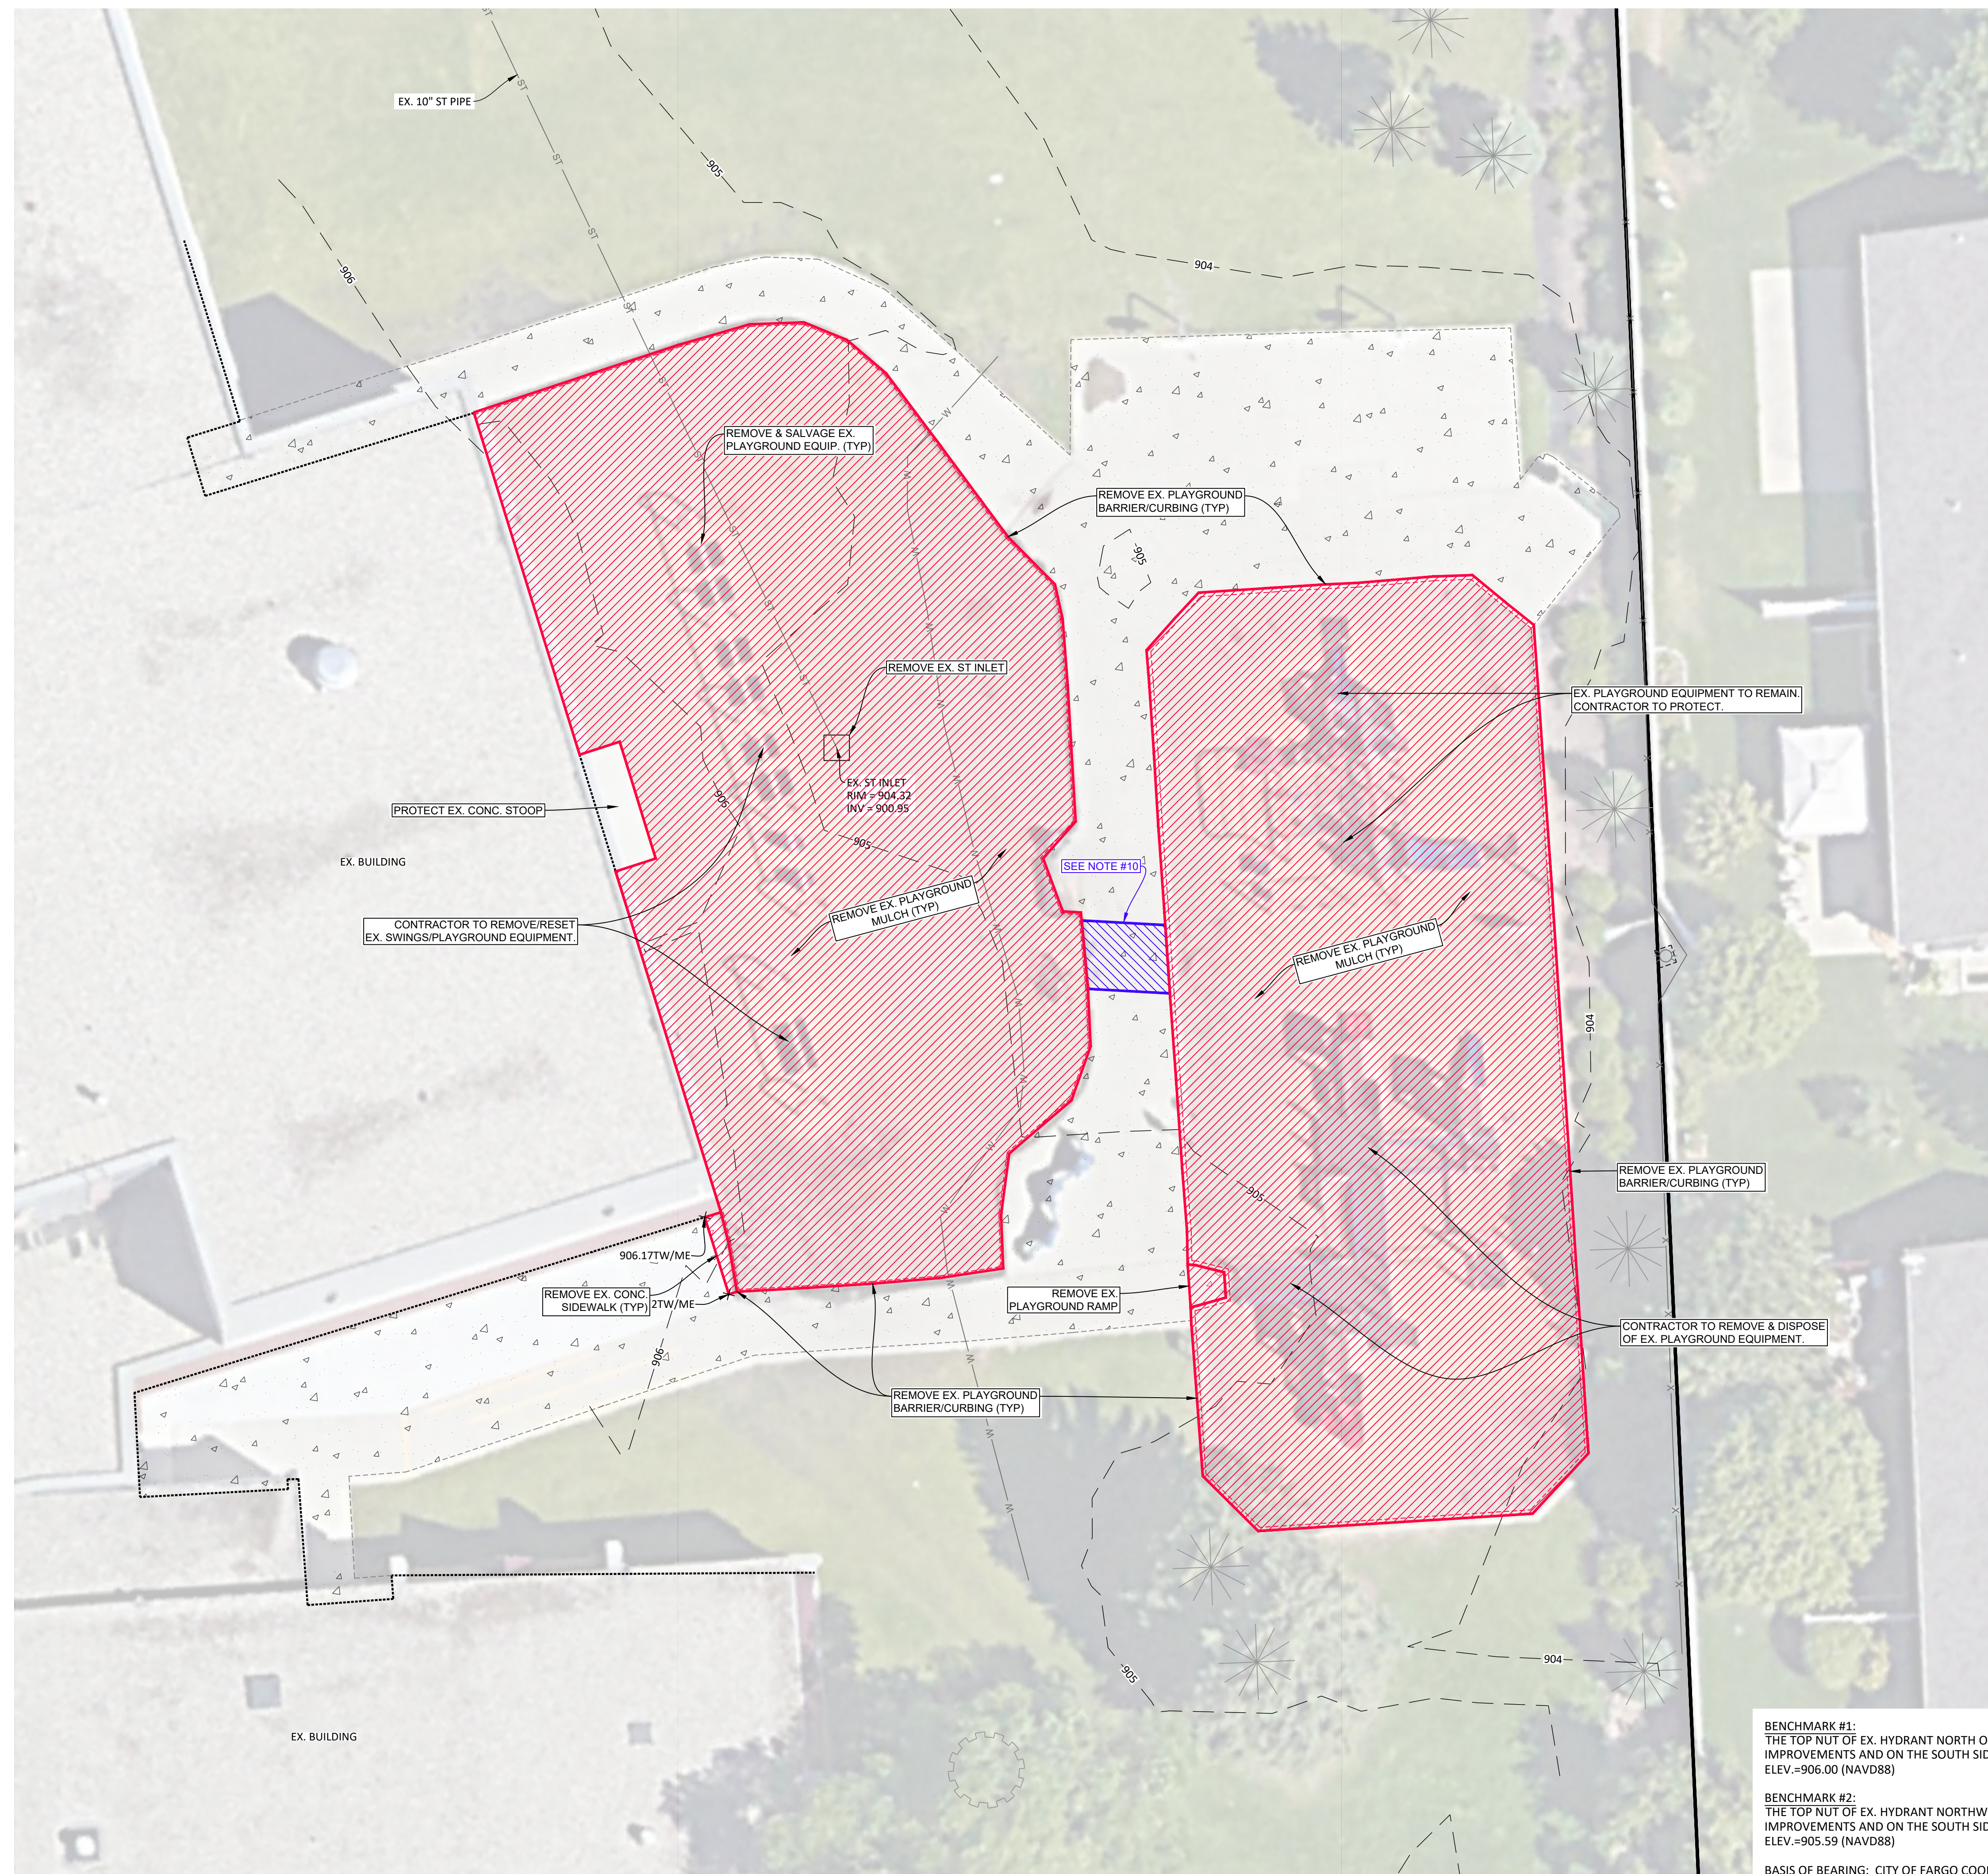

ALTERNATE #1 - DEMOLITION CALLOUTS		
ITEM	QUANTITY	UNIT
REMOVE EX. PLAYGROUND BARRIER	520	LF
REMOVE EX. PLAYGROUND MULCH	1,160	SY
REMOVE EX. PLAYGROUND EQUIPMENT	1	LS
REMOVE EX. PLAYGROUND RAMP	1	EA
REMOVE EX. CONCRETE SIDEWALK	2	SY
REMOVE EX. STORM DRAIN INLET	1	ES

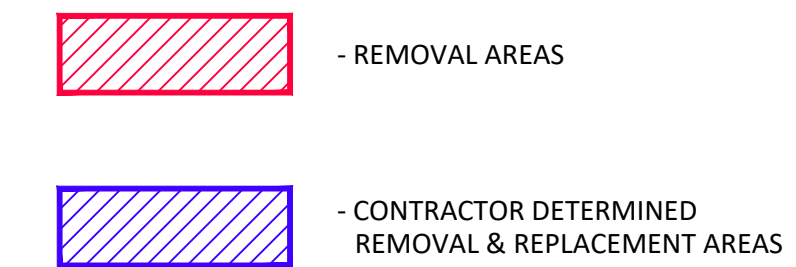


- ALTERNATE #1 NOTES:**
- IF THE ALTERNATIVE PLAYGROUND IMPROVEMENTS ARE CHOSEN FOR THE EXISTING PLAYGROUND AREAS, THE CONTRACTOR SHALL COORDINATE WITH FARGO PUBLIC SCHOOLS ON THE EXACT LOCATIONS FOR THE SALVAGED/NEW PLAYGROUND EQUIPMENT TO BE REINSTALLED.
 - QUANTITIES ARE ENGINEERS ESTIMATES ONLY. CONTRACTOR SHALL DETERMINE THEIR OWN QUANTITIES AND BID ACCORDINGLY.
 - EXISTING CONDITIONS SHOWN ARE BASED ON OBSERVATIONS AT THE TIME THE SURVEY WAS COMPLETED. THE CONTRACTOR IS ENCOURAGED TO VISIT THE SITE IN ORDER TO BID APPROPRIATELY. QUANTITIES SHOWN AS ESTIMATES.
 - DEPTH OF EXISTING DRY UTILITIES ARE UNKNOWN. CONTRACTOR SHALL COORDINATE WITH UTILITY COMPANIES FOR CROSSINGS AND IMPACTS.
 - EXISTING PAVEMENT DEPTHS ARE UNKNOWN. CONTRACTOR SHALL SAW CUT AND REMOVE EXISTING PAVEMENT AREAS IN FULL SECTIONS AND REPORT ANY DISCREPANCIES TO THE ENGINEER IMMEDIATELY TO EVALUATE OR RESOLVE THE ISSUE.
 - CONTRACTOR SHALL SAW CUT AND REPLACE ANY EXISTING PAVEMENT DAMAGED DURING CONSTRUCTION AT NO ADDITIONAL COST.
 - ANY PLATFORMS OR PLAY ELEMENTS WITHIN 2'-6" A.F.F. OF THE INTENDED FINISHED SURFACE ELEVATION SHALL BE DISMANTLED, & STORED/PROTECTED & REINSTALLED. ALL VERTICAL STRUCTURAL POLES SHALL REMAIN IN PLACE.
 - CONCRETE CONTRACTOR TO SAW CUT OR FIELD FORM DIAMONDS AT EACH EXISTING VERTICAL POLE (1'-6" X 1'-6"). THESE DIAMOND AREAS TO BE POURED SEPARATELY. CONTRACTOR TO WRAP EXPANSION JOINT MATERIAL AROUND THE POLES BEFORE POURING CONCRETE.
 - PRIOR TO CONSTRUCTION, THE CONTRACTOR SHALL DETERMINE THE EXACT AMOUNT OF EXISTING SIDEWALK PAVEMENT TO BE REMOVED AND REPLACED/PATCHED NECESSARY TO CONNECT THE PROPOSED STORM PIPE TO THE EXISTING PLAYGROUND STORM DRAIN INLET, ACCORDING TO THE CONTRACTOR'S AVAILABLE EQUIPMENT AND ABILITY TO INSTALL THE STORM PIPE PIECE. CONTRACTOR IS RESPONSIBLE FOR THEIR OWN QUANTITIES AS IT RELATES TO THE SIZE OF THE NECESSARY OPEN CUT/PATCHING NEEDED FOR THE PROPOSED STORM TIE-IN.
 - DEMOLITION QUANTITIES DO NOT INCLUDE "CONTRACTOR DETERMINED REMOVAL AREAS". CONTRACTOR SHALL REPLACE AREAS TO MATCH EXISTING CROSS SECTIONS AND MATERIALS.
 - TOPOGRAPHIC SURVEY WAS CONDUCTED BY LOWRY ENGINEERING ON NOVEMBER 26, 2024.
 - TOPOGRAPHIC SURVEY WAS COMPLETED DURING WINTER MONTHS. UTILITY LOCATES AND OTHER FEATURES THAT ARE INACCESSIBLE DUE TO WINTER CONDITIONS MAY HAVE LIMITED ACCURACY. CONTRACTOR SHALL VERIFY LOCATIONS/INVERTS PRIOR TO CONSTRUCTION.

BENCHMARK #1:
THE TOP NUT OF EX. HYDRANT NORTH OF THE PLAYGROUND IMPROVEMENTS AND ON THE SOUTH SIDE OF 35TH AVENUE SOUTH ROW. ELEV.=906.00 (NAVD88)

BENCHMARK #2:
THE TOP NUT OF EX. HYDRANT NORTHWEST OF THE PLAYGROUND IMPROVEMENTS AND ON THE SOUTH SIDE OF 35TH AVENUE SOUTH ROW. ELEV.=905.59 (NAVD88)

BASIS OF BEARING: CITY OF FARGO COORDINATE SYSTEM (NAD83)

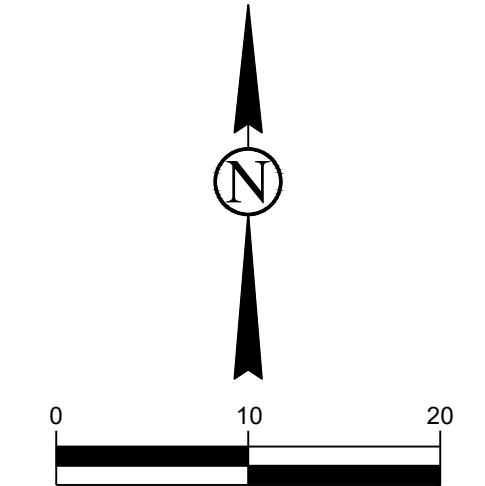


CALL BEFORE YOU DIG
NORTH DAKOTA
UTILITIES UNDERGROUND LOCATION SERVICE
1-800-795-0555



FARGO PUBLIC SCHOOLS
EAGLES ELEMENTARY
3502 S UNIVERSITY DR
FARGO, ND 58104

CIVIL
LOWRY ENGINEERING
5306 51ST AVE S STE A
FARGO, ND 58104
(701) 235.0199 OFFICE

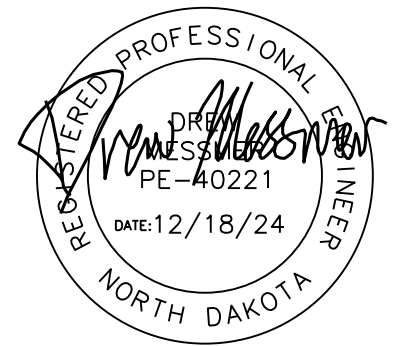

DRAWING HISTORY

NO.	DESCRIPTION	DATE
1	ADDENDUM #1	12/30/24

DRAWN BY: JT / KD JN: 24-060



ESTIMATED SITE QUANTITIES*		
ITEM	QUANTITY	UNIT
THICKENED EDGE SIDEWALK	110	LF
CONCRETE SIDEWALK - FLATWORK 4"	80	SY
SAFETY HAND RAILINGS	130	LF


* ALL BLACK DIRT/SEEDING/GRADING ADJACENT TO NEW CURBING AND PAVEMENT AREAS, FOR PIPE INSTALLATION AND ANY GRADING AS DESIGNATED IN THE PLANS, ARE INCIDENTAL TO THE PROJECT. WATERING THE SEEDING UNTIL IT IS FULLY ESTABLISHED IS INCIDENTAL TO THE PROJECT.

- BASE BID NOTES:
1. QUANTITIES ARE ENGINEERS ESTIMATES ONLY. CONTRACTOR SHALL DETERMINE THEIR OWN QUANTITIES AND BID ACCORDINGLY.
 2. PRIOR TO CONSTRUCTION, CONTRACTOR SHALL COORDINATE WITH THE ENGINEER TO DETERMINE THE EXACT AMOUNT AND LOCATIONS OF THE EXISTING CURBING/SIDEWALK/PAVEMENT TO BE REMOVED AND REPLACED/PATCHED NECESSARY FOR THE PROJECT IMPROVEMENTS.

ALTERNATE #1 - ESTIMATED SITE QUANTITIES*		
ITEM	QUANTITY	UNIT
SUBGRADE PREPARATION	990	SY
NDDOT TYPE R1 GEOSYNTHETIC FABRIC	990	SY
NDDOT CLASS 5 AGGREGATE	170	CY
PLAYGROUND SURFACING	905	SY
CONCRETE PLAYGROUND PAVEMENT - FLATWORK 4"	950	SY
PLAYGROUND EQUIPMENT	1	LS
PLAYGROUND PERIMETER WALL	230	LF

* ALL BLACK DIRT/SEEDING/GRADING ADJACENT TO NEW CURBING AND PAVEMENT AREAS, FOR PIPE INSTALLATION AND ANY GRADING AS DESIGNATED IN THE PLANS, ARE INCIDENTAL TO THE PROJECT. WATERING THE SEEDING UNTIL IT IS FULLY ESTABLISHED IS INCIDENTAL TO THE PROJECT.


- ALTERNATE #1 NOTES:
1. IF THE ALTERNATIVE PLAYGROUND IMPROVEMENTS ARE CHOSEN FOR THE EXISTING PLAYGROUND AREAS, THE CONTRACTOR SHALL COORDINATE WITH FARGO PUBLIC SCHOOLS ON THE EXACT LOCATIONS FOR THE SALVAGED/NEW PLAYGROUND EQUIPMENT TO BE REINSTALLED.
 2. AGGREGATE BASE QUANTITY ASSUMES IT EXTENDS TO 1' BEYOND BACK OF CURB OR EDGE OF PAVEMENT UNLESS ADJACENT TO STRUCTURE OR EXISTING PAVEMENT SAW CUT SECTIONS.
 3. QUANTITIES ARE ENGINEERS ESTIMATES ONLY. CONTRACTOR SHALL DETERMINE THEIR OWN QUANTITIES AND BID ACCORDINGLY.
 4. AGGREGATE BASE QUANTITIES ARE BASED ON IN PLACE VOLUME.
 5. GEOTEXTILE FABRIC PANELS SHALL BE A MINIMUM OF 12' WIDE AND INSTALLED WITH A MINIMUM OVERLAP OF 18" WITH JOINTS ORIENTATED TO FOLLOW TRAFFIC MOVEMENT. GEOTEXTILE FABRIC SHALL EXTENDS TO 1' BEYOND THE BACK OF CURB OR EDGE OF PAVEMENT UNLESS ADJACENT TO STRUCTURE OR EXISTING PAVEMENT SAW CUT SECTIONS.
 6. PRIOR TO CONSTRUCTION, CONTRACTOR SHALL COORDINATE WITH THE ENGINEER TO DETERMINE THE EXACT AMOUNT AND LOCATIONS OF THE EXISTING CURBING/SIDEWALK/PAVEMENT TO BE REMOVED AND REPLACED/PATCHED NECESSARY FOR THE PROJECT IMPROVEMENTS.

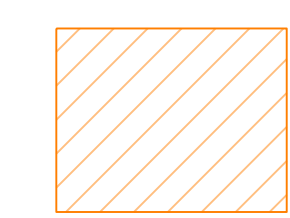 - PLAYGROUND SURFACING OVER CONCRETE FLATWORK.
 - SEE ARCH. FOR DETAILS/SPECS ON SURFACING.
 - SEE CIVIL FOR DETAILS/SPECS ON CONCRETE FLAT WORK & GRADING


BENCHMARK #1:
 THE TOP NUT OF EX. HYDRANT NORTH OF THE PLAYGROUND IMPROVEMENTS AND ON THE SOUTH SIDE OF 35TH AVENUE SOUTH ROW.
 ELEV.=906.00 (NAVD88)

BENCHMARK #2:
 THE TOP NUT OF EX. HYDRANT NORTHWEST OF THE PLAYGROUND IMPROVEMENTS AND ON THE SOUTH SIDE OF 35TH AVENUE SOUTH ROW.
 ELEV.=905.59 (NAVD88)

BASIS OF BEARING: CITY OF FARGO COORDINATE SYSTEM (NAD83)

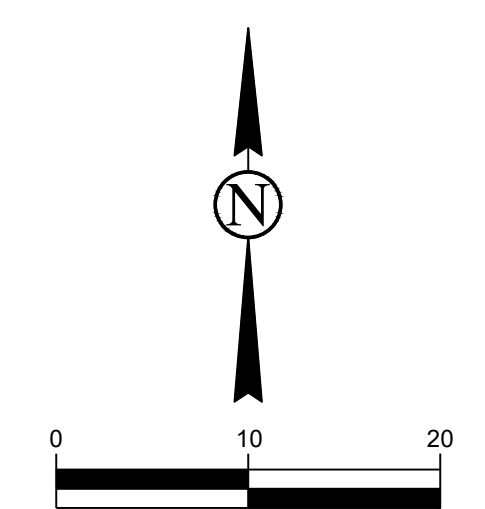


CALL BEFORE YOU DIG
NORTH DAKOTA
 UTILITIES UNDERGROUND LOCATION SERVICE
 1-800-795-0555

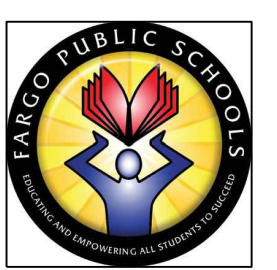

FARGO PUBLIC SCHOOLS

EAGLES ELEMENTARY
3502 S UNIVERSITY DR
FARGO, ND 58104

CIVIL
 LOWRY ENGINEERING
 5306 51ST AVE S STE A
 FARGO, ND 58104
 (701) 235.0199 OFFICE

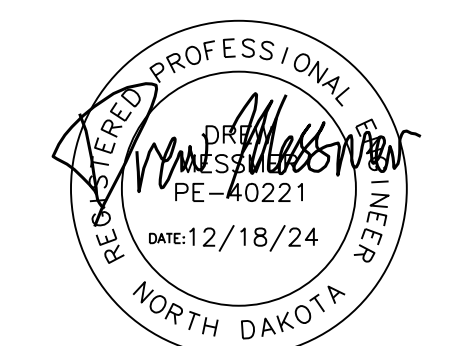


DRAWING HISTORY

NO.	DESCRIPTION	DATE
1	ADDENDUM #1	12/30/24

DRAWN BY: JT / KD JN: 24-060

OVERALL SITE PLAN
EAGLES

SHEET
E-C4

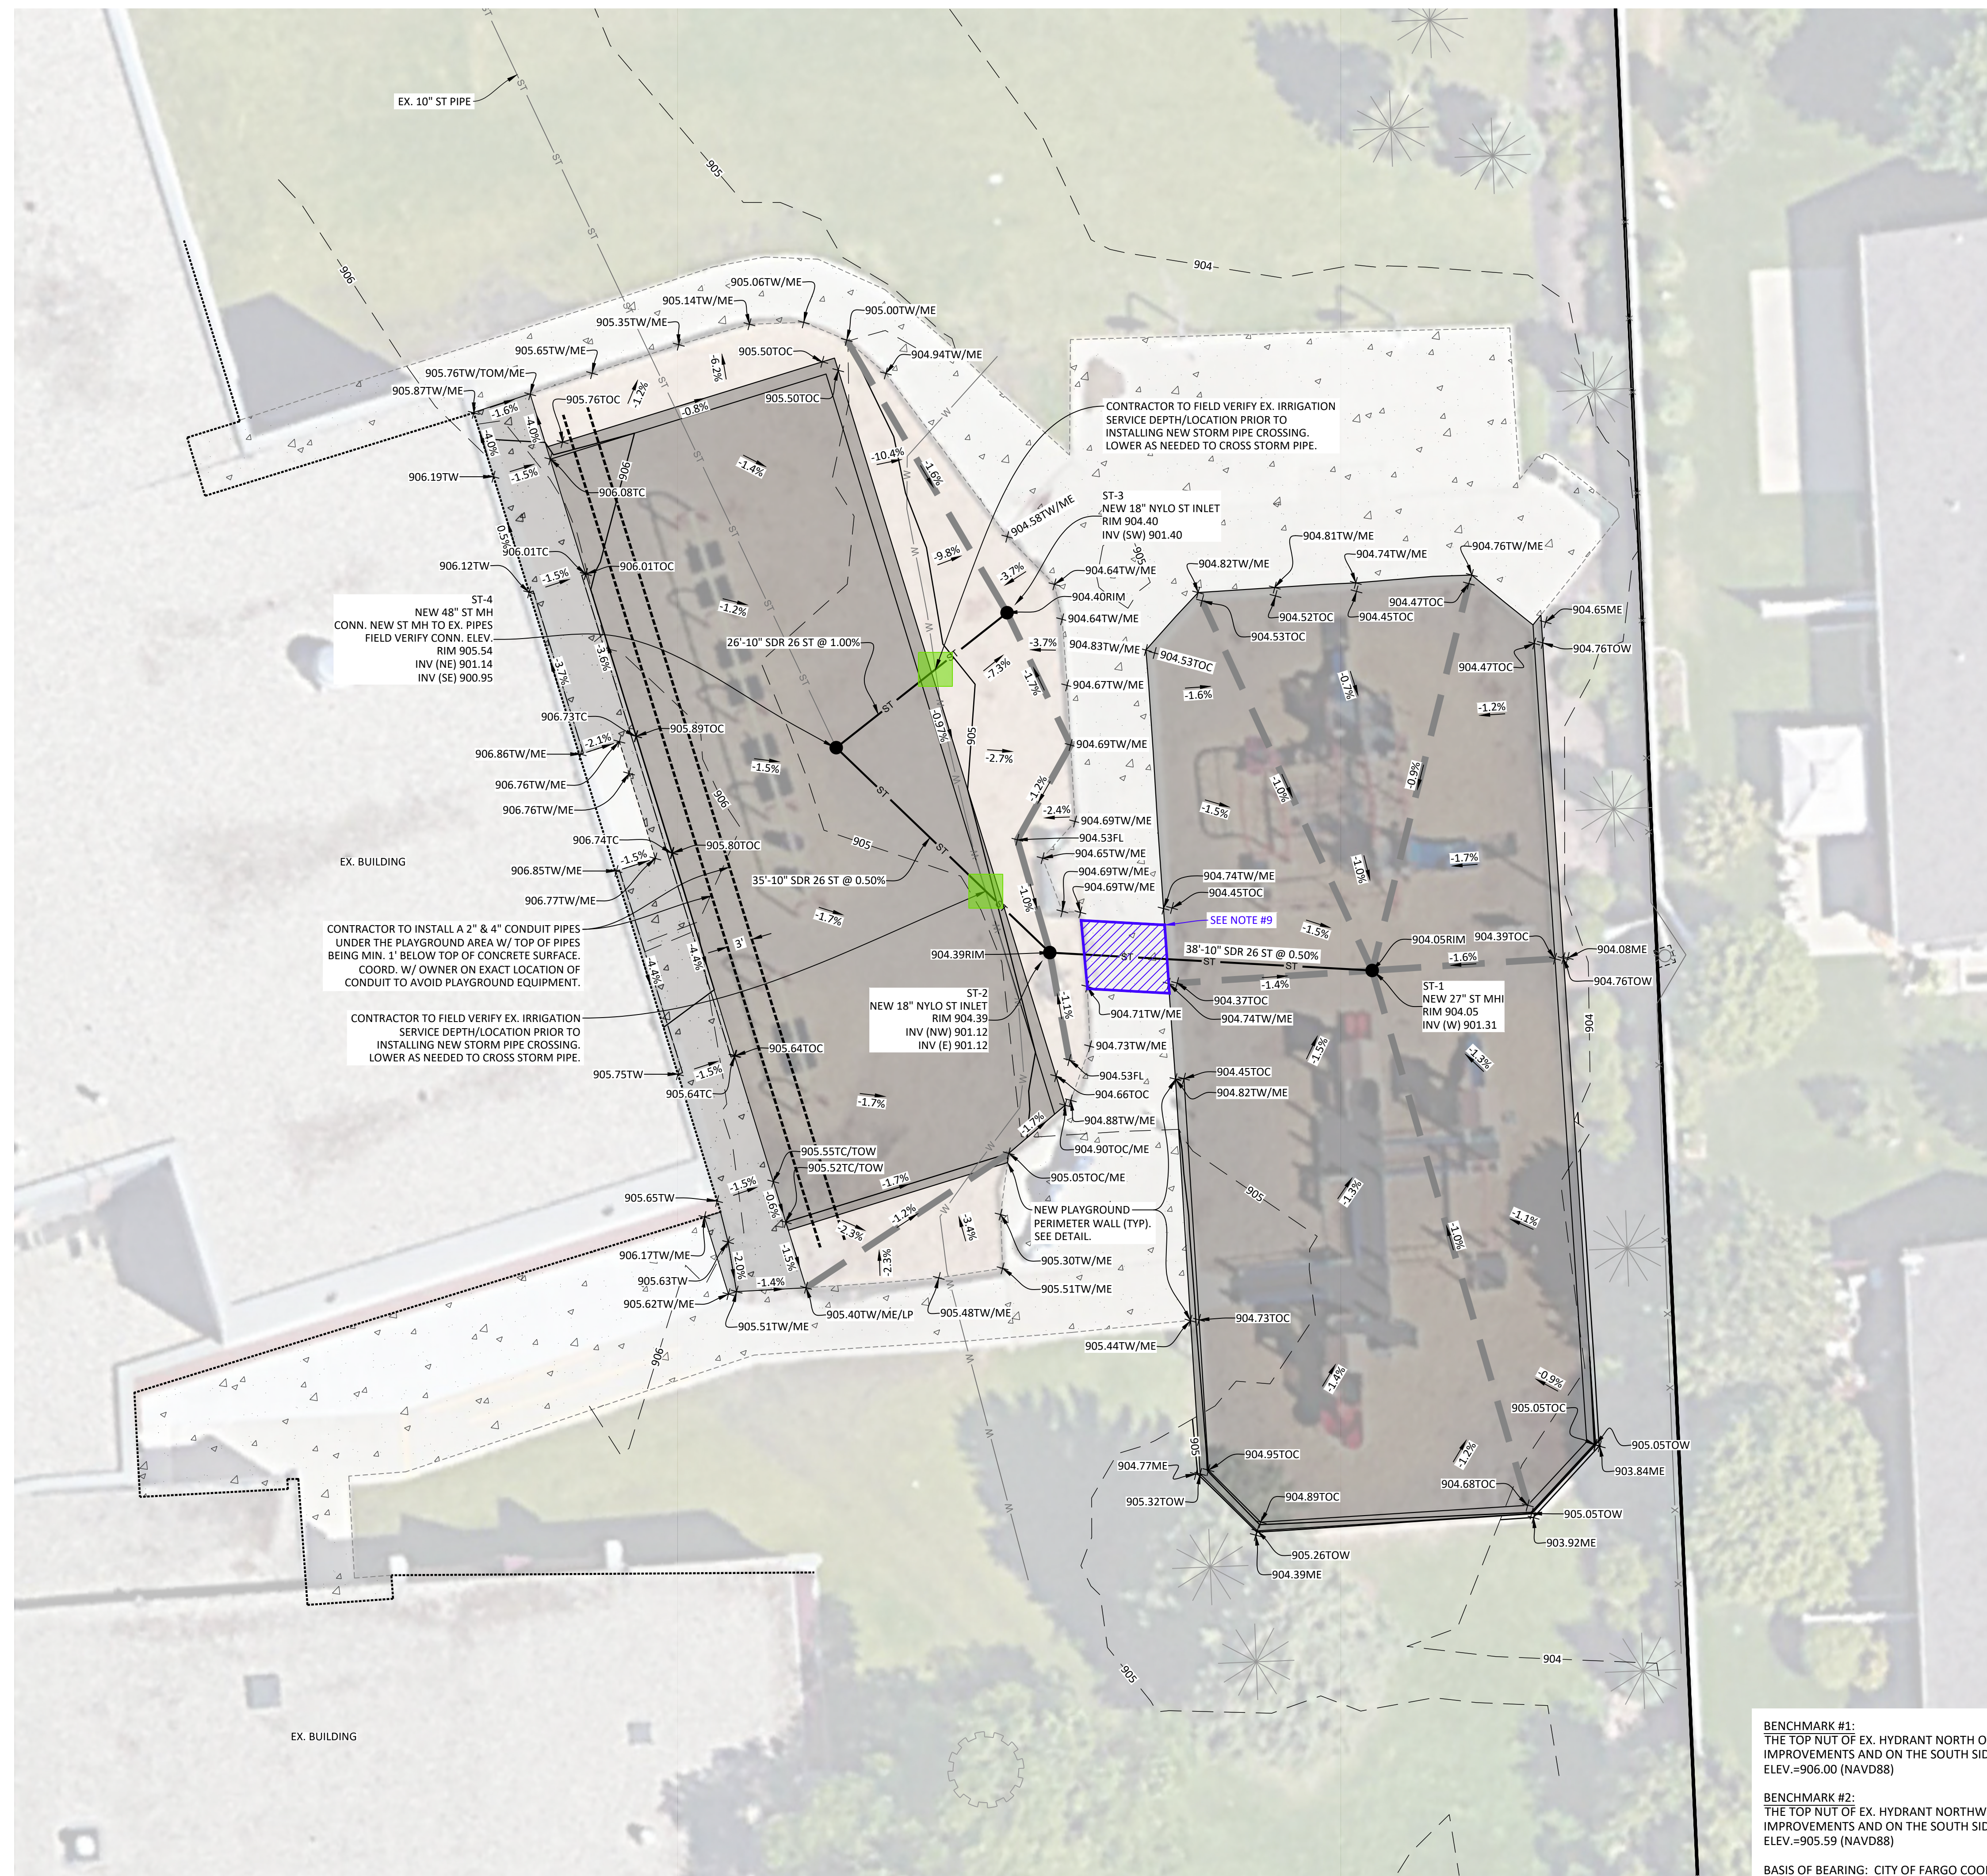

- NOTES:**
- CONTRACTOR IS RESPONSIBLE FOR CALCULATING THEIR OWN EARTHWORK/GRADING TAKEOFF QUANTITIES FOR THE PROPOSED SITE.
 - PRIOR TO CONSTRUCTION, THE CONTRACTOR IS ENCOURAGED TO VISIT THE SITE TO BETTER DETERMINE THE NECESSARY AMOUNT OF STRIPPING TO OCCUR THROUGHOUT THE SITE.
 - TOPSOIL SHALL NOT BE USED AS FILL UNDER THE PAVEMENT AREAS.
 - NEW INLET CASTING WITHIN THE PLAYGROUND AREA SHALL BE EIHW 120S TYPE M GRATE OR APPROVED EQUAL. CONTRACTOR TO INSTALL SCREEN OVER TOP OF CASTING, PER SURFACING MANUFACTURER RECOMMENDATIONS, PRIOR TO INSTALLATION OF RUBBER PLAYGROUND MAT SURFACING.
 - NEW NON-INLET CASTINGS SHALL BE EIHW 3025-Z OR NEENAH 1955-1 TYPE A COVER WITH "STORM" LABEL AND 2 OPEN PICK HOLES OR APPROVED EQUAL.
 - NEW NYLOPLAST INLET CASTINGS SHALL BE BEEHIVE STYLE GRATE.
 - IF ANY POTENTIAL UTILITY CONFLICTS OR PIPE COVER CONCERNS ARE DISCOVERED, CONTRACTOR SHALL CONTACT THE ENGINEER IMMEDIATELY TO EVALUATE OR RESOLVE THE ISSUE.
 - PRIOR TO CONSTRUCTION, THE CONTRACTOR SHALL DETERMINE THE EXACT AMOUNT OF EXISTING SIDEWALK PAVEMENT TO BE REMOVED AND REPLACED/PATCHED NECESSARY TO CONNECT THE PROPOSED STORM PIPE TO THE EXISTING PLAYGROUND STORM DRAIN INLET, ACCORDING TO THE CONTRACTOR'S AVAILABLE EQUIPMENT AND ABILITY TO INSTALL THE STORM PIPE PIECE. CONTRACTOR IS RESPONSIBLE FOR THEIR OWN QUANTITIES AS IT RELATES TO THE SIZE OF THE NECESSARY OPEN CUT/PATCHING NEEDED FOR THE PROPOSED STORM TIE-IN.
 - DEMOLITION QUANTITIES DO NOT INCLUDE "CONTRACTOR DETERMINED REMOVAL AREAS". CONTRACTOR SHALL REPLACE AREAS TO MATCH EXISTING CROSS SECTIONS AND MATERIALS.

LEGEND

- IRRIGATION PIPE CROSSING
- CONTRACTOR DETERMINED REMOVAL & REPLACEMENT AREAS
- GRADE BREAK / FLOW PATH
- FINISH GROUND
- FLOWLINE
- HIGH POINT
- LOW POINT
- MATCH EXISTING GROUND
- STRUCTURE RIM ELEVATION
- TOP OF CURB/THICKENED EDGE
- TOP OF CONCRETE
- TOP OF WALK
- TOP OF WALL

BENCHMARK #1:
THE TOP NUT OF EX. HYDRANT NORTH OF THE PLAYGROUND IMPROVEMENTS AND ON THE SOUTH SIDE OF 35TH AVENUE SOUTH ROW. ELEV.=906.00 (NAVD88)

BENCHMARK #2:
THE TOP NUT OF EX. HYDRANT NORTHWEST OF THE PLAYGROUND IMPROVEMENTS AND ON THE SOUTH SIDE OF 35TH AVENUE SOUTH ROW. ELEV.=905.59 (NAVD88)

BASIS OF BEARING: CITY OF FARGO COORDINATE SYSTEM (NAD83)

CALL BEFORE YOU DIG
NORTH DAKOTA
UTILITIES UNDERGROUND LOCATION SERVICE
1-800-795-0555



DRAWING HISTORY

NO.	DESCRIPTION	DATE
1	ADDENDUM #1	12/30/24



EROSION CONTROL LEGEND*			
	SILT FENCE	250	LF
	SEEDING & HYDROMULCH	170	SY
	STANDARD INLET PROTECTION	4	EA
	CONCRETE WASHOUT	1	EA


* ALL BLACK DIRT/SEEDING/GRADING ADJACENT TO NEW CURBING AND PAVEMENT AREAS, FOR PIPE INSTALLATION AND ANY GRADING AS DESIGNATED IN THE PLANS, ARE INCIDENTAL TO THE PROJECT. WATERING THE SEEDING UNTIL IT IS FULLY ESTABLISHED IS INCIDENTAL TO THE PROJECT.

- NOTES:**
1. QUANTITIES ARE ENGINEERS ESTIMATES ONLY. CONTRACTOR SHALL DETERMINE THEIR OWN QUANTITIES AND BID ACCORDINGLY.
 2. CONTRACTOR SHALL FOLLOW NDDOT STORMWATER POLLUTION PREVENTION STANDARDS FOR ALL EROSION CONTROL DURING CONSTRUCTION.
 3. CONTRACTOR SHALL INSTALL PERIMETER EROSION AND SEDIMENT CONTROLS PRIOR TO ANY LAND DISTURBING ACTIVITY.
 4. CONTRACTOR SHALL INSTALL EROSION CONTROL BLANKET PER MANUFACTURER'S SPECIFICATIONS.
 5. IF CONCRETE WASHOUT WILL OCCUR ONSITE, CONTRACTOR SHALL COORDINATE LOCATION WITH OWNER AND ENGINEER.
 6. INLET PROTECTION SHALL BE BY WIMCO OR ADS PRODUCTS, ERTEC, FLEXSTORM, OR APPROVED EQUAL AND INSTALLED PER MANUFACTURERS RECOMMENDATIONS.
 7. CONTRACTOR IS RESPONSIBLE FOR SWEEPING AND CLEANING ADJACENT STREETS DURING CONSTRUCTION TO PREVENT SEDIMENT RUNOFF TO CITY STORM SYSTEM.
 8. CONTRACTOR SHALL LEAVE TEMPORARY EROSION AND SEDIMENT CONTROL MEASURES IN PLACE UNTIL ALL DISTURBED AREAS ARE PERMANENTLY STABILIZED.
 9. CONTRACTOR IS RESPONSIBLE FOR ALL INSTALLATION, MAINTENANCE, REPLACEMENT IF NECESSARY, REMOVAL, ETC OF ANY AND ALL PROTECTION MEASURES NEEDED FROM THE START OF CONSTRUCTION UNTIL FINAL PERMANENT STABILIZATION IS ACHIEVED.

BENCHMARK #1:
THE TOP NUT OF EX. HYDRANT NORTH OF THE PLAYGROUND IMPROVEMENTS AND ON THE SOUTH SIDE OF 35TH AVENUE SOUTH ROW. ELEV.=906.00 (NAVD88)

BENCHMARK #2:
THE TOP NUT OF EX. HYDRANT NORTHWEST OF THE PLAYGROUND IMPROVEMENTS AND ON THE SOUTH SIDE OF 35TH AVENUE SOUTH ROW. ELEV.=905.59 (NAVD88)

BASIS OF BEARING: CITY OF FARGO COORDINATE SYSTEM (NAD83)

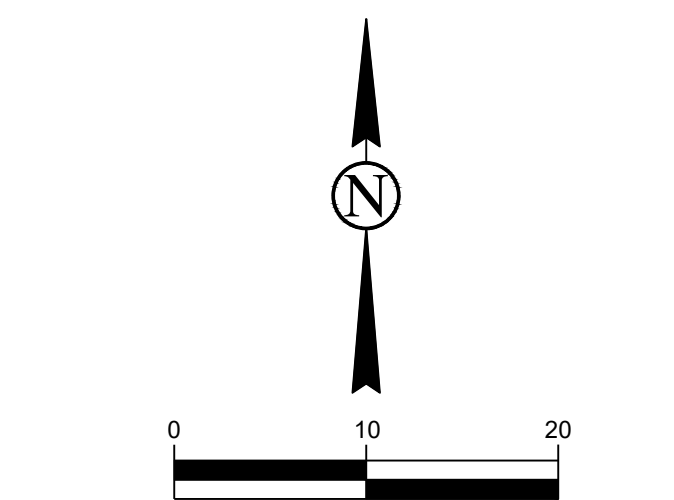


CALL BEFORE YOU DIG
NORTH DAKOTA
UTILITIES UNDERGROUND LOCATION SERVICE
1-800-795-0555



FARGO PUBLIC SCHOOLS

EAGLES ELEMENTARY
3502 S UNIVERSITY DR
FARGO, ND 58104

CIVIL
LOWRY ENGINEERING
5306 51ST AVE S STE A
FARGO, ND 58104
(701) 235.0199 OFFICE

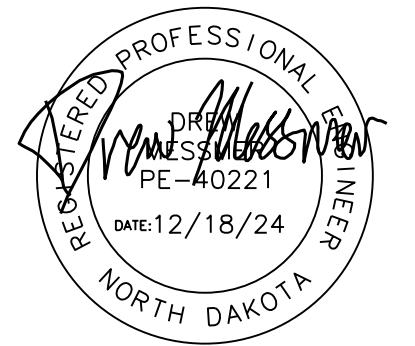

DRAWING HISTORY

NO.	DESCRIPTION	DATE
1	ADDENDUM #1	12/30/24

DRAWN BY: JT / KD JN: 24-060

EROSION & SEDIMENT CONTROL PLAN
EAGLES

SHEET


E-C6



FARGO PUBLIC SCHOOLS

EAGLES ELEMENTARY
3502 S UNIVERSITY DR
FARGO, ND 58104

CIVIL
LOWRY ENGINEERING
5306 51ST AVE S STE A
FARGO, ND 58104
(701) 235.0199 OFFICE

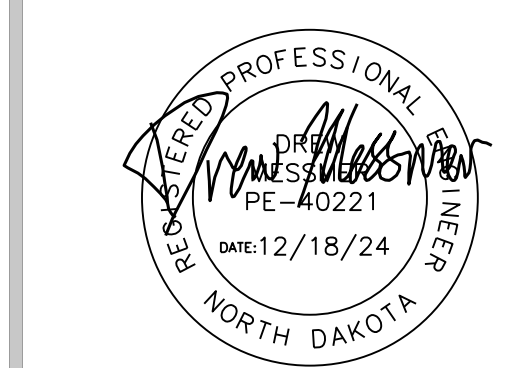

DRAWING HISTORY


NO.	DESCRIPTION	DATE
1	ADDENDUM #1	12/30/24

DRAWN BY: JT / KD JN: 24-060

**DETAILS
EAGLES**


SHEET

E-C7

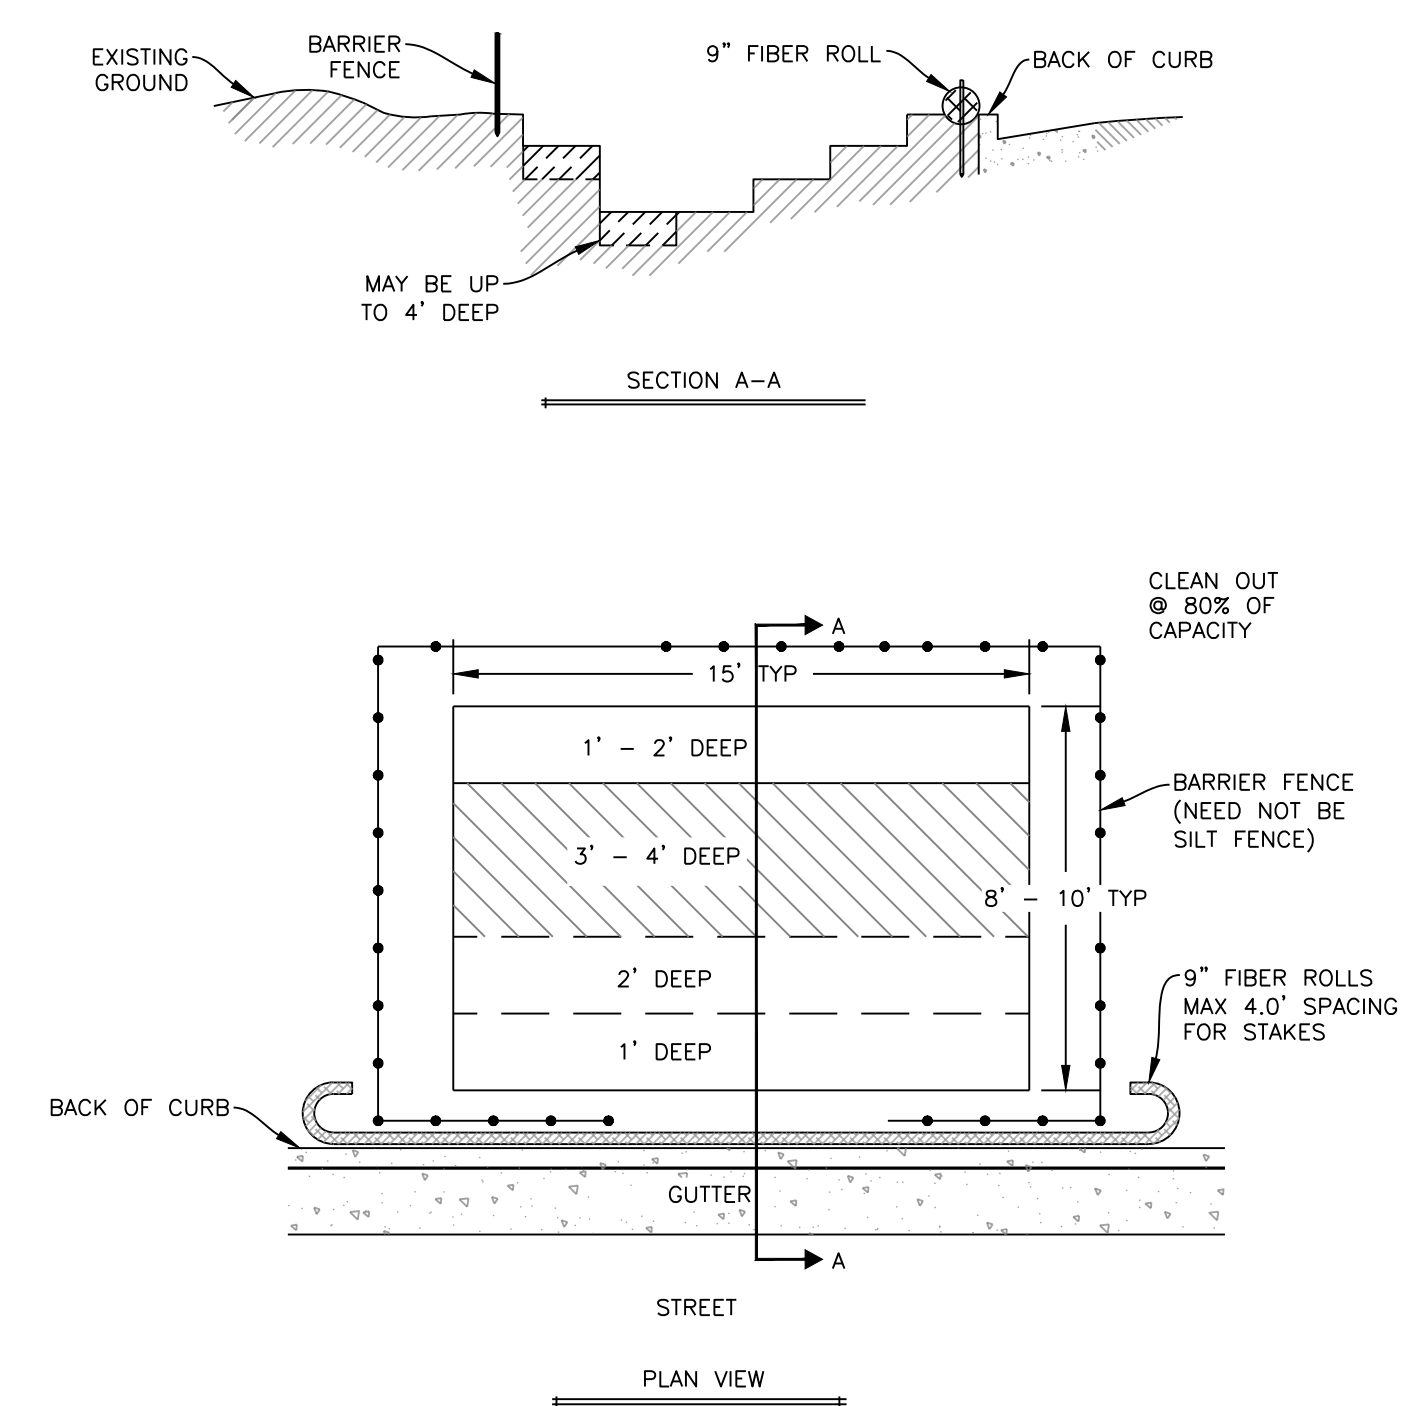


NOTE:
1. CONCRETE WASH OUT IS NOT REQUIRED IF CONTRACTOR IS PERFORMING WASHOUT ACTIVITIES OFF-SITE IN A LEGAL AND APPROPRIATE MANNER.

1 CONCRETE WASHOUT
N.T.S.

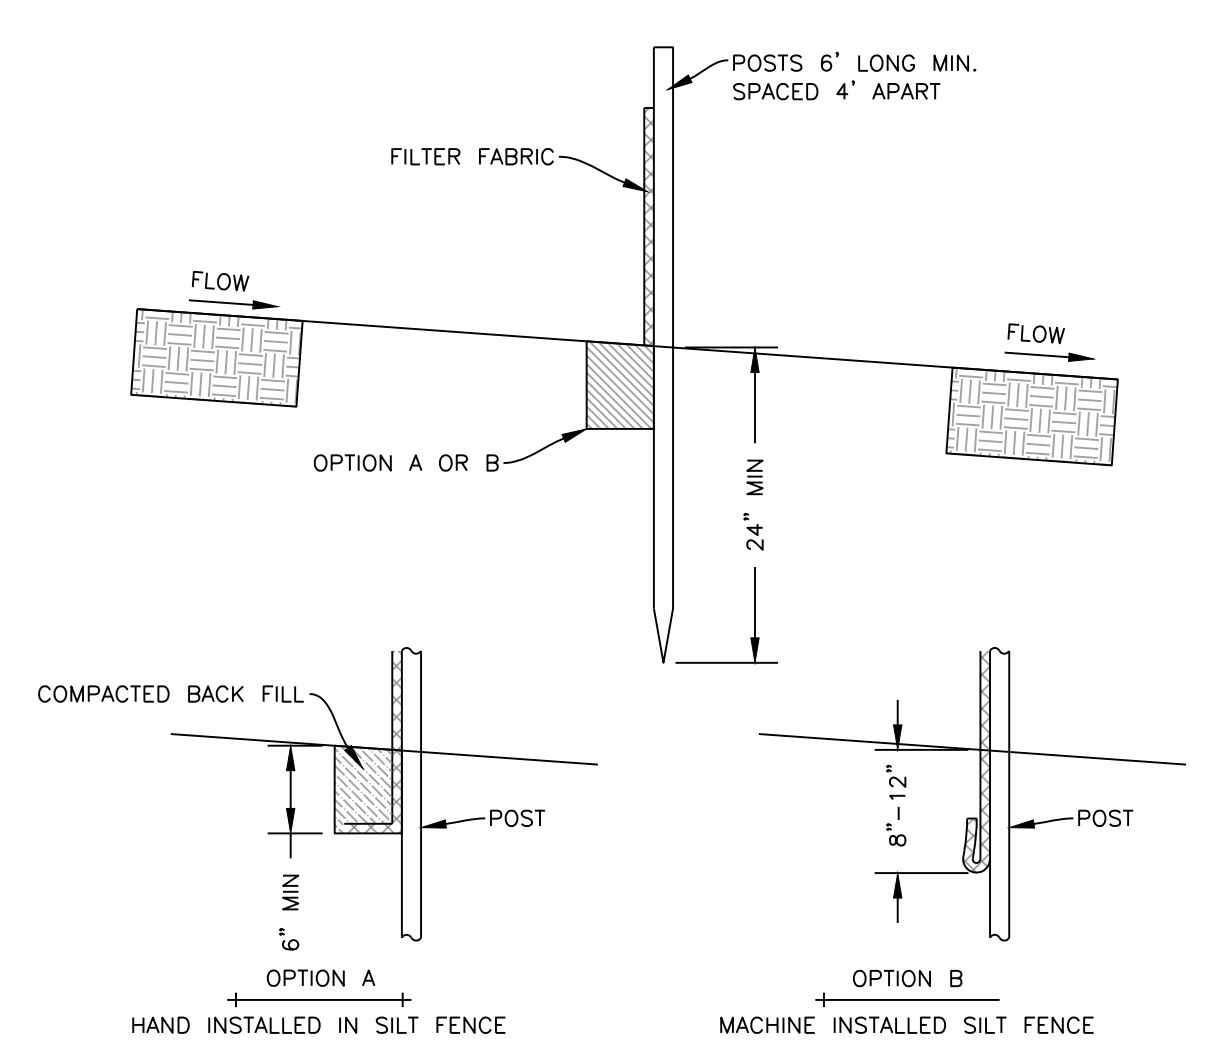


NOTES:
1. POSTS SHALL BE 2 INCH DIAMETER ROUND WOOD, 1.5 INCH RECTANGULAR WOOD, OR STEEL WITH A MINIMUM OF 0.95 POUNDS PER FOOT AND HAVE PROJECTIONS FOR FASTENING WIRE OR FABRIC.
2. FILTER FABRIC SHALL BE AS SPECIFIED IN AASHTO M 288 WITH A MINIMUM WIDTH OF 36 INCHES.
3. SILT FENCE SHALL BE INSTALLED ALONG THE CONTOURS OF THE SITE SO WATER CANNOT FLOW AROUND THE END OF THE FENCE.
4. IF JOINING TWO SECTION OF FILTER FABRIC, OVERLAP AT SUPPORT POSTS A MINIMUM OF 18 INCHES IN SUCH A MANNER THAT PREVENTS SILT FROM PASSING THROUGH THE FENCE.
5. REMOVE SEDIMENT FROM SILT FENCE WHEN IT REACHES 1/3 OF THE EXPOSED HEIGHT OF ANY SECTION, OR AS DIRECTED BY THE ENGINEER. THE ENGINEER MAY DIRECT THE INSTALLATION OF ADDITIONAL SILT FENCE IF REMOVING THE SEDIMENT DEPOSIT IS NOT FEASIBLE.
6. SILT FENCE SHALL BE INSPECTED EVERY 14 CALENDAR DAYS AND WITHIN 24 HOURS OF ANY STORM EVENT GREATER THAN 1/4" OF RAIN PER 24 HOUR PERIOD.

2 SILT FENCE INSTALLATION
N.T.S.

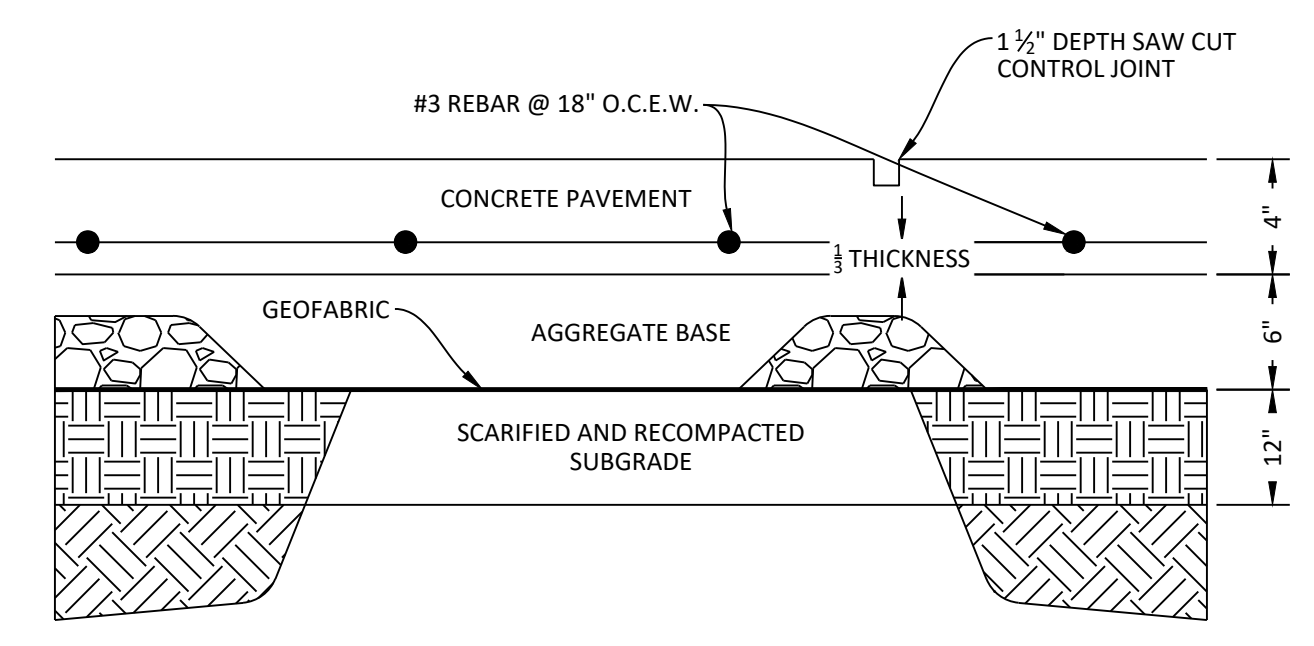


NOTES:
1. PROVIDE SAWCUT CONTROL JOINTS AT 8' MAXIMUM SPACING EACH WAY.
2. PROVIDE #3 REBAR @ 18" O.C. AT CONNECTION TO CURB & GUTTER, THICKENED EDGE SIDEWALK, EXISTING CONCRETE, AND CONSTRUCTION JOINTS.
3. PROVIDE 1/2" EXPANSION MATERIAL ADJACENT TO BUILDINGS AND ANY OTHER FIXED OBJECTS SUCH AS LIGHT POLE BASES, SIGN FOUNDATIONS, ETC. AND AT CONNECTIONS TO EXISTING CONCRETE.
4. NDDOT TYPE R1 FABRIC SHALL BE PLACED UNDER AGGREGATE BASE PER NDDOT SPECIFICATIONS.
5. REBAR SHALL BE SUPPORTED BY CHAIRS.
6. NO CONCRETE CURING COMPOUND SHALL BE APPLIED ON THE EXTERIOR PLAYGROUND CONCRETE SURFACES.



3 PLAYGROUND SURFACE PAD REINFORCED CONCRETE CROSS SECTION
N.T.S.

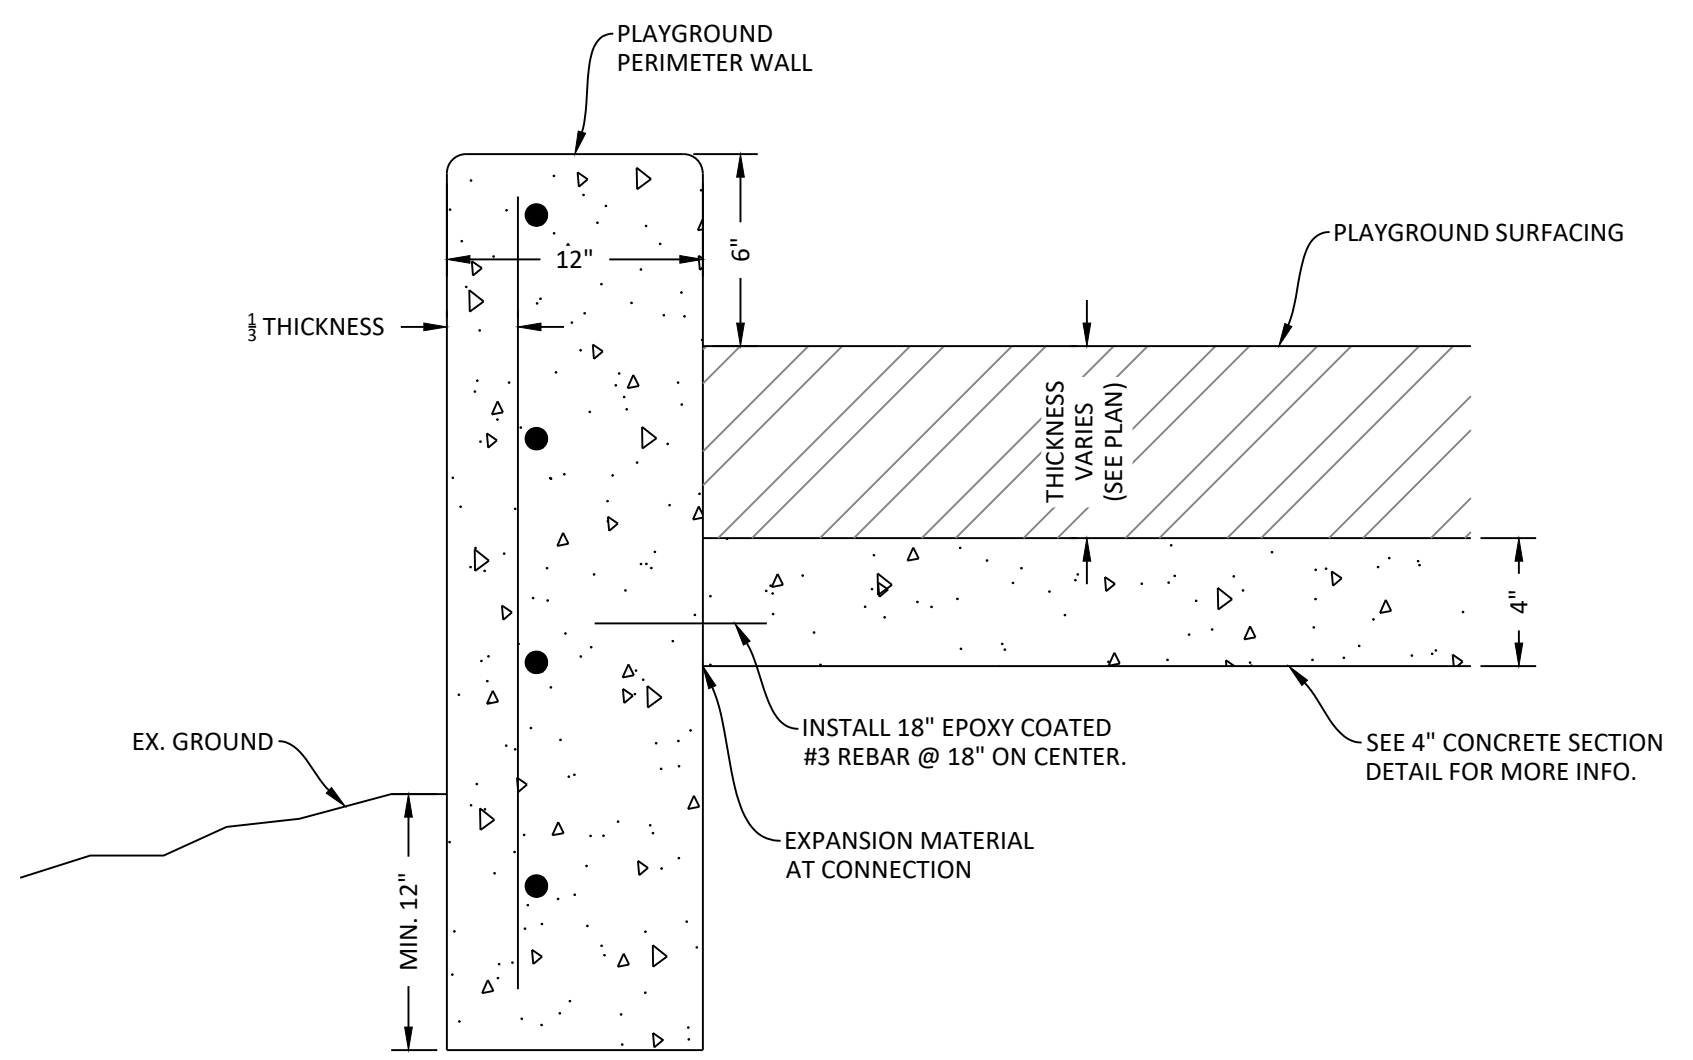

4 PLAYGROUND SURFACE PERIMETER WALL DETAIL (ALT-1 BID AREAS)
N.T.S.

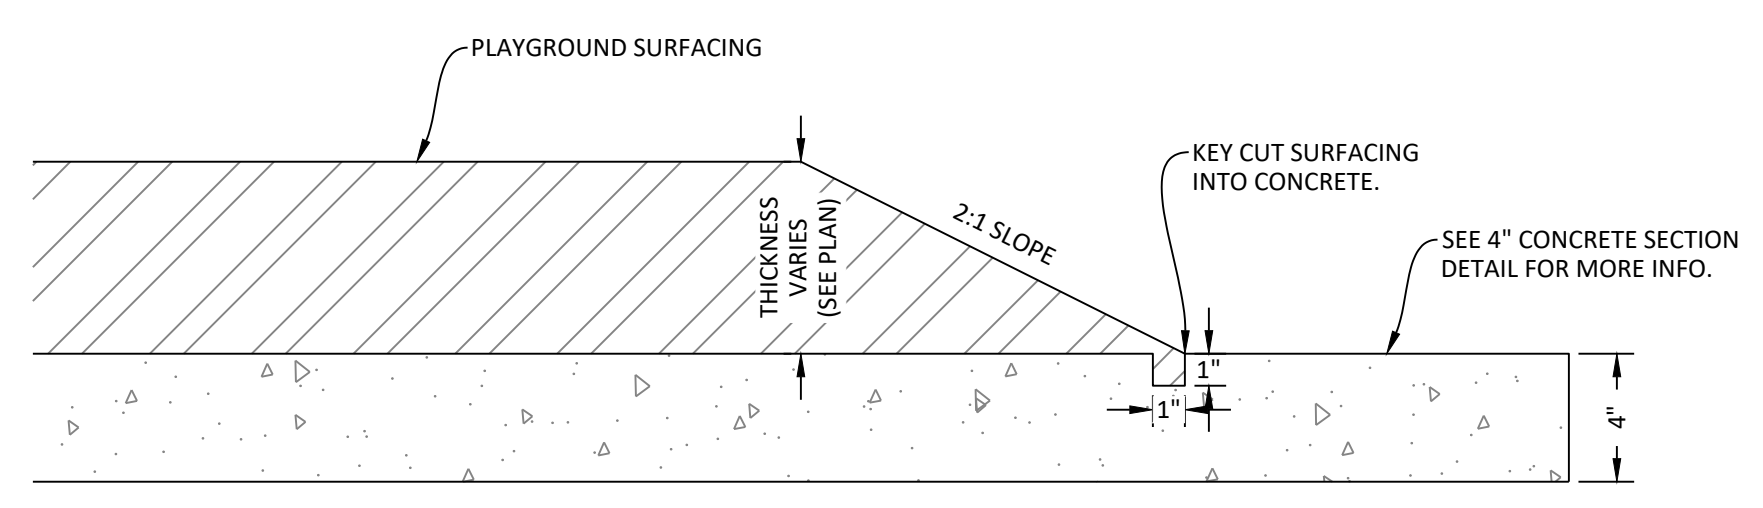

5 PLAYGROUND SURFACE PERIMETER DETAIL (ALT-1 AREAS)
N.T.S.

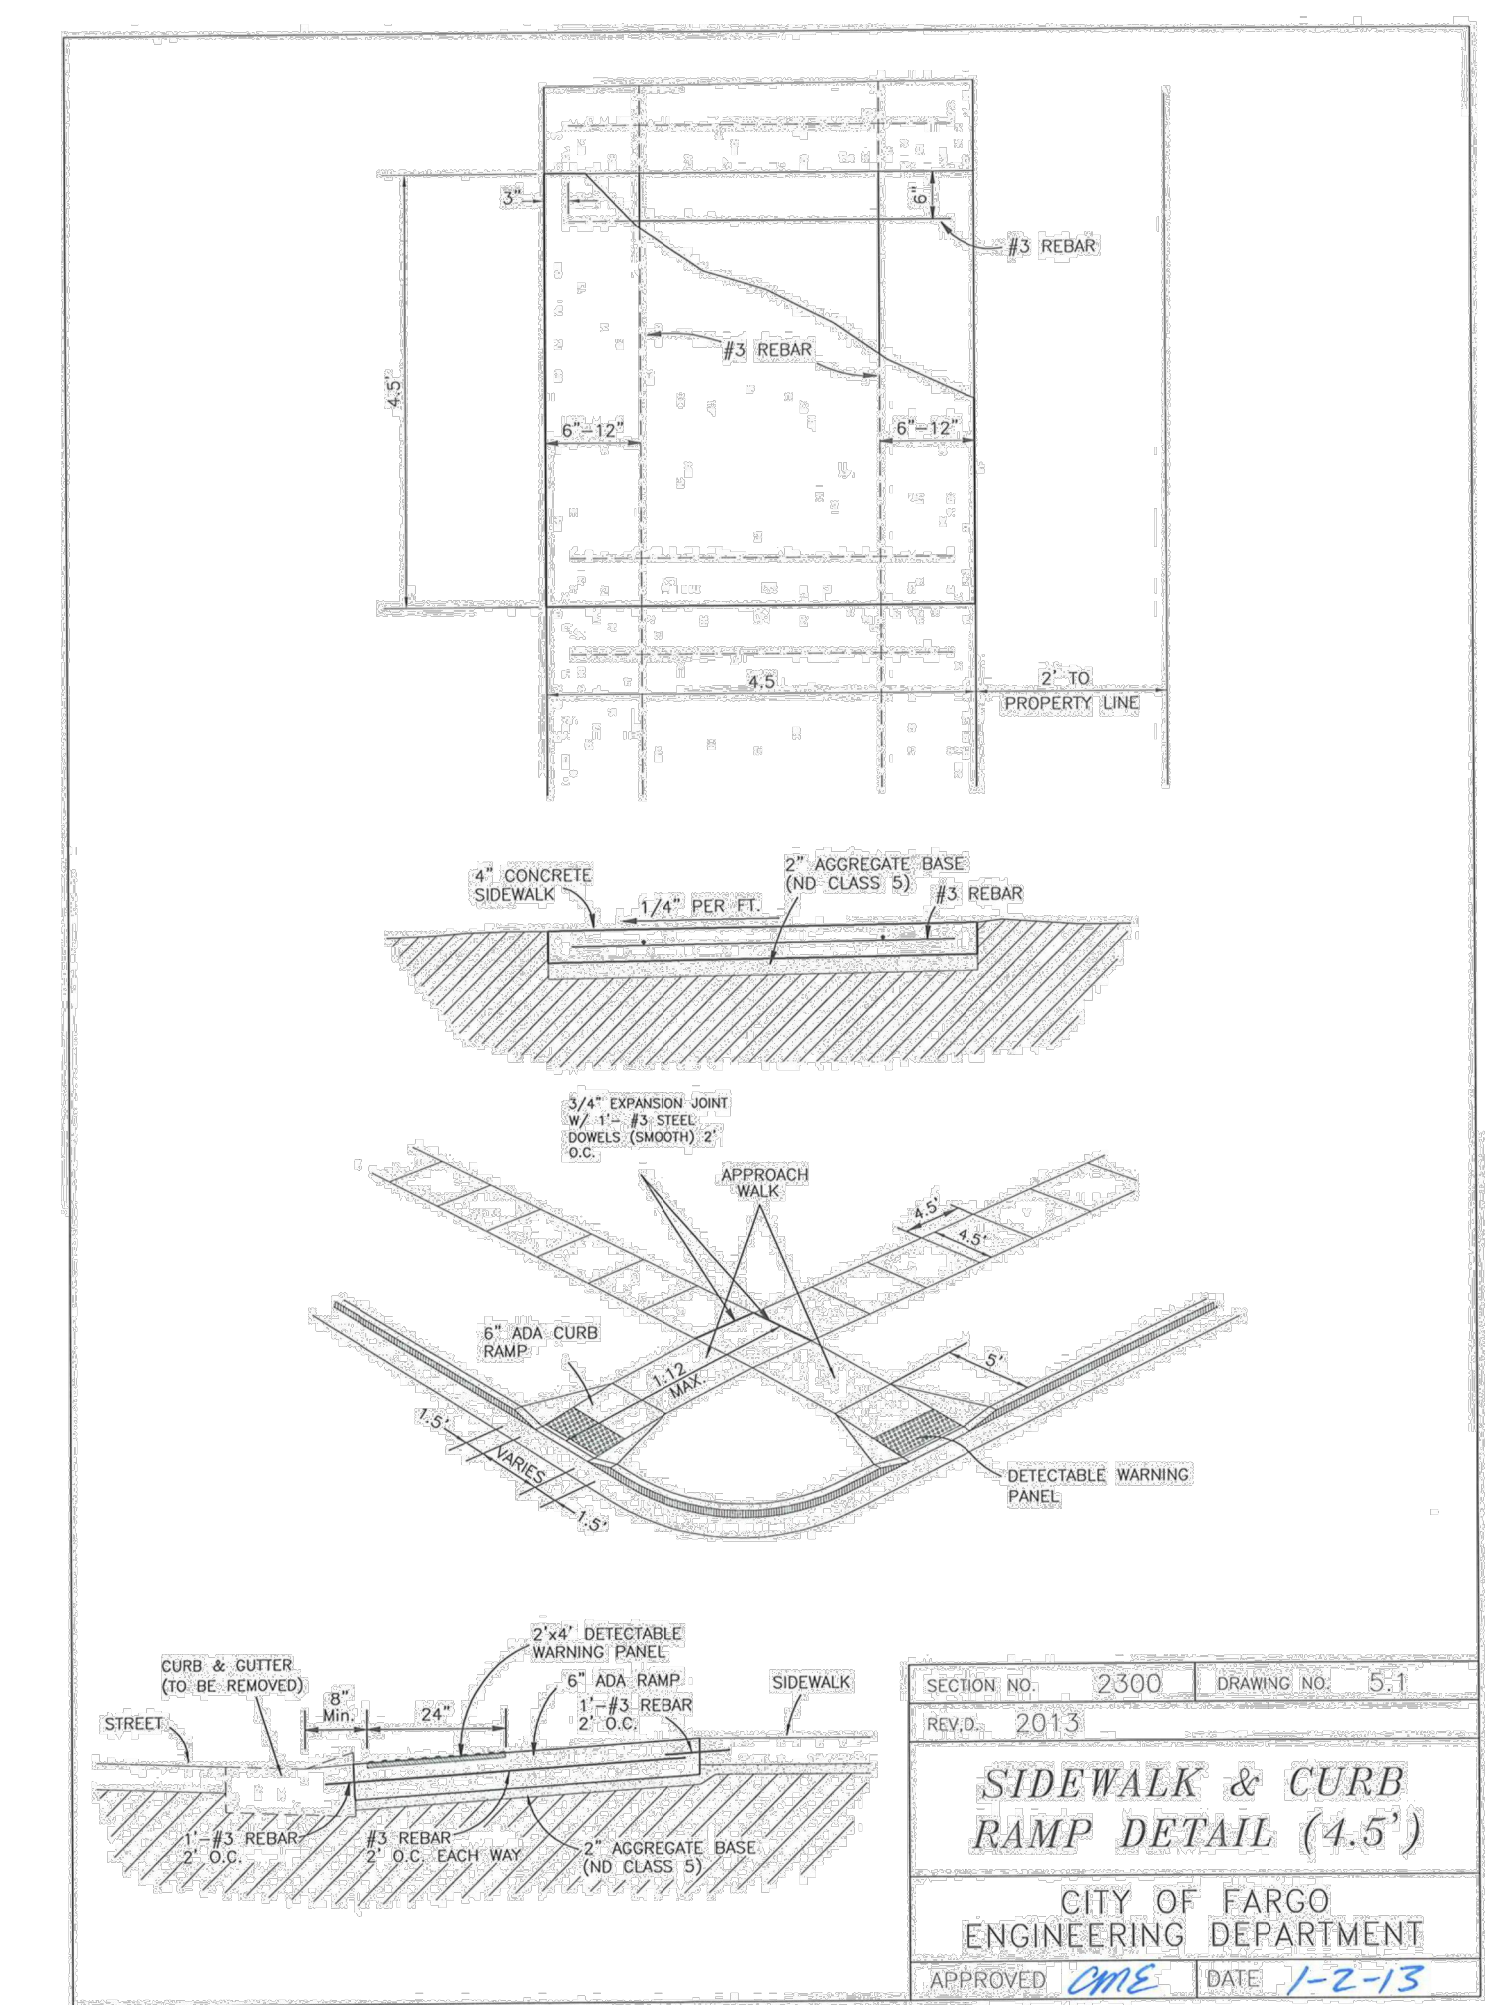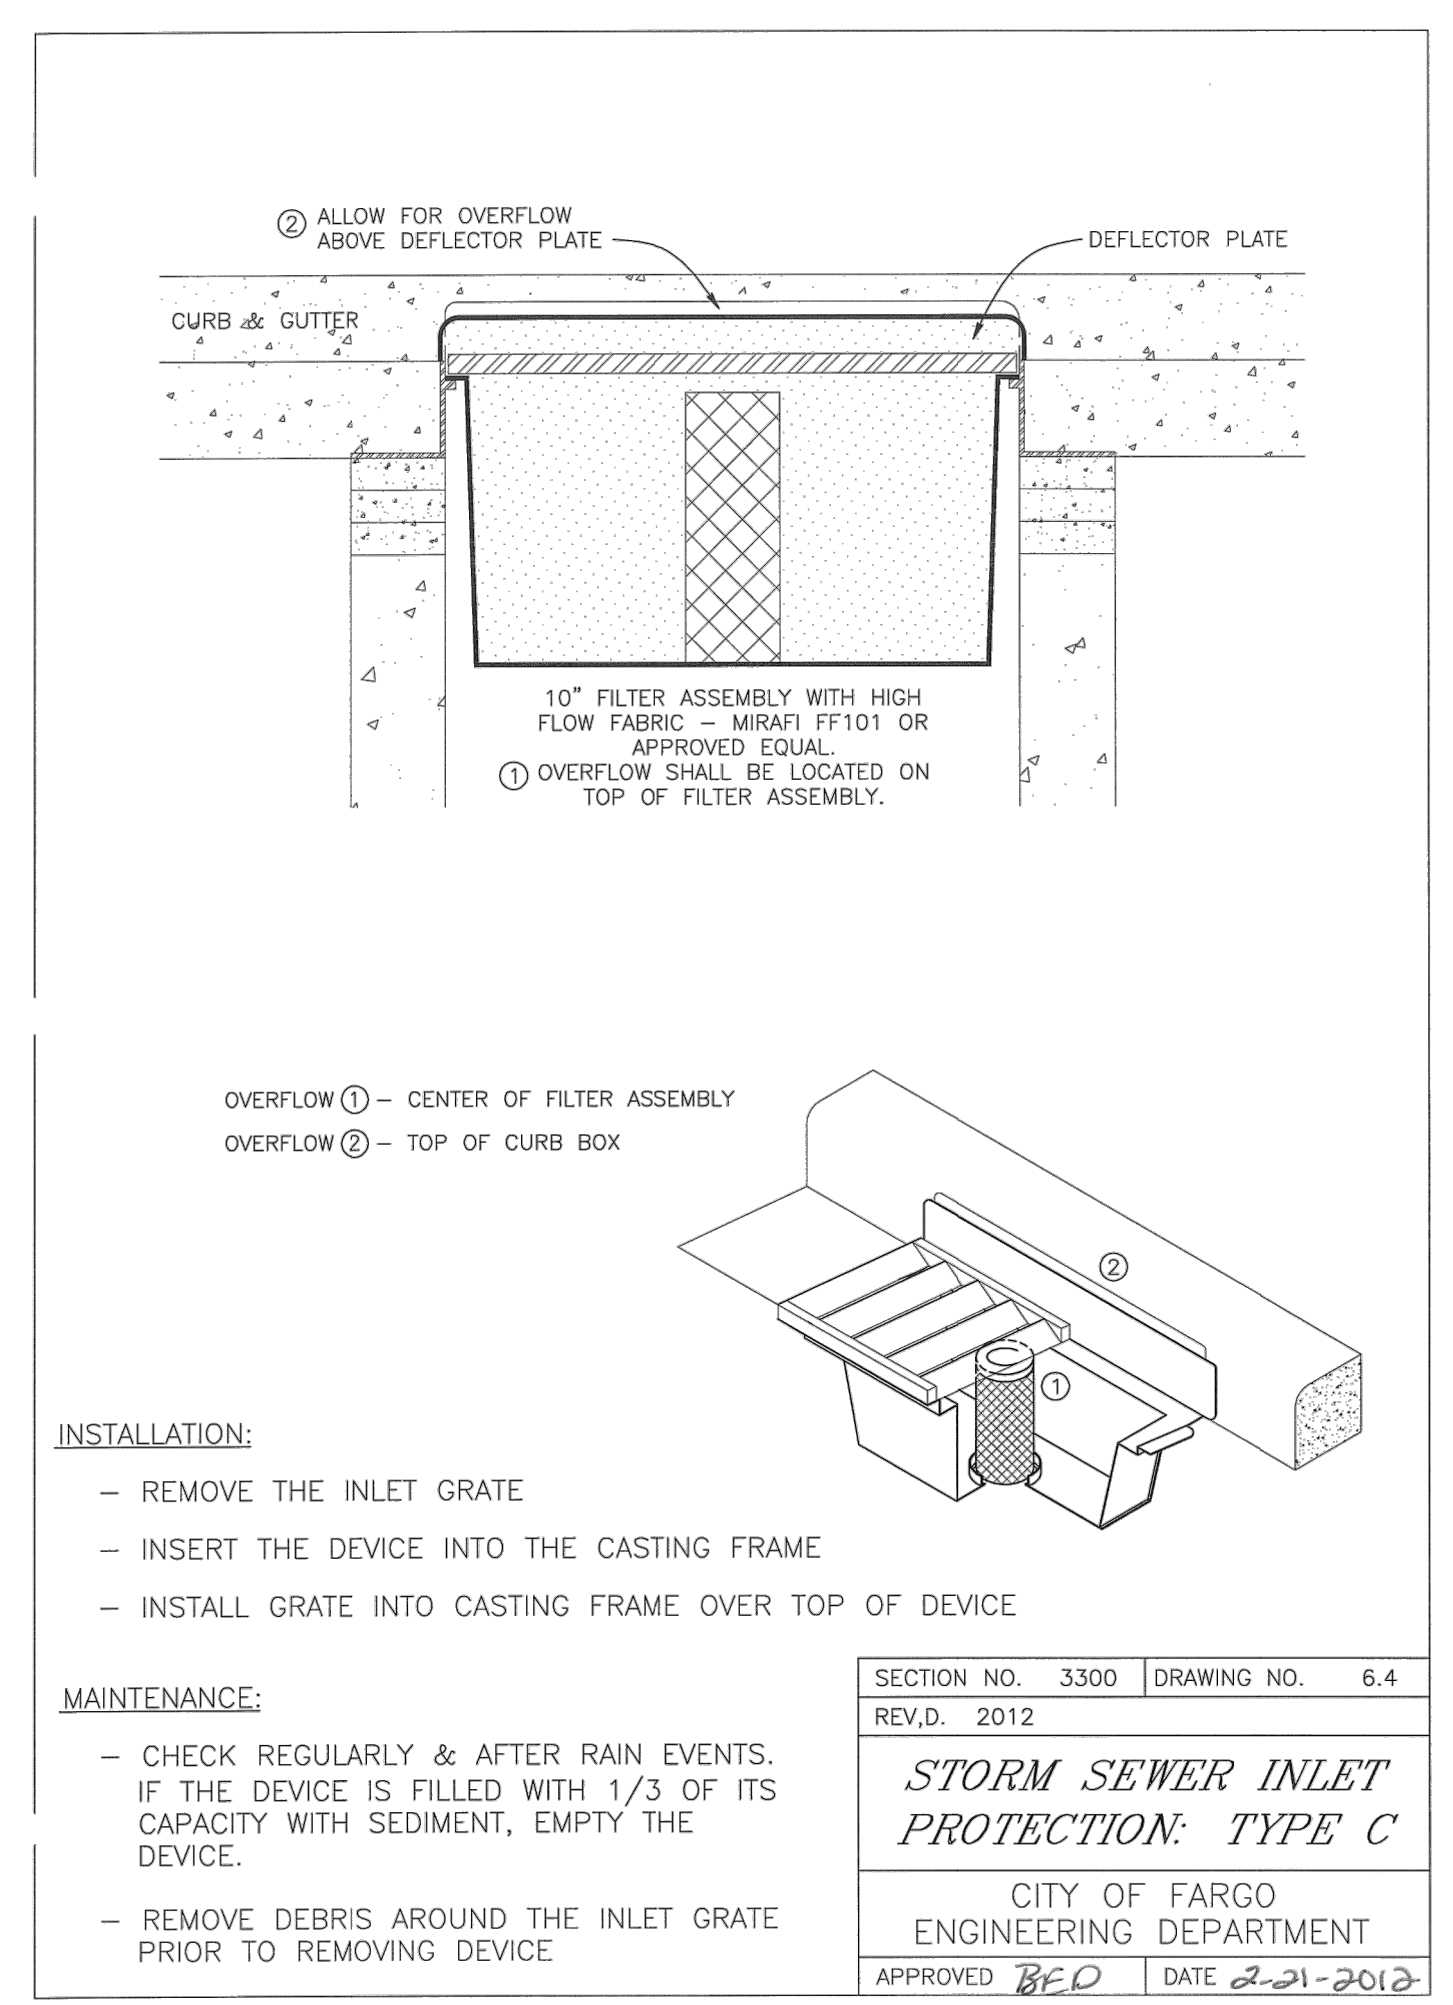





FARGO PUBLIC SCHOOLS

EAGLES ELEMENTARY
3502 S UNIVERSITY DR
FARGO, ND 58104

CIVIL
LOWRY ENGINEERING
5306 51ST AVE S STE A
FARGO, ND 58104
(701) 235.0199 OFFICE

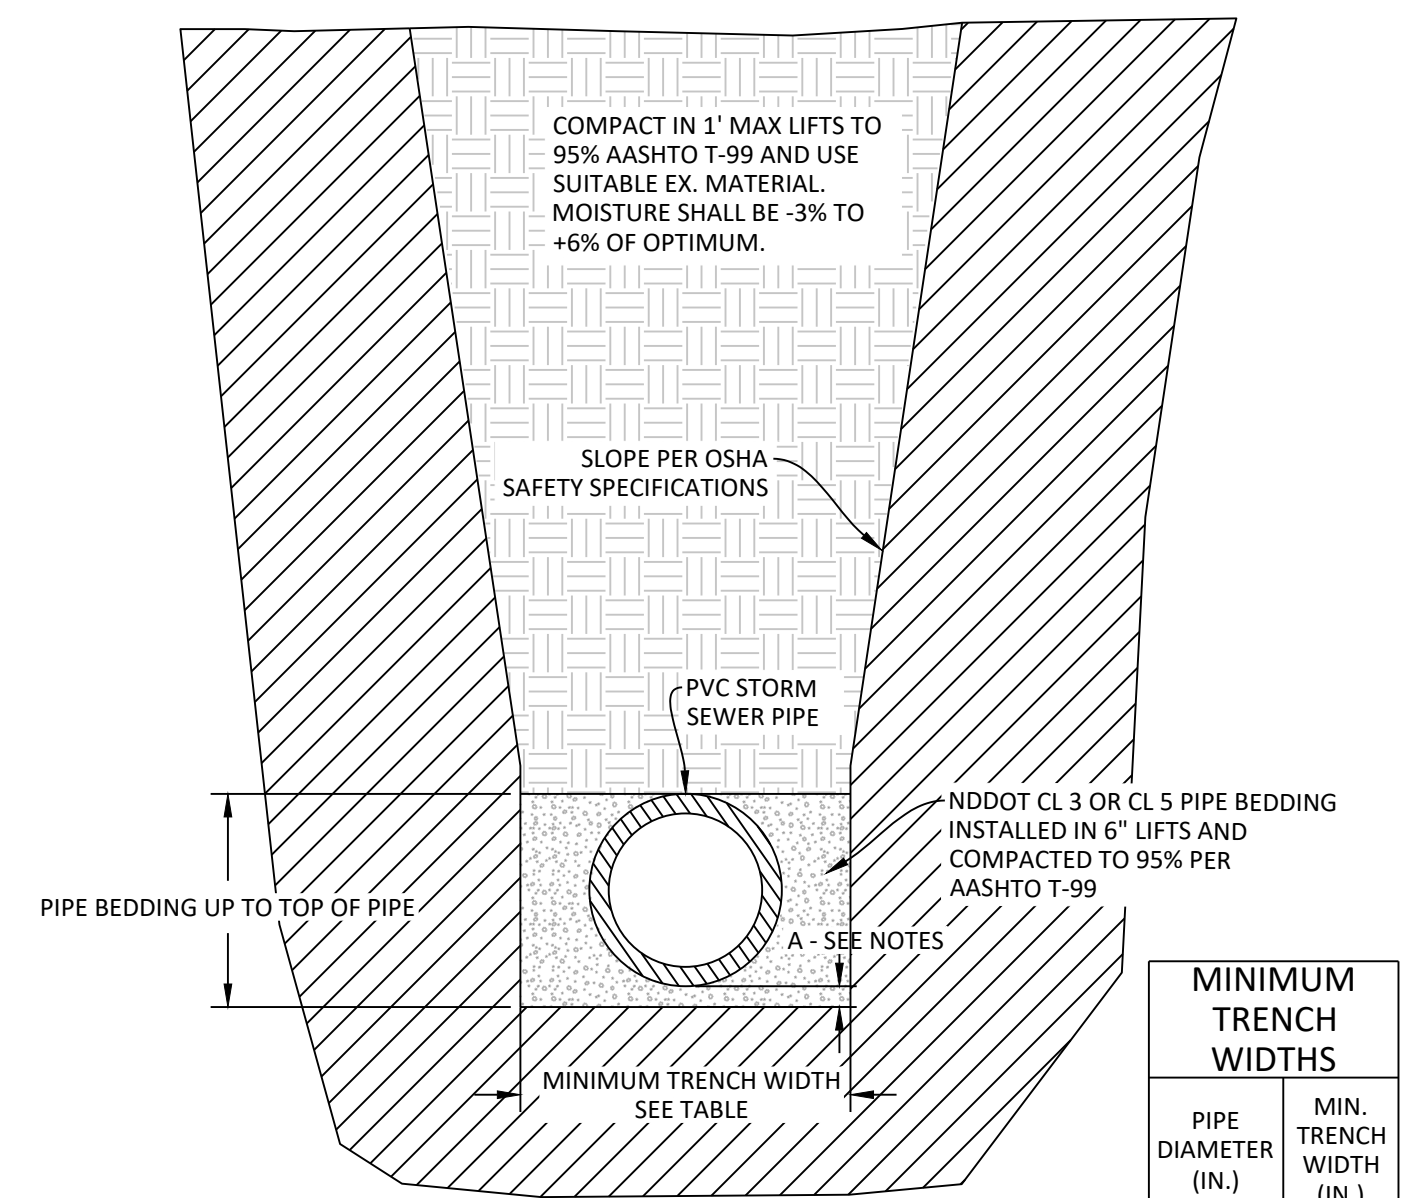


1 PVC STORM PIPE & CULVERT TRENCH BACKFILL
N.T.S.

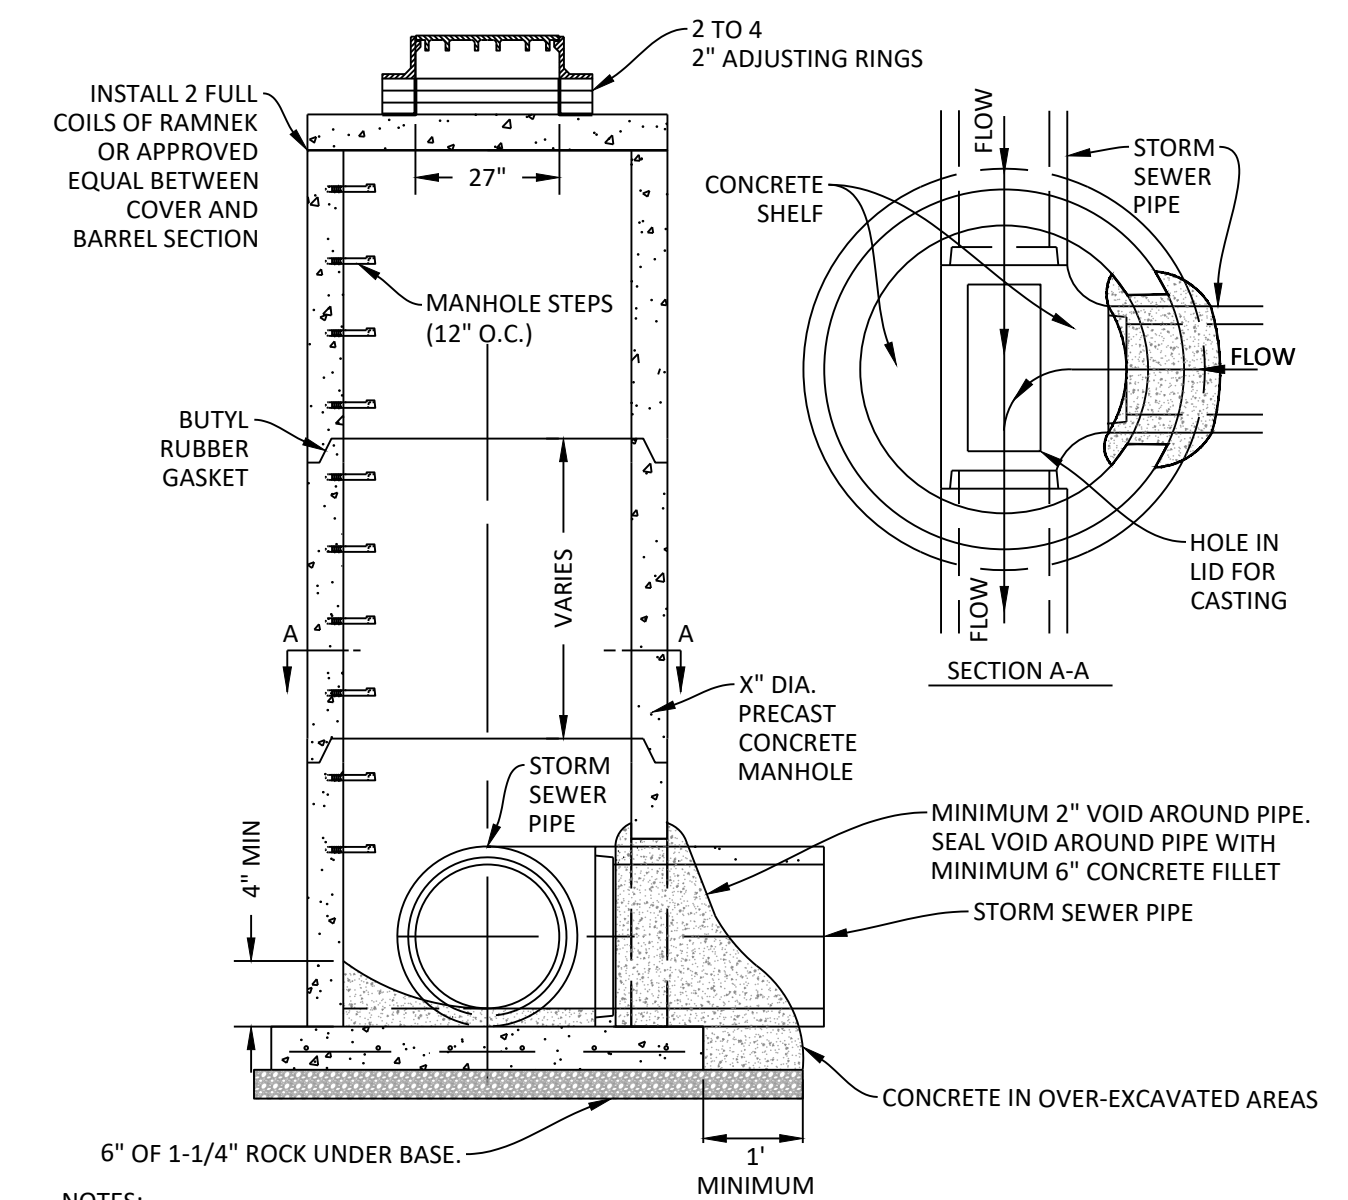


- NOTES:
1. ALL ROUND MANHOLES SHALL MEET REQUIREMENTS OF ASTM C478.
2. LIFT HOLES TO BE MANUFACTURED WATER PROOF.
3. BACKFILL AROUND MANHOLE IN 1' MAX LIFTS TO 95% PER AASHTO T-99. USE EXISTING MATERIAL UNLESS NOTED OTHERWISE. MOISTURE SHALL BE -3% TO +6% OF OPTIMUM.
4. CASTING TYPE PER MANHOLE SCHEDULE.
5. SOLID COVERS SHALL BE CAST WITH THE WORD "STORM" IN THE CENTER OF THE COVER IN LETTERS 2" HIGH.
6. CONTRACTOR MAY USE CONCRETE OR HDPE RINGS. IF HDPE RINGS ARE UTILIZED, SILICONE SEAL SHALL BE USED BETWEEN RINGS PER MANUFACTURER RECOMMENDATIONS. IF CONCRETE RINGS ARE USED, GROUT SHALL BE USED BETWEEN, OUTSIDE, AND INSIDE OF RINGS. GROUT SHALL MEET REQUIREMENTS OF ASTM C270.
7. REBAR AND WALL THICKNESS PER MANUFACTURERS RECOMMENDATION.
8. IF MANHOLE IS USED AS A CURB & GUTTER INLET, THE MANHOLE SHALL HAVE HOLE AVAILABLE FOR CONNECTION TO CURB & GUTTER DRAIN TILE AS REQUIRED.
9. BUTYL RUBBER GASKET ON ALL JOINTS. GASKET SHALL MEET ASTM C443 REQUIREMENTS.
10. DOGHOUSE TO BE CONCRETED INSIDE AND OUT WITH 3,000 PSI CONCRETE. CONCRETE SHALL BE VIBRATED AND TROWEL FINISHED.
11. WHEN STRUCTURE IS INSTALLED IN THE CURB LINE, THE CONTRACTOR SHALL SET MANHOLE SO THAT BACK OF CASTING ALIGNS WITH CURB FLOW LINE.
12. ALL ROUND MANHOLES/INLETS SHALL HAVE A MINIMUM HEIGHT OF SIX (6) FEET FROM RIM TO BOTTOM OF STRUCTURE. IF LOWEST INVERT IS ABOVE THIS, CONTRACTOR SHALL FILL BOTTOM VOID WITH 4,000 PSI CONCRETE AND FORM INVERTS ACCORDINGLY.

2 ROUND STORM MANHOLE/INLET
N.T.S.

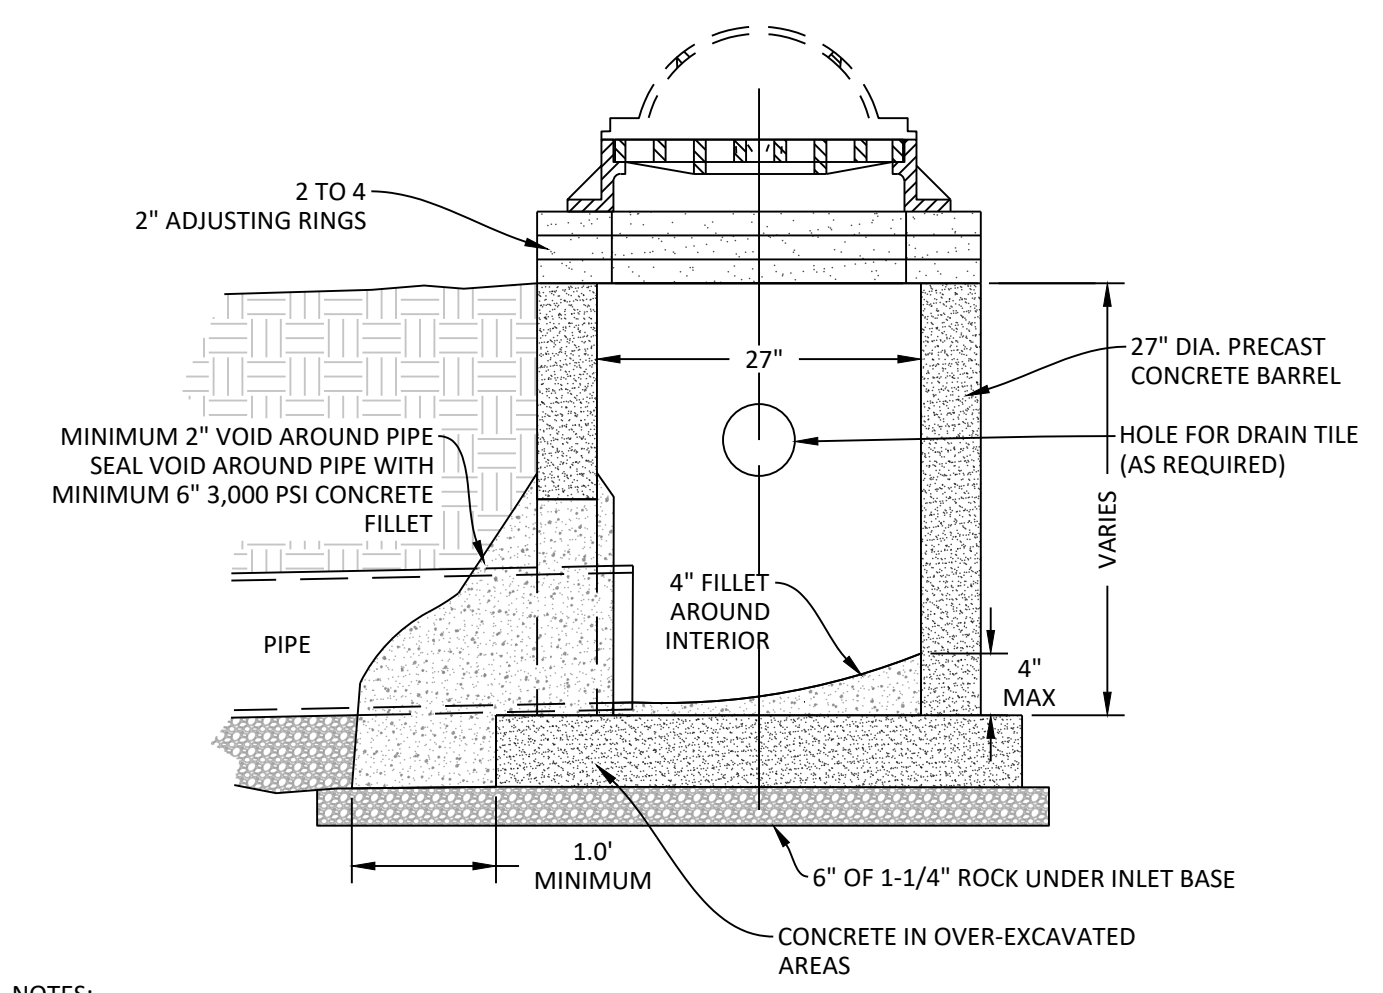


- NOTES:
1. ALL ROUND MANHOLES SHALL MEET REQUIREMENTS OF ASTM C478.
2. LIFT HOLES TO BE MANUFACTURED WATER PROOF.
3. BACKFILL AROUND MANHOLE IN 1' MAX LIFTS TO 95% PER AASHTO T-99. USE EXISTING MATERIAL UNLESS NOTED OTHERWISE. MOISTURE SHALL BE -3% TO +6% OF OPTIMUM.
4. CASTING TYPE PER MANHOLE SCHEDULE.
5. CONTRACTOR MAY USE CONCRETE OR HDPE RINGS. IF HDPE RINGS ARE UTILIZED, SILICONE SEAL SHALL BE USED BETWEEN RINGS PER MANUFACTURER RECOMMENDATIONS. IF CONCRETE RINGS ARE USED, GROUT SHALL BE USED BETWEEN, OUTSIDE, AND INSIDE OF RINGS. GROUT SHALL MEET REQUIREMENTS OF ASTM C270.
6. REBAR AND WALL THICKNESS PER MANUFACTURERS RECOMMENDATION.
7. IF MANHOLE IS USED AS A CURB & GUTTER INLET, THE MANHOLE SHALL HAVE HOLE AVAILABLE FOR CONNECTION TO CURB & GUTTER DRAIN TILE AS REQUIRED.
8. BUTYL RUBBER GASKET ON ALL JOINTS. GASKET SHALL MEET ASTM C443 REQUIREMENTS.
9. DOGHOUSE TO BE CONCRETED INSIDE AND OUT WITH 3,000 PSI CONCRETE. CONCRETE SHALL BE VIBRATED AND TROWEL FINISHED.
10. WHEN STRUCTURE IS INSTALLED IN THE CURB LINE, THE CONTRACTOR SHALL SET MANHOLE SO THAT BACK OF CASTING ALIGNS WITH CURB FLOW LINE.
11. (CLAY SOILS ONLY) IF IN PAVEMENT, STRUCTURE SHALL HAVE A MINIMUM HEIGHT OF SIX (6) FEET FROM RIM TO BOTTOM OF STRUCTURE. IF LOWEST INVERT IS ABOVE THIS, CONTRACTOR SHALL FILL BOTTOM VOID WITH 4,000 PSI CONCRETE AND FORM INVERTS ACCORDINGLY.

3 27" PAVEMENT/YARD INLET
N.T.S.

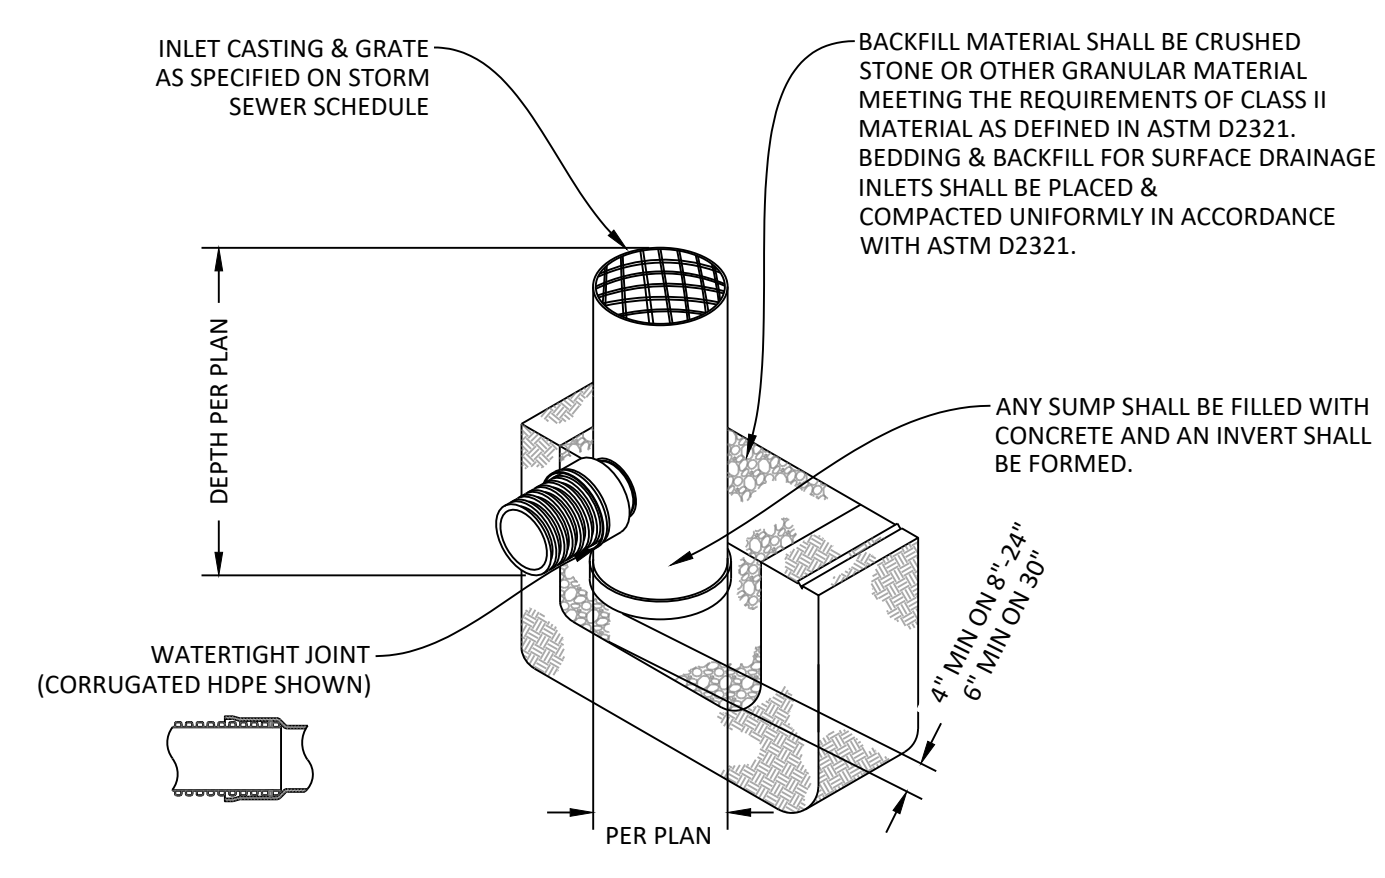

- NOTES:
1. CONTRACTOR SHALL CONTACT MANUFACTURER (ADS) FOR CORRECT SIZING OF STRUCTURES AND FOR INSTALLATION INSTRUCTIONS AND RECOMMENDATIONS.

4 NYLOPLAST HDPE YARD INLET
N.T.S.

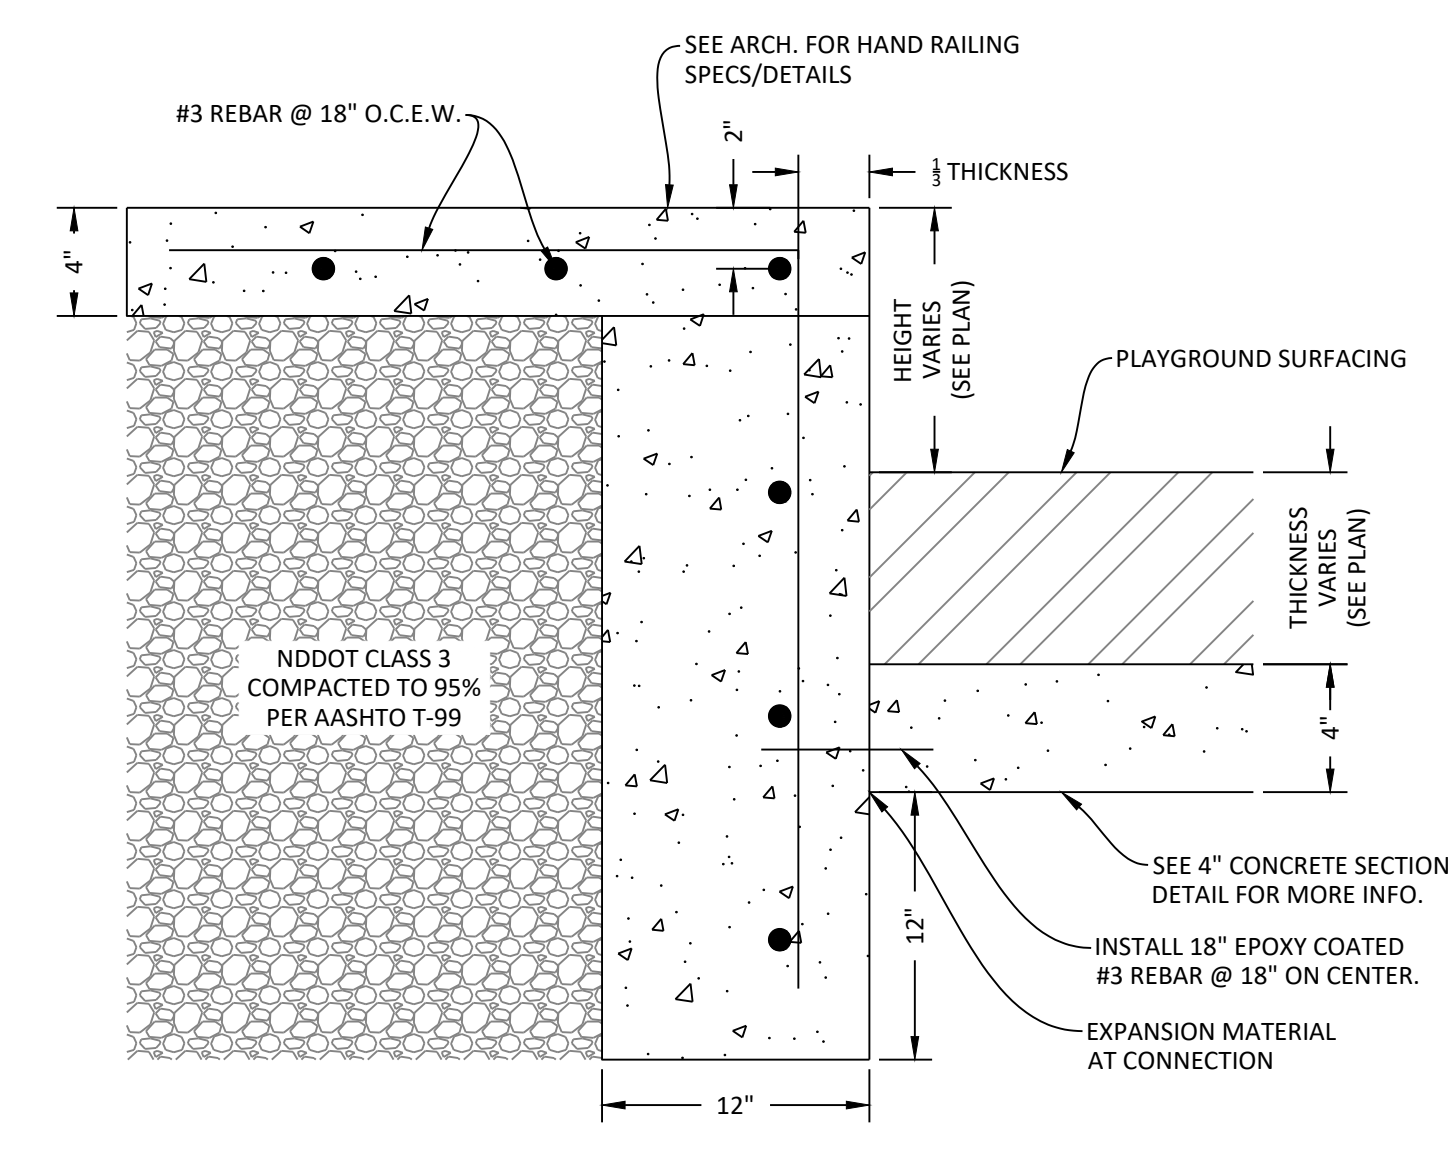

- NOTES:
1. PROVIDE 1/2" EXPANSION MATERIAL AT EXISTING CONCRETE JOINTS, BUILDINGS & ADJACENT TO CURB AND GUTTER.
2. PROVIDE FULL DEPTH EXPANSION JOINT WITH 1/2" EXPANSION MATERIAL AT 60' INTERVALS.
3. SAWCUT 1" DEEP AT 6' INTERVALS OR LESS TO APPROXIMATE SQUARE DESIGN.
4. PROVIDE 2-1/2" SMOOTH DOWELS @ 18" O.C. AT EXPANSION JOINTS.
5. CONCRETE SHALL BE 4,000 (OR HIGHER) PSI AND PER NDDOT SPECIFICATIONS

5 PLAYGROUND THICKENED EDGE SIDEWALK
N.T.S.



DRAWING HISTORY

NO.	DESCRIPTION	DATE
1	ADDENDUM #1	12/30/24

DRAWN BY: JT / KD JN: 24-060

DETAILS
EAGLES

SHEET
E-C8

LONGFELLOW ELEMENTARY SCHOOL SITE IMPROVEMENTS

20 29TH AVENUE NE
FARGO, NORTH DAKOTA 58102

OWNER'S REPRESENTATIVE
ICON ARCHITECTURAL GROUP
ALYSSA OMMEN, PROJECT ARCHITECT
3187 BLUESTEM DRIVE, SUITE 2
WEST FARGO, ND 58078
PH: 701-364-4007
EMAIL: alyssa.ommen@iconarchitects.com

CIVIL ENGINEER
LOWRY ENGINEERING
DREW MESSMER, P.E.
5306 51ST AVENUE SOUTH, SUITE A
FARGO, ND 58104
PH: 701-235-0199
EMAIL: dmessmer@lowryeng.com



4000 GARDEN VIEW DRIVE, SUITE 101
GRAND FORKS, ND 58201
P: 701.772.4266 | F: 701.772.4275
WWW.ICONARCHITECTS.COM



FARGO PUBLIC SCHOOLS

**LONGFELLOW ELEMENTARY
20 29TH AVE NE
FARGO, ND 58102**

MECHANICAL
MARTIN MECHANICAL DESIGN
1201 25TH AVE N
FARGO, ND 58102
(701) 233.7957 OFFICE

ELECTRICAL
CMTA
2201 12TH ST N STE E
FARGO, ND 58102
(701) 280.0500 OFFICE

CIVIL
LOWRY ENGINEERING
5306 51ST AVE S STE A
FARGO, ND 58104
(701) 235.0199 OFFICE

SITE INFORMATION	
SURVEY INFORMATION	
DATE OF SURVEY	11/26/2024
COORDINATE SYSTEM	CITY OF FARGO
DRAWING UNITS	US SURVEY FEET
VERTICAL DATUM	NAVD 88

BENCHMARK #1:
THE EX. STORM INLET RIM ON THE EAST SIDE OF THE EXISTING PLAYGROUND AND SIDEWALK LOCATED APPROXIMATELY 127 FEET NORTH WEST FROM THE PITCHERS MOUND OF THE BASEBALL FIELD.
ELEV.=896.06 (NAVD88)


BENCHMARK #2:
THE EX. STORM YARD INLET RIM BETWEEN THE TWO BUILDINGS TO THE WEST OF THE EXISTING PLAYGROUND LOCATED APPROXIMATELY 231 FEET WEST FROM THE PITCHERS MOUND OF THE BASEBALL FIELD.
ELEV.=896.02 (NAVD88)

BASIS OF BEARING: CITY OF FARGO COORDINATE SYSTEM (NAD83)


VICINITY MAP



SHEET INDEX	
LO-C1	COVER SHEET
LO-C2	GENERAL NOTES & LEGEND
LO-C3	SURVEY OVERLAY & DEMOLITION PLAN
LO-C4	OVERALL SITE PLAN
LO-C5	GRADING & UTILITY PLAN
LO-C6	EROSION & SEDIMENT CONTROL PLAN
LO-C7	DETAILS
LO-C8	DETAILS

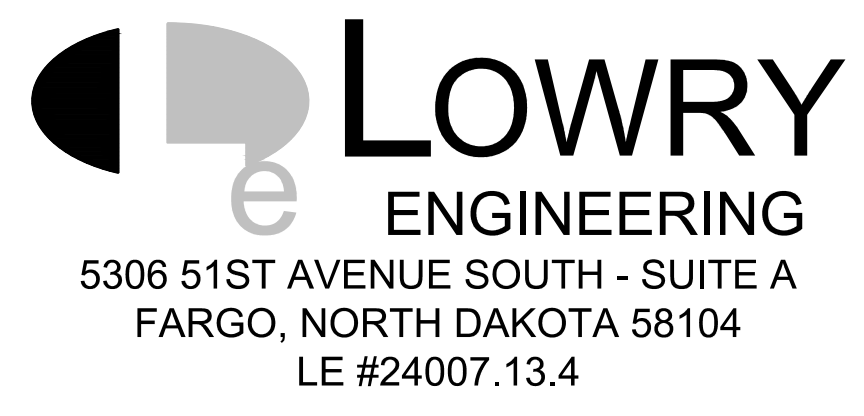

CALL BEFORE YOU DIG
NORTH DAKOTA
UTILITIES UNDERGROUND LOCATION SERVICE
1-800-795-0555

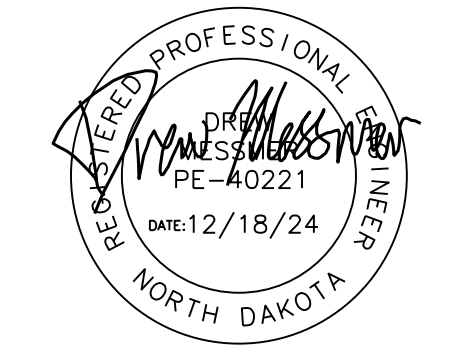


DRAWING HISTORY

NO.	DESCRIPTION	DATE
1	ADDENDUM #1	12/30/24

DRAWN BY: JT / KD JN: 24-060

**COVER SHEET
LONGFELLOW**

SHEET
LO-C1

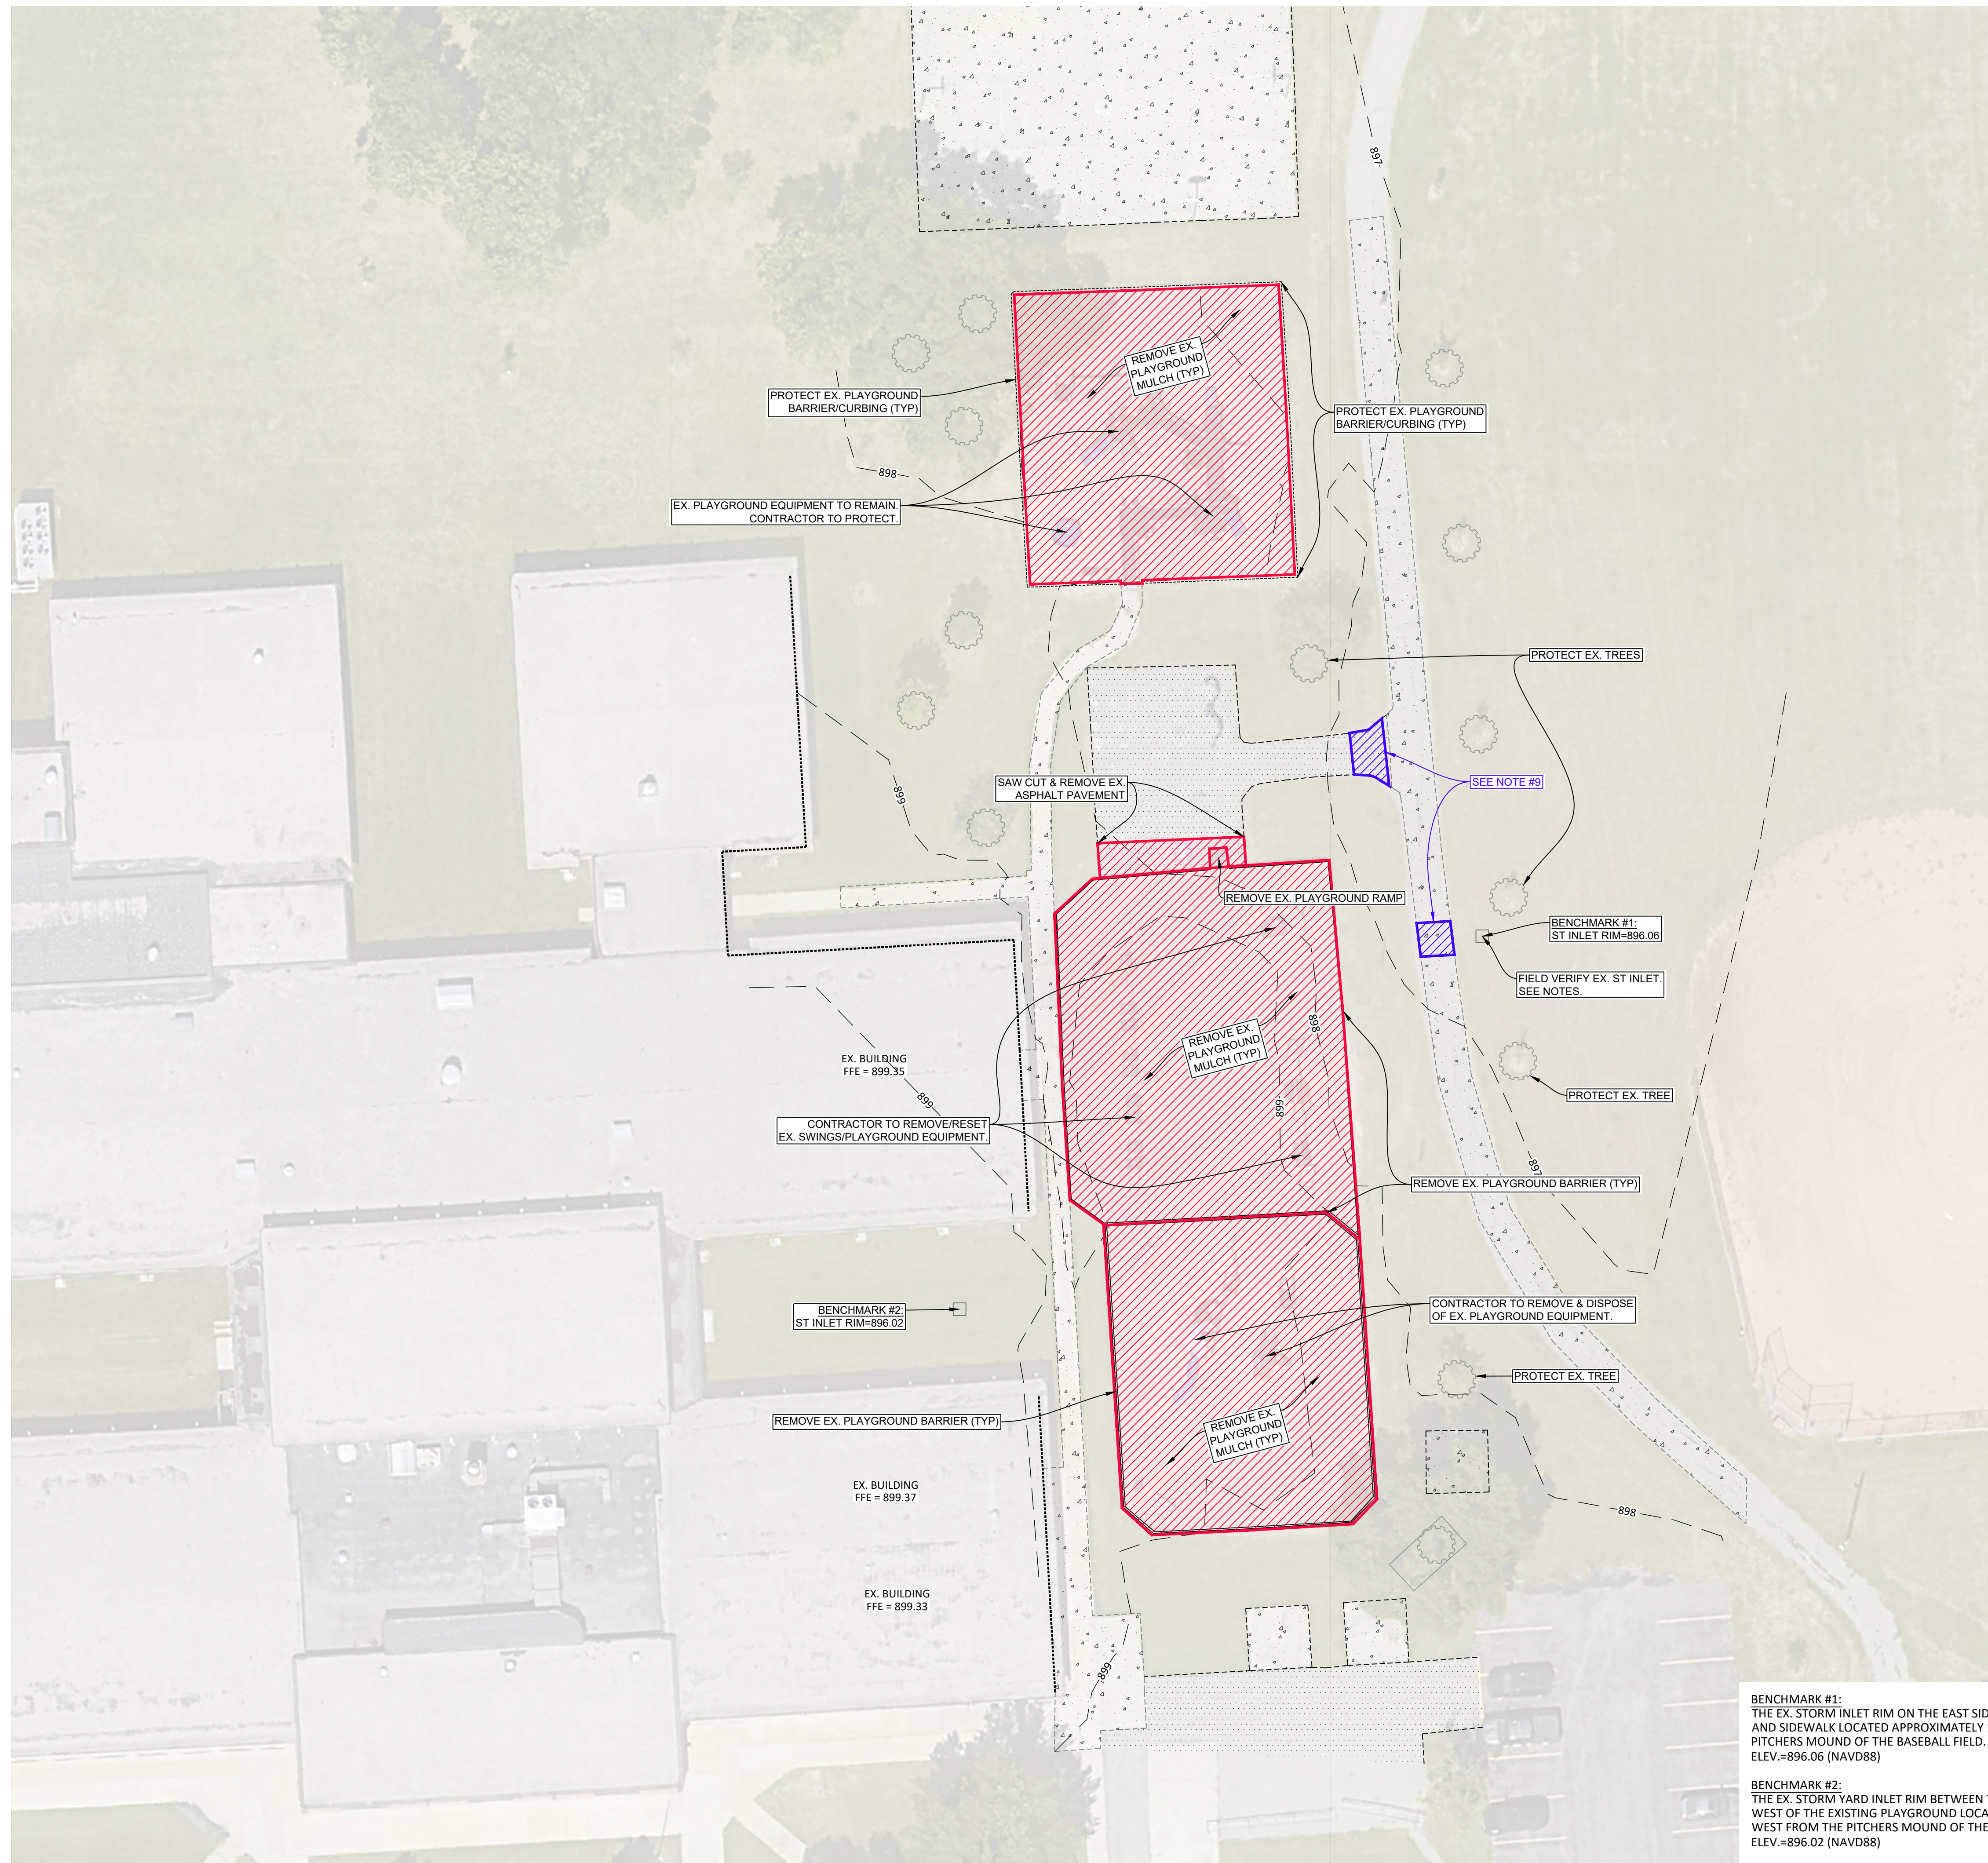

BENCHMARK #1:
THE EX. STORM INLET RIM ON THE EAST SIDE OF THE EXISTING PLAYGROUND AND SIDEWALK LOCATED APPROXIMATELY 127 FEET NORTH WEST FROM THE PITCHERS MOUND OF THE BASEBALL FIELD. ELEV.=896.06 (NAVD88)

BENCHMARK #2:
THE EX. STORM YARD INLET RIM BETWEEN THE TWO BUILDINGS TO THE WEST OF THE EXISTING PLAYGROUND LOCATED APPROXIMATELY 231 FEET WEST FROM THE PITCHERS MOUND OF THE BASEBALL FIELD. ELEV.=896.02 (NAVD88)

BASIS OF BEARING: CITY OF FARGO COORDINATE SYSTEM (NAD83)

DEMOLITION CALLOUTS*		
ITEM	QUANTITY	UNIT
REMOVE EX. CONCRETE SIDEWALK	12	SY
REMOVE EX. PLAYGROUND MULCH	500	SY

* EACH SY OF PAVEMENT REMOVALS SHALL INCLUDE REMOVAL OF EXISTING BASE, GEOFABRIC, AND SUBGRADE OF UP TO 12" BELOW FINISHED DESIGN GRADE OF NEW PAVEMENT AREAS.


- REMOVAL AREAS
- CONTRACTOR DETERMINED REMOVAL & REPLACEMENT AREAS

- BASE BID NOTES:**
- QUANTITIES ARE ENGINEERS ESTIMATES ONLY. CONTRACTOR SHALL DETERMINE THEIR OWN QUANTITIES AND BID ACCORDINGLY.
 - EXISTING CONDITIONS SHOWN ARE BASED ON OBSERVATIONS AT THE TIME THE SURVEY WAS COMPLETED. THE CONTRACTOR IS ENCOURAGED TO VISIT THE SITE IN ORDER TO BID APPROPRIATELY. QUANTITIES SHOWN AS ESTIMATES.
 - DEPTH OF EXISTING DRY UTILITIES ARE UNKNOWN. CONTRACTOR SHALL COORDINATE WITH UTILITY COMPANIES FOR CROSSINGS AND IMPACTS.
 - EXISTING PAVEMENT DEPTHS ARE UNKNOWN. CONTRACTOR SHALL SAW CUT AND REMOVE EXISTING PAVEMENT AREAS IN FULL SECTIONS AND REPORT ANY DISCREPANCIES TO THE ENGINEER IMMEDIATELY TO EVALUATE OR RESOLVE THE ISSUE.
 - CONTRACTOR SHALL SAW CUT AND REPLACE ANY EXISTING PAVEMENT DAMAGED DURING CONSTRUCTION AT NO ADDITIONAL COST.
 - ANY PLATFORMS OR PLAY ELEMENTS WITHIN 2'-6" A.F.F. OF THE INTENDED FINISHED SURFACE ELEVATION SHALL BE DISMANTLED, & STORED/PROTECTED & REINSTALLED. ALL VERTICAL STRUCTURAL POLES SHALL REMAIN IN PLACE.
 - CONCRETE CONTRACTOR TO SAW CUT OR FIELD FORM DIAMONDS AT EACH EXISTING VERTICAL POLE (1'-6" X 1'-6"). THESE DIAMOND AREAS TO BE POURED SEPARATELY. CONTRACTOR TO WRAP EXPANSION JOINT MATERIAL AROUND THE POLES BEFORE POURING CONCRETE.
 - PRIOR TO CONSTRUCTION, THE CONTRACTOR SHALL DETERMINE THE EXACT AMOUNT OF EXISTING SIDEWALK PAVEMENT TO BE REMOVED AND REPLACED/PATCHED NECESSARY TO CONNECT THE PROPOSED STORM PIPE TO THE EXISTING PLAYGROUND STORM DRAIN INLET, ACCORDING TO THE CONTRACTOR'S AVAILABLE EQUIPMENT AND ABILITY TO INSTALL THE STORM PIPE PIECE. CONTRACTOR IS RESPONSIBLE FOR THEIR OWN QUANTITIES AS IT RELATES TO THE SIZE OF THE NECESSARY OPEN CUT/PATCHING NEEDED FOR THE PROPOSED STORM TIE-IN.
 - DEMOLITION QUANTITIES DO NOT INCLUDE "CONTRACTOR DETERMINED REMOVAL AREAS". CONTRACTOR SHALL REPLACE AREAS TO MATCH EXISTING CROSS SECTIONS AND MATERIALS.
 - TOPOGRAPHIC SURVEY WAS CONDUCTED BY LOWRY ENGINEERING ON NOVEMBER 26, 2024.
 - TOPOGRAPHIC SURVEY WAS COMPLETED DURING WINTER MONTHS. UTILITY LOCATES AND OTHER FEATURES THAT ARE INACCESSIBLE DUE TO WINTER CONDITIONS MAY HAVE LIMITED ACCURACY. CONTRACTOR SHALL VERIFY LOCATIONS/INVERTS PRIOR TO CONSTRUCTION.
 - PRIOR TO CONSTRUCTION OR ORDERING OF ANY MATERIALS, CONTRACTOR SHALL FIELD INVESTIGATE/POTHOLE EXISTING STORM DRAIN INLET, EAST OF EXISTING PLAYGROUND AREAS, TO IDENTIFY EXACT STORM PIPE SIZES, CONNECTION DIRECTIONS, AND INVERT ELEVATIONS. ANY DISCREPANCIES SHALL BE REPORTED TO THE ENGINEER IMMEDIATELY TO EVALUATE FINAL DESIGN.

ALTERNATE #1 - DEMOLITION CALLOUTS*		
ITEM	QUANTITY	UNIT
REMOVE EX. ASPHALT PAVEMENT	30	SY
REMOVE EX. PLAYGROUND BARRIER	500	LF
REMOVE EX. PLAYGROUND MULCH	1,110	SY
REMOVE EX. PLAYGROUND RAMP	1	EA
REMOVE EX. PLAYGROUND EQUIPMENT	1	LS

* EACH SY OF PAVEMENT REMOVALS SHALL INCLUDE REMOVAL OF EXISTING BASE, GEOFABRIC, AND SUBGRADE OF UP TO 12" BELOW FINISHED DESIGN GRADE OF NEW PAVEMENT AREAS.

- ALTERNATE #1 NOTES:**
- IF THE ALTERNATIVE PLAYGROUND IMPROVEMENTS ARE CHOSEN FOR THE EXISTING PLAYGROUND AREAS, THE CONTRACTOR SHALL COORDINATE WITH FARGO PUBLIC SCHOOLS ON THE EXACT LOCATIONS FOR THE SALVAGED/NEW PLAYGROUND EQUIPMENT TO BE REINSTALLED.
 - QUANTITIES ARE ENGINEERS ESTIMATES ONLY. CONTRACTOR SHALL DETERMINE THEIR OWN QUANTITIES AND BID ACCORDINGLY.

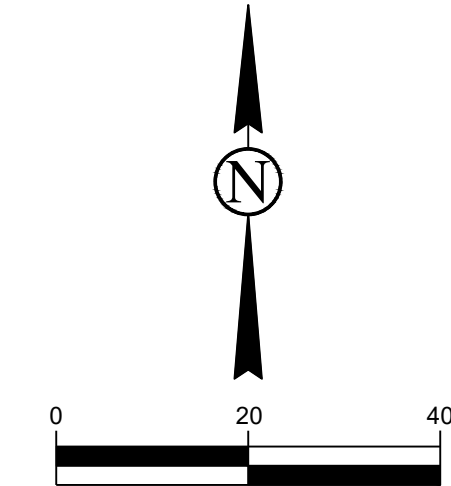

CALL BEFORE YOU DIG
NORTH DAKOTA
UTILITIES UNDERGROUND LOCATION SERVICE
1-800-795-0555



4000 GARDEN VIEW DRIVE, SUITE 101
GRAND FORKS, ND 58201
P. 701.772.4266 | F. 701.772.4275
WWW.ICONARCHITECTS.COM




FARGO PUBLIC SCHOOLS
LONGFELLOW ELEMENTARY
20 29TH AVE NE
FARGO, ND 58102

MECHANICAL
MARTIN MECHANICAL DESIGN
1201 25TH AVE N
FARGO, ND 58102
(701) 293.7957 OFFICE

ELECTRICAL
CMTA
2201 12TH ST N STE E
FARGO, ND 58102
(701) 280.0500 OFFICE

CIVIL
LOWRY ENGINEERING
5306 51ST AVE S STE A
FARGO, ND 58104
(701) 235.0199 OFFICE

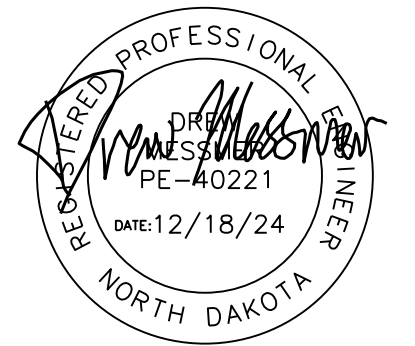


DRAWING HISTORY

NO.	DESCRIPTION	DATE
1	ADDENDUM #1	12/30/24

DRAWN BY: JT / KD JN: 24-060

SURVEY OVERLAY & DEMOLITION PLAN
LONGFELLOW
SHEET
LO-C3

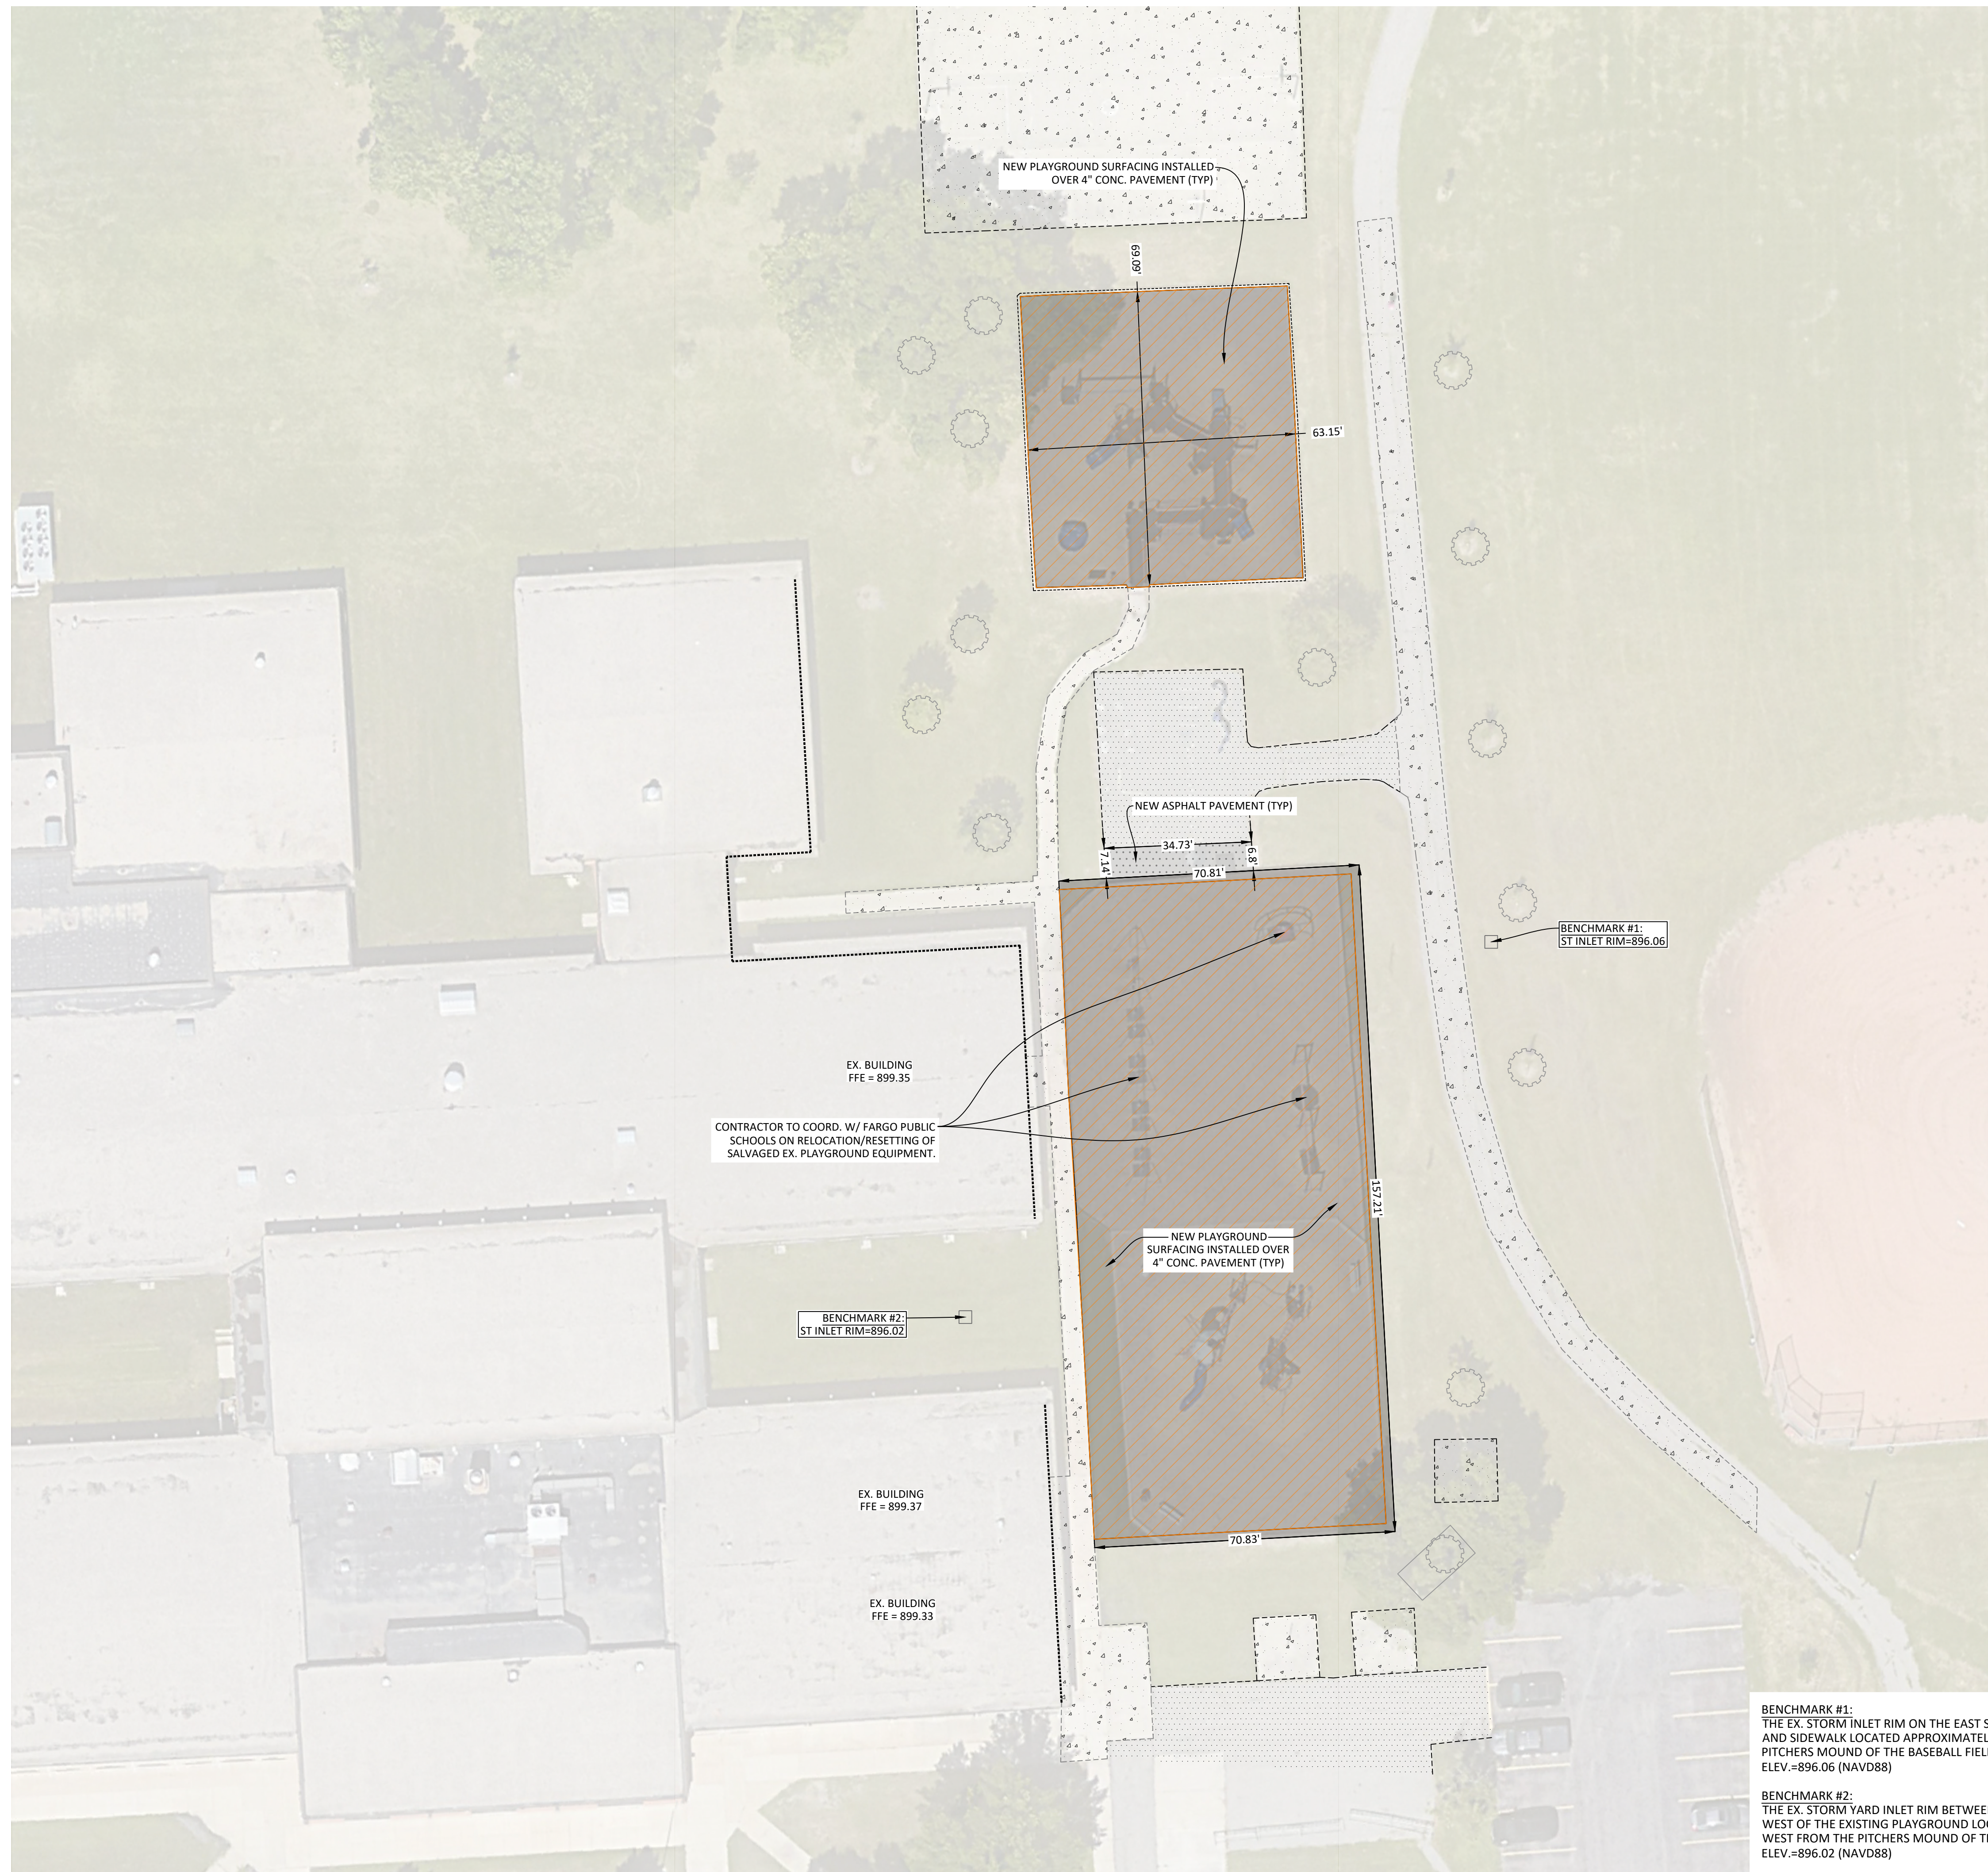

BENCHMARK #1:
THE EX. STORM INLET RIM ON THE EAST SIDE OF THE EXISTING PLAYGROUND AND SIDEWALK LOCATED APPROXIMATELY 127 FEET NORTH WEST FROM THE PITCHER'S MOUND OF THE BASEBALL FIELD.
ELEV.=896.06 (NAVD88)

BENCHMARK #2:
THE EX. STORM YARD INLET RIM BETWEEN THE TWO BUILDINGS TO THE WEST OF THE EXISTING PLAYGROUND LOCATED APPROXIMATELY 231 FEET WEST FROM THE PITCHER'S MOUND OF THE BASEBALL FIELD.
ELEV.=896.02 (NAVD88)


BASIS OF BEARING: CITY OF FARGO COORDINATE SYSTEM (NAD83)

ESTIMATED SITE QUANTITIES*		
ITEM	QUANTITY	UNIT
SUBGRADE PREPARATION	490	SY
NDDOT TYPE R1 GEOSYNTHETIC FABRIC	490	SY
NDDOT CLASS 5 AGGREGATE	85	CY
CONCRETE PLAYGROUND PAVEMENT - FLATWORK 4"	490	SY
PLAYGROUND SURFACING	490	SY

* ALL BLACK DIRT/SEEDING/GRADING ADJACENT TO NEW CURBING AND PAVEMENT AREAS, FOR PIPE INSTALLATION AND ANY GRADING AS DESIGNATED IN THE PLANS, ARE INCIDENTAL TO THE PROJECT. WATERING THE SEEDING UNTIL IT IS FULLY ESTABLISHED IS INCIDENTAL TO THE PROJECT.

BASE BID NOTES:

1. QUANTITIES ARE ENGINEERS ESTIMATES ONLY. CONTRACTOR SHALL DETERMINE THEIR OWN QUANTITIES AND BID ACCORDINGLY.
2. AGGREGATE BASE QUANTITY ASSUMES IT EXTENDS TO 1' BEYOND BACK OF CURB OR EDGE OF PAVEMENT UNLESS ADJACENT TO STRUCTURE OR EXISTING PAVEMENT SAW CUT SECTIONS.
3. AGGREGATE BASE QUANTITIES ARE BASED ON IN PLACE VOLUME.
4. GEOTEXTILE FABRIC PANELS SHALL BE A MINIMUM OF 12' WIDE AND INSTALLED WITH A MINIMUM OVERLAP OF 18" WITH JOINTS ORIENTATED TO FOLLOW TRAFFIC MOVEMENT. GEOTEXTILE FABRIC SHALL EXTENDS TO 1' BEYOND THE BACK OF CURB OR EDGE OF PAVEMENT UNLESS ADJACENT TO STRUCTURE OR EXISTING PAVEMENT SAW CUT SECTIONS.
5. PRIOR TO CONSTRUCTION, CONTRACTOR SHALL COORDINATE WITH THE ENGINEER TO DETERMINE THE EXACT AMOUNT AND LOCATIONS OF THE EXISTING CURBING/SIDEWALK/PAVEMENT TO BE REMOVED AND REPLACED/PATCHED NECESSARY FOR THE PROJECT IMPROVEMENTS.

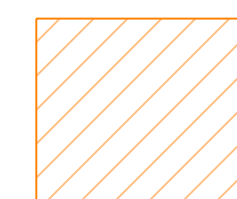


- PLAYGROUND SURFACING OVER CONCRETE FLATWORK.
- SEE ARCH. FOR DETAILS/SPECS ON SURFACING.
- SEE CIVIL FOR DETAILS/SPECS ON CONCRETE FLAT WORK & GRADING

ALTERNATE #1 - ESTIMATED SITE QUANTITIES*		
ITEM	QUANTITY	UNIT
SUBGRADE PREPARATION	1,280	SY
NDDOT TYPE R1 GEOSYNTHETIC FABRIC	1,280	SY
NDDOT CLASS 5 AGGREGATE	220	CY
PLAYGROUND SURFACE MAT	1,190	SY
CONCRETE PLAYGROUND PAVEMENT - FLATWORK 4"	1,250	SY
PLAYGROUND EQUIPMENT	1	LS

* ALL BLACK DIRT/SEEDING/GRADING ADJACENT TO NEW CURBING AND PAVEMENT AREAS, FOR PIPE INSTALLATION AND ANY GRADING AS DESIGNATED IN THE PLANS, ARE INCIDENTAL TO THE PROJECT. WATERING THE SEEDING UNTIL IT IS FULLY ESTABLISHED IS INCIDENTAL TO THE PROJECT.

ALTERNATE #1 NOTES:

1. IF THE ALTERNATIVE PLAYGROUND IMPROVEMENTS ARE CHOSEN FOR THE EXISTING PLAYGROUND AREAS, THE CONTRACTOR SHALL COORDINATE WITH FARGO PUBLIC SCHOOLS ON THE EXACT LOCATIONS FOR THE SALVAGED/NEW PLAYGROUND EQUIPMENT TO BE REINSTALLED.
2. QUANTITIES ARE ENGINEERS ESTIMATES ONLY. CONTRACTOR SHALL DETERMINE THEIR OWN QUANTITIES AND BID ACCORDINGLY.

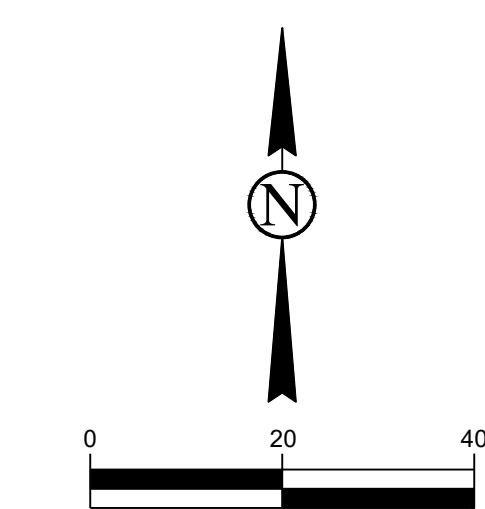

CALL BEFORE YOU DIG
NORTH DAKOTA
UTILITIES UNDERGROUND LOCATION SERVICE
1-800-795-0555



FARGO PUBLIC SCHOOLS

LONGFELLOW ELEMENTARY
20 29TH AVE NE
FARGO, ND 58102

MECHANICAL


MARTIN MECHANICAL DESIGN
1201 25TH AVE N
FARGO, ND 58102
(701) 293.7957 OFFICE

ELECTRICAL

CMTA
2201 12TH ST N STE E
FARGO, ND 58102
(701) 280.0500 OFFICE

CIVIL

LOWRY ENGINEERING
5306 51ST AVE S STE A
FARGO, ND 58104
(701) 235.0199 OFFICE

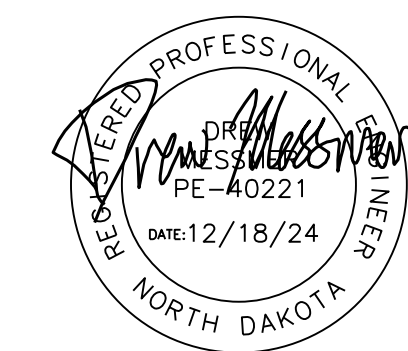

DRAWING HISTORY


NO.	DESCRIPTION	DATE
1	ADDENDUM #1	12/30/24

DRAWN BY: JT / KD JN: 24-060

**OVERALL SITE PLAN
LONGFELLOW**

SHEET

LO-C4

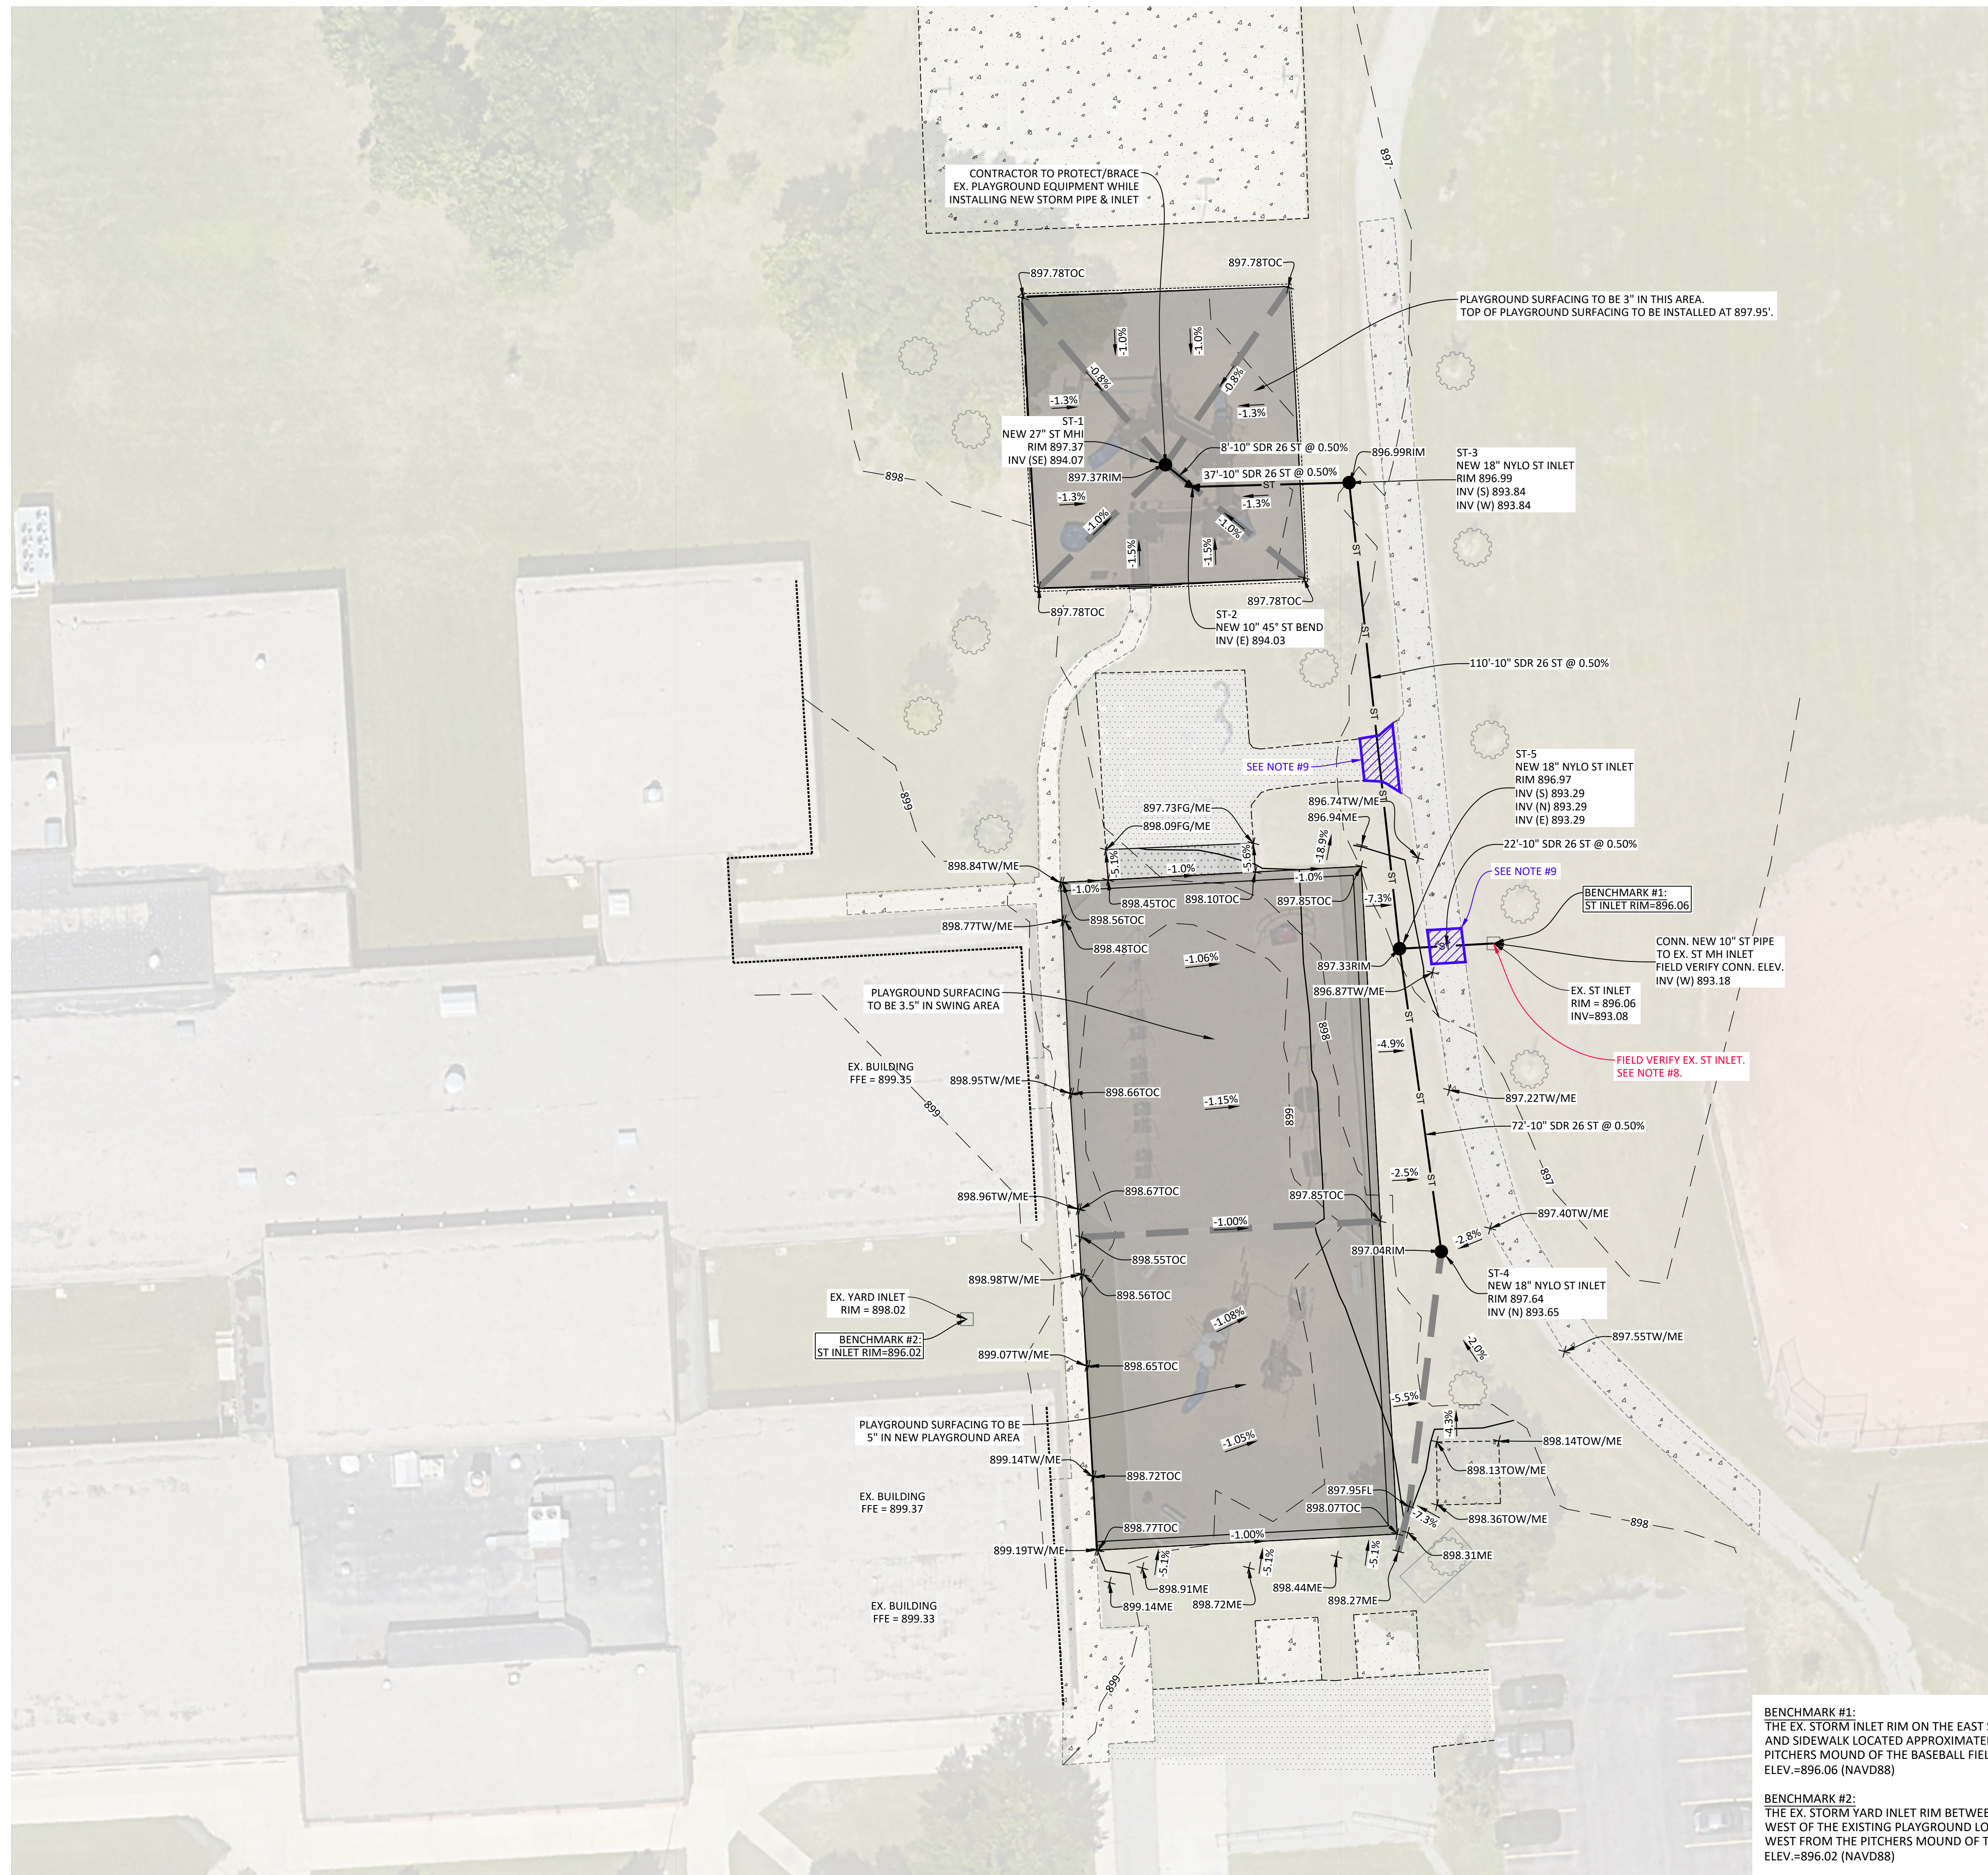


- NOTES:
- CONTRACTOR IS RESPONSIBLE FOR CALCULATING THEIR OWN EARTHWORK/GRADING TAKEOFF QUANTITIES FOR THE PROPOSED SITE.
 - PRIOR TO CONSTRUCTION, THE CONTRACTOR IS ENCOURAGED TO VISIT THE SITE TO BETTER DETERMINE THE NECESSARY AMOUNT OF STRIPPING TO OCCUR THROUGHOUT THE SITE.
 - TOPSOIL SHALL NOT BE USED AS FILL UNDER THE PAVEMENT AREAS.
 - NEW INLET CASTING WITHIN THE PLAYGROUND AREA SHALL BE EIJW 120S TYPE M GRATE OR APPROVED EQUAL. CONTRACTOR TO INSTALL SCREEN OVER TOP OF CASTING, PER SURFACING MANUFACTURER RECOMMENDATIONS, PRIOR TO INSTALLATION OF RUBBER PLAYGROUND MAT SURFACING.
 - NEW NYLOPLAST INLET CASTINGS SHALL BE BEEHIVE STYLE GRATE.
 - IF ANY POTENTIAL UTILITY CONFLICTS OR PIPE COVER CONCERNS ARE DISCOVERED, CONTRACTOR SHALL CONTACT THE ENGINEER IMMEDIATELY TO EVALUATE OR RESOLVE THE ISSUE.
 - PRIOR TO CONSTRUCTION, THE CONTRACTOR SHALL DETERMINE THE EXACT AMOUNT OF EXISTING SIDEWALK PAVEMENT TO BE REMOVED AND REPLACED/PATCHED NECESSARY TO CONNECT THE PROPOSED STORM PIPE TO THE EXISTING PLAYGROUND STORM DRAIN INLET, ACCORDING TO THE CONTRACTOR'S AVAILABLE EQUIPMENT AND ABILITY TO INSTALL THE STORM PIPE PIECE. CONTRACTOR IS RESPONSIBLE FOR THEIR OWN QUANTITIES AS IT RELATES TO THE SIZE OF THE NECESSARY OPEN CUT/PATCHING NEEDED FOR THE PROPOSED STORM TIE-IN.
 - DEMOLITION QUANTITIES DO NOT INCLUDE "CONTRACTOR DETERMINED REMOVAL AREAS". CONTRACTOR SHALL REPLACE AREAS TO MATCH EXISTING CROSS SECTIONS AND MATERIALS.
 - PRIOR TO CONSTRUCTION OR ORDERING OF ANY MATERIALS, CONTRACTOR SHALL FIELD INVESTIGATE/POTHOLE EXISTING STORM DRAIN INLET, EAST OF EXISTING PLAYGROUND AREAS, TO IDENTIFY EXACT STORM PIPE SIZES, CONNECTION DIRECTIONS, AND INVERT ELEVATIONS. ANY DISCREPANCIES SHALL BE REPORTED TO THE ENGINEER IMMEDIATELY TO EVALUATE FINAL DESIGN.

	- CONTRACTOR DETERMINED REMOVAL & REPLACEMENT AREAS
	GRADE BREAK / FLOW PATH
FG	FINISH GROUND
FL	FLOWLINE
HP	HIGH POINT
LP	LOW POINT
ME	MATCH EXISTING GROUND
RIM	STRUCTURE RIM ELEVATION
TC	TOP OF CURB/THICKENED EDGE
TOC	TOP OF CONCRETE
TW	TOP OF WALK

BENCHMARK #1:
THE EX. STORM INLET RIM ON THE EAST SIDE OF THE EXISTING PLAYGROUND AND SIDEWALK LOCATED APPROXIMATELY 127 FEET NORTH WEST FROM THE PITCHERS MOUND OF THE BASEBALL FIELD.
ELEV.=896.06 (NAVD88)

BENCHMARK #2:
THE EX. STORM YARD INLET RIM BETWEEN THE TWO BUILDINGS TO THE WEST OF THE EXISTING PLAYGROUND LOCATED APPROXIMATELY 231 FEET WEST FROM THE PITCHERS MOUND OF THE BASEBALL FIELD.
ELEV.=896.02 (NAVD88)

BASIS OF BEARING: CITY OF FARGO COORDINATE SYSTEM (NAD83)

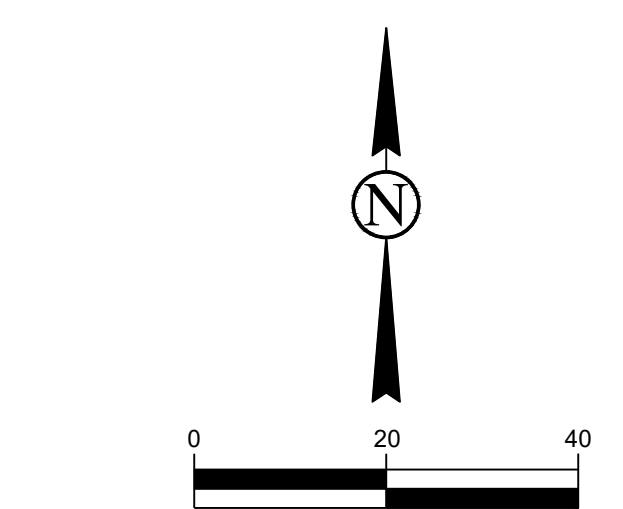

CALL BEFORE YOU DIG
NORTH DAKOTA
UTILITIES UNDERGROUND LOCATION SERVICE
1-800-795-0555



FARGO PUBLIC SCHOOLS
LONGFELLOW ELEMENTARY
20 29TH AVE NE
FARGO, ND 58102

MECHANICAL
MARTIN MECHANICAL DESIGN
1201 25TH AVE N
FARGO, ND 58102
(701) 233.7957 OFFICE

ELECTRICAL
CMTA
2201 12TH ST N STE E
FARGO, ND 58102
(701) 280.0500 OFFICE

CIVIL
LOWRY ENGINEERING
5306 51ST AVE S STE A
FARGO, ND 58104
(701) 235.0199 OFFICE




DRAWING HISTORY

NO.	DESCRIPTION	DATE
1	ADDENDUM #1	12/30/24

DRAWN BY: JT / KD
JN: 24-060

GRADING & UTILITY PLAN
LONGFELLOW

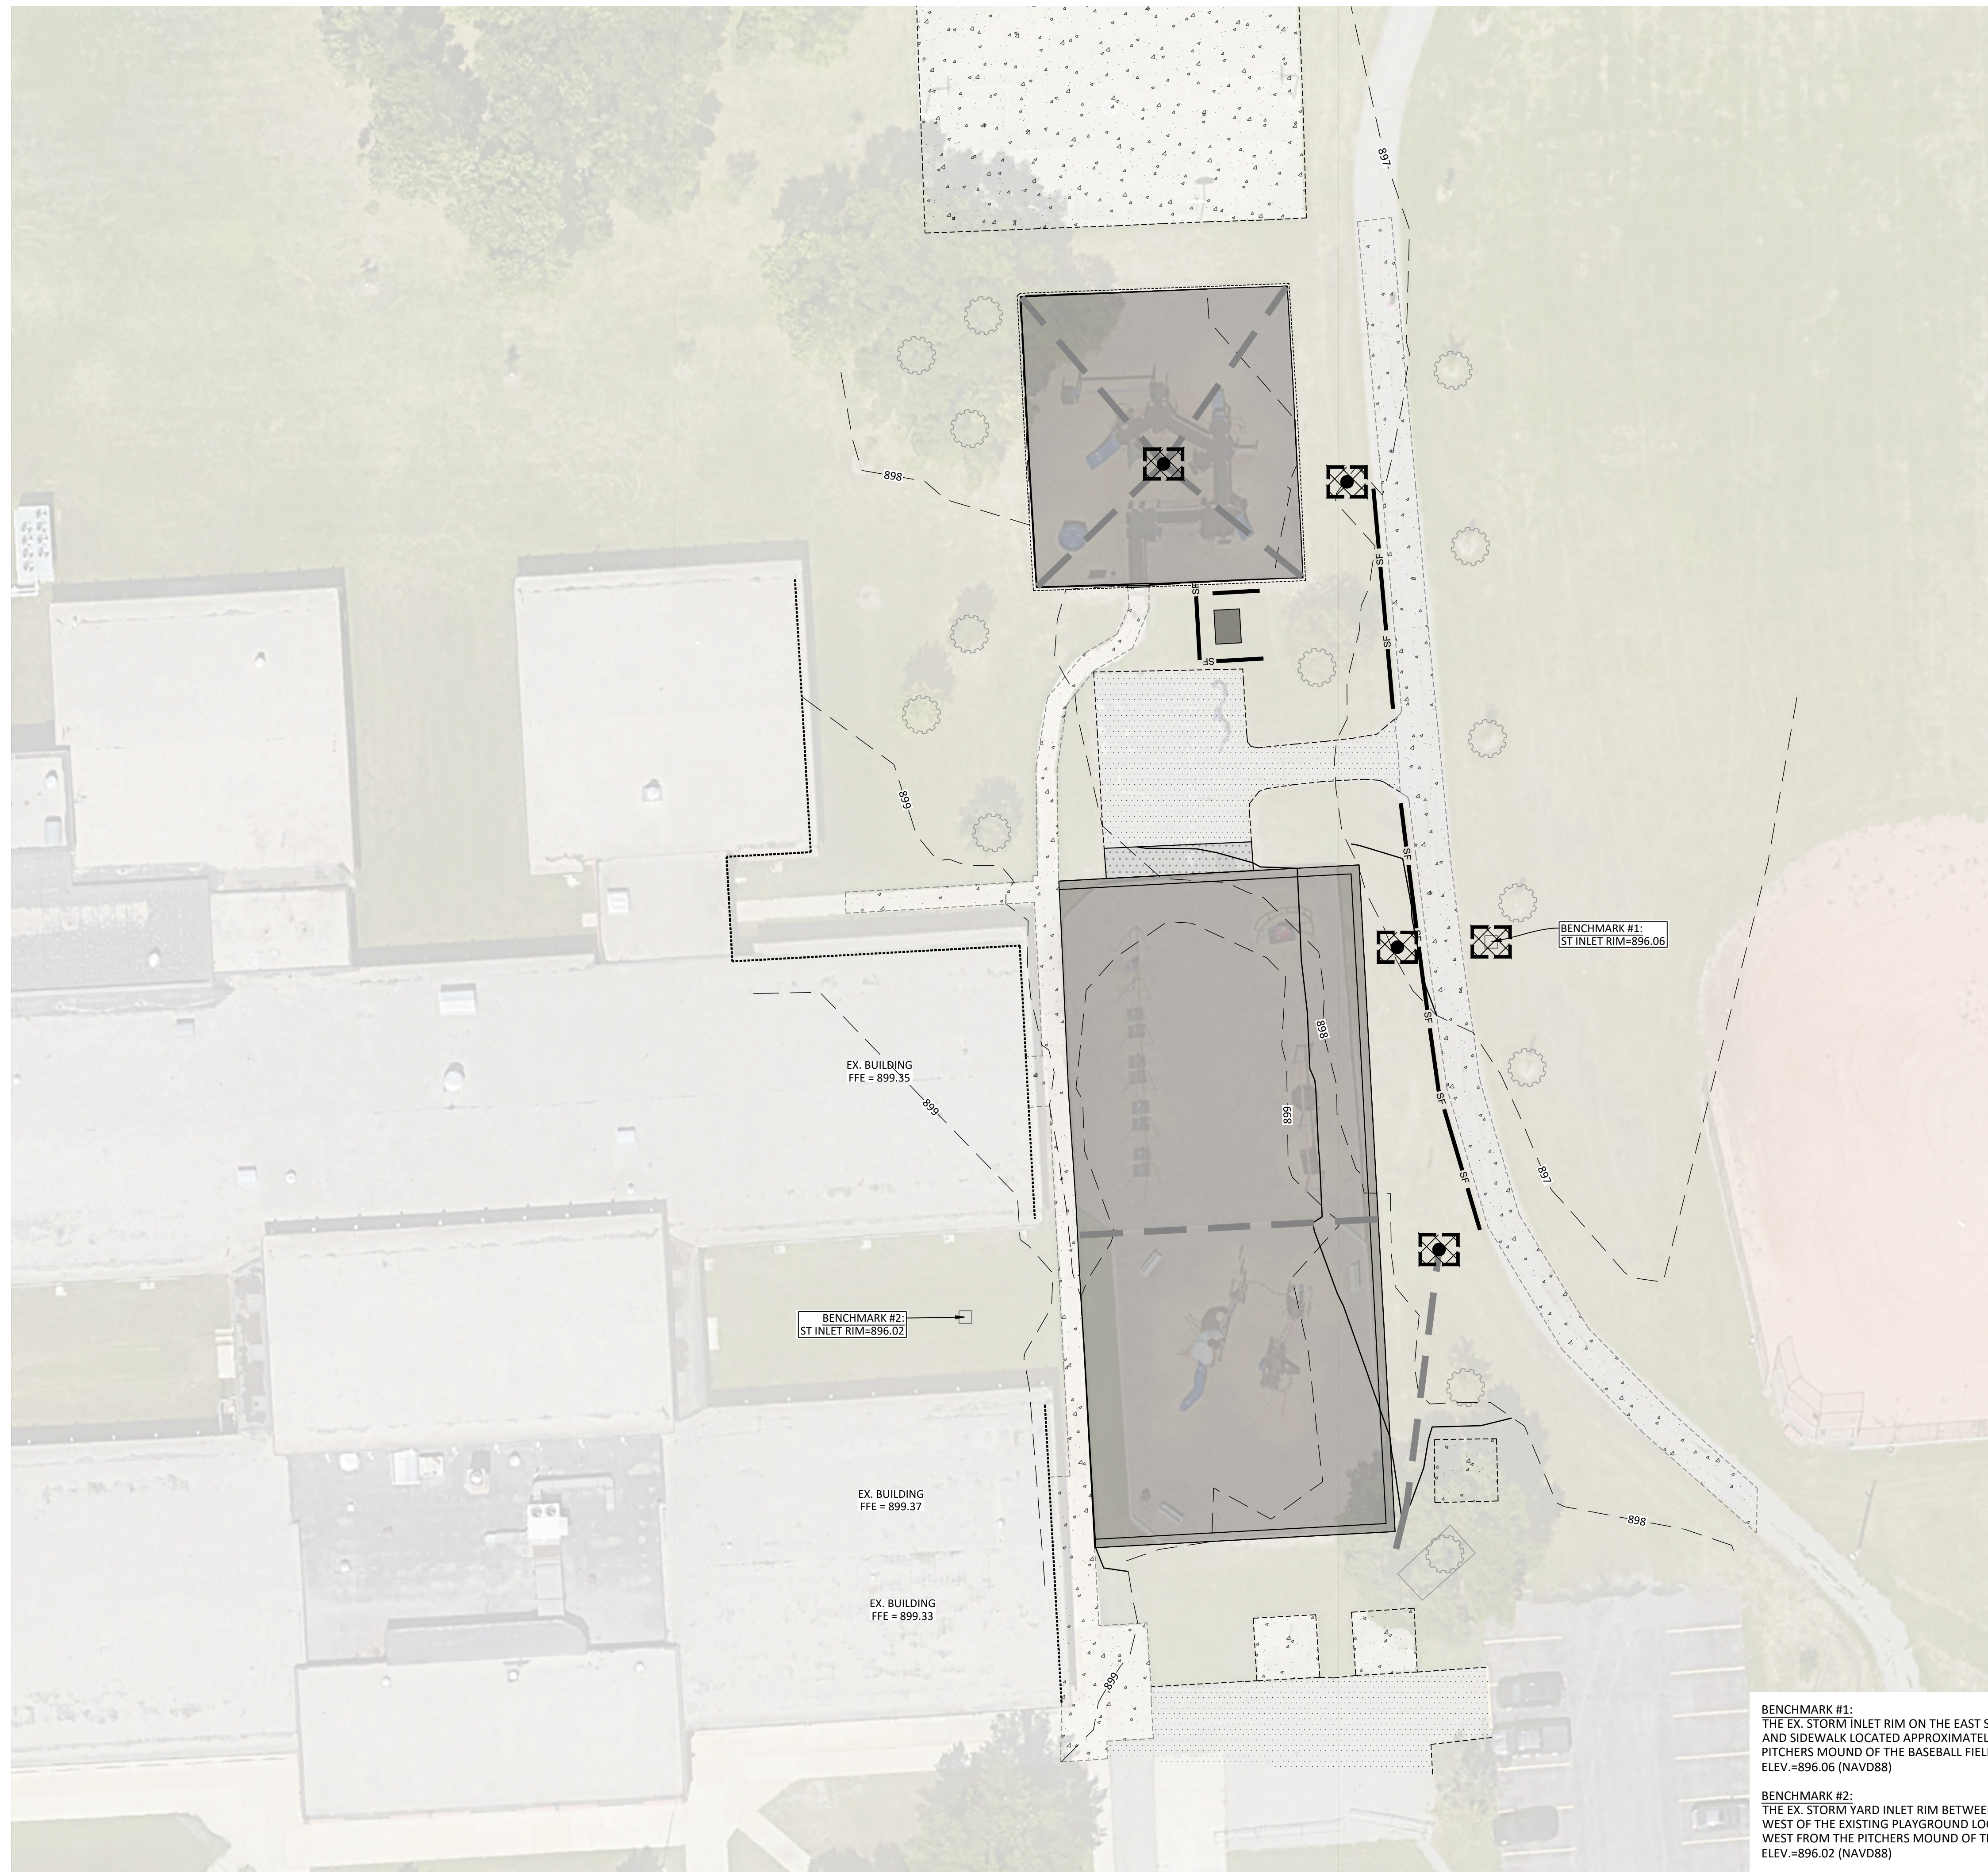

EROSION CONTROL LEGEND*			
— SF —	SILT FENCE	200	LF
	STANDARD INLET PROTECTION	5	EA
	CONCRETE WASHOUT	1	EA

* ALL BLACK DIRT/SEEDING/GRADING ADJACENT TO NEW CURBING AND PAVEMENT AREAS, FOR PIPE INSTALLATION AND ANY GRADING AS DESIGNATED IN THE PLANS, ARE INCIDENTAL TO THE PROJECT. WATERING THE SEEDING UNTIL IT IS FULLY ESTABLISHED IS INCIDENTAL TO THE PROJECT.

NOTES:

1. QUANTITIES ARE ENGINEERS ESTIMATES ONLY. CONTRACTOR SHALL DETERMINE THEIR OWN QUANTITIES AND BID ACCORDINGLY.
2. CONTRACTOR SHALL FOLLOW NDDOT STORMWATER POLLUTION PREVENTION STANDARDS FOR ALL EROSION CONTROL DURING CONSTRUCTION.
3. CONTRACTOR SHALL INSTALL PERIMETER EROSION AND SEDIMENT CONTROLS PRIOR TO ANY LAND DISTURBING ACTIVITY.
4. CONTRACTOR SHALL INSTALL EROSION CONTROL BLANKET PER MANUFACTURER'S SPECIFICATIONS.
5. IF CONCRETE WASHOUT WILL OCCUR ONSITE, CONTRACTOR SHALL COORDINATE LOCATION WITH OWNER AND ENGINEER.
6. INLET PROTECTION SHALL BE BY WIMCO OR ADS PRODUCTS, ERTEC, FLEXSTORM, OR APPROVED EQUAL AND INSTALLED PER MANUFACTURERS RECOMMENDATIONS.
7. CONTRACTOR IS RESPONSIBLE FOR SWEEPING AND CLEANING ADJACENT STREETS DURING CONSTRUCTION TO PREVENT SEDIMENT RUNOFF TO CITY STORM SYSTEM.
8. CONTRACTOR SHALL LEAVE TEMPORARY EROSION AND SEDIMENT CONTROL MEASURES IN PLACE UNTIL ALL DISTURBED AREAS ARE PERMANENTLY STABILIZED.
9. CONTRACTOR IS RESPONSIBLE FOR ALL INSTALLATION, MAINTENANCE, REPLACEMENT IF NECESSARY, REMOVAL, ETC OF ANY AND ALL PROTECTION MEASURES NEEDED FROM THE START OF CONSTRUCTION UNTIL FINAL PERMANENT STABILIZATION IS ACHIEVED.

BENCHMARK #1:
THE EX. STORM INLET RIM ON THE EAST SIDE OF THE EXISTING PLAYGROUND AND SIDEWALK LOCATED APPROXIMATELY 127 FEET NORTH WEST FROM THE PITCHERS MOUND OF THE BASEBALL FIELD.
ELEV.=896.06 (NAVD88)

BENCHMARK #2:
THE EX. STORM YARD INLET RIM BETWEEN THE TWO BUILDINGS TO THE WEST OF THE EXISTING PLAYGROUND LOCATED APPROXIMATELY 231 FEET WEST FROM THE PITCHERS MOUND OF THE BASEBALL FIELD.
ELEV.=896.02 (NAVD88)

BASIS OF BEARING: CITY OF FARGO COORDINATE SYSTEM (NAD83)



CALL BEFORE YOU DIG
NORTH DAKOTA
 UTILITIES UNDERGROUND LOCATION SERVICE
 1-800-795-0555




FARGO PUBLIC SCHOOLS
LONGFELLOW ELEMENTARY
20 29TH AVE NE
FARGO, ND 58102

MECHANICAL
MARTIN MECHANICAL DESIGN
1201 25TH AVE N
FARGO, ND 58102
(701) 233.7957 OFFICE

ELECTRICAL
CMTA
2201 12TH ST N STE E
FARGO, ND 58102
(701) 280.0500 OFFICE

CIVIL
LOWRY ENGINEERING
5306 51ST AVE S STE A
FARGO, ND 58104
(701) 235.0199 OFFICE

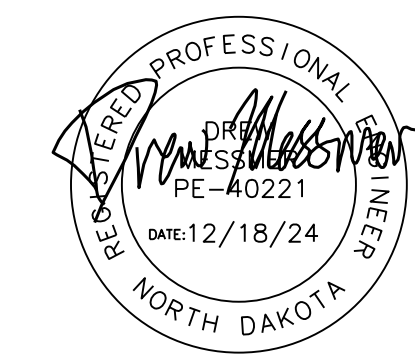

DRAWING HISTORY		
NO.	DESCRIPTION	DATE
1	ADDENDUM #1	12/30/24

DRAWN BY: JT / KD JN: 24-060

EROSION & SEDIMENT CONTROL PLAN
LONGFELLOW

SHEET
LO-C6




FARGO PUBLIC SCHOOLS
LONGFELLOW ELEMENTARY
20 29TH AVE NE
FARGO, ND 58102

MECHANICAL
MARTIN MECHANICAL DESIGN
1201 25TH AVE N
FARGO, ND 58102
(701) 293.7957 OFFICE

ELECTRICAL
CMTA
2201 12TH ST N STE E
FARGO, ND 58102
(701) 280.0500 OFFICE

CIVIL
LOWRY ENGINEERING
5306 51ST AVE S STE A
FARGO, ND 58104
(701) 235.0199 OFFICE

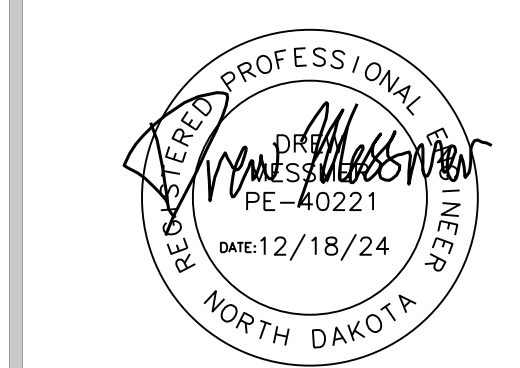


DRAWING HISTORY

NO.	DESCRIPTION	DATE
1	ADDENDUM #1	12/30/24

SECTION NO. 2300	DRAWING NO. 5.1
REV. 2013	
SIDEWALK & CURB RAMP DETAIL (4.5')	
CITY OF FARGO ENGINEERING DEPARTMENT	
APPROVED <i>[Signature]</i>	DATE 1-2-13


DRAWN BY: JT / KD JN: 24-060
DETAILS LONGFELLOW

SHEET
LO-C7

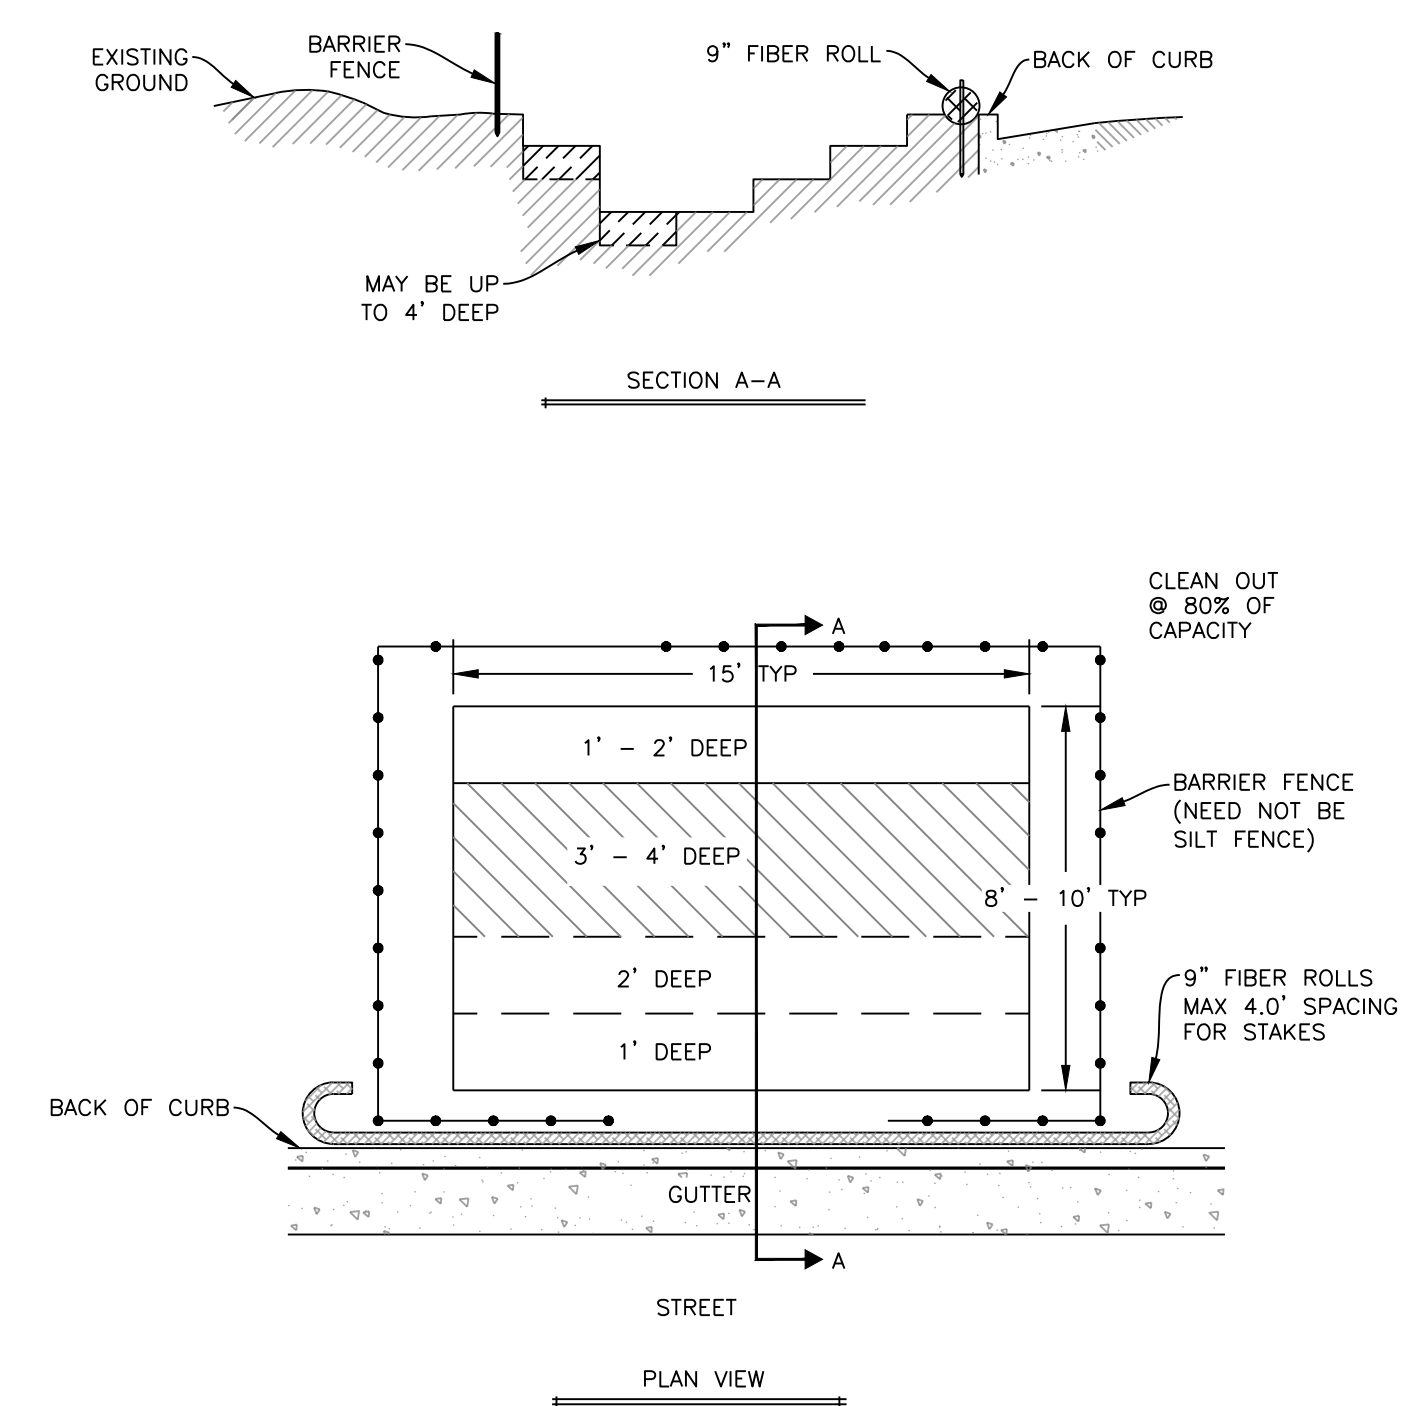


NOTE:
1. CONCRETE WASH OUT IS NOT REQUIRED IF CONTRACTOR IS PERFORMING WASHOUT ACTIVITIES OFF-SITE IN A LEGAL AND APPROPRIATE MANNER.

1 CONCRETE WASHOUT
N.T.S.

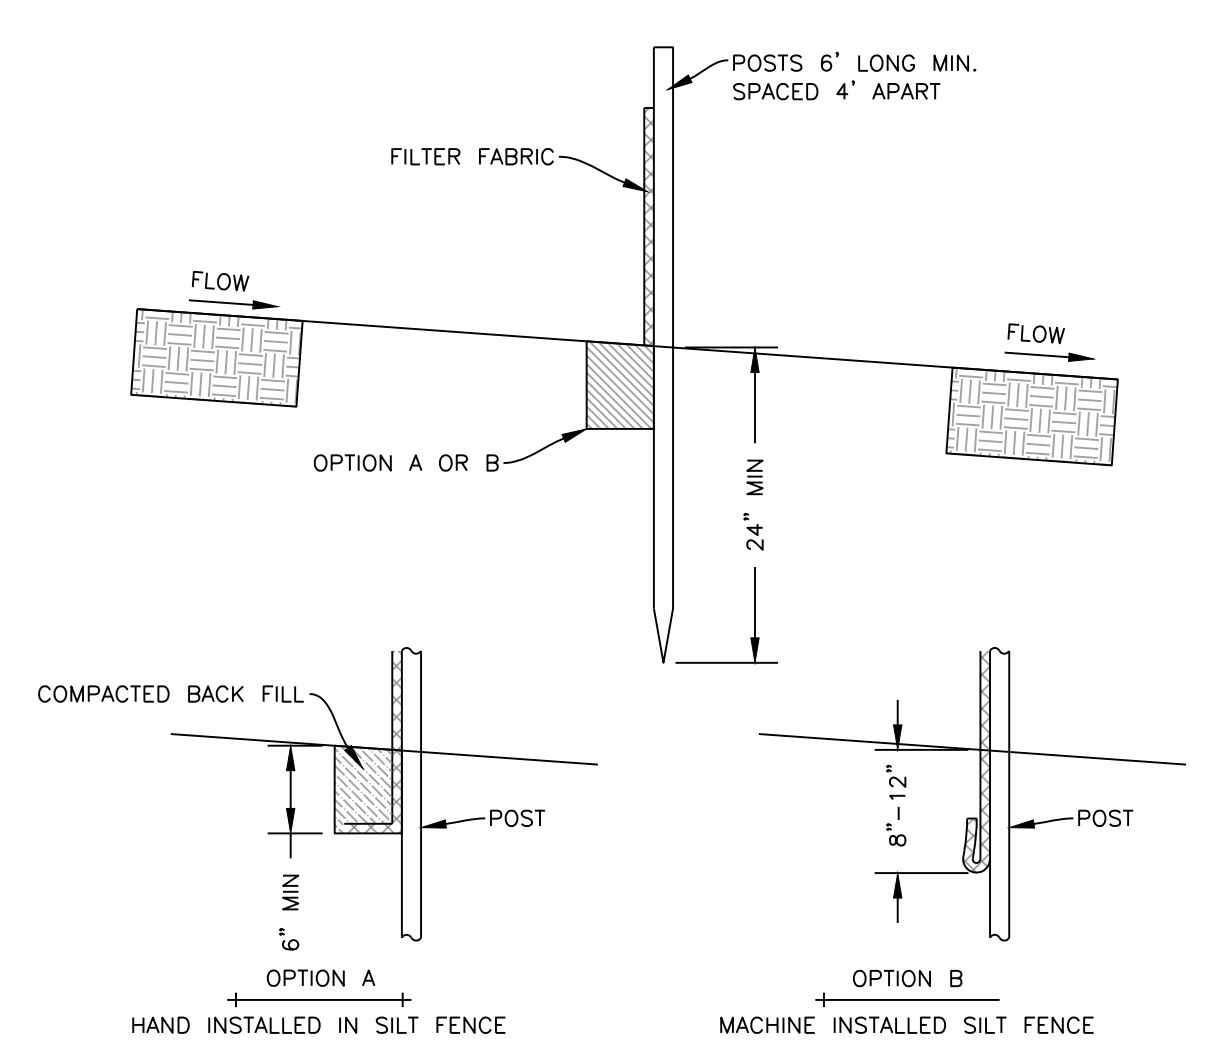


NOTES:
1. POSTS SHALL BE 2 INCH DIAMETER ROUND WOOD, 1.5 INCH RECTANGULAR WOOD, OR STEEL WITH A MINIMUM OF 0.95 POUNDS PER FOOT AND HAVE PROJECTIONS FOR FASTENING WIRE OR FABRIC.
2. FILTER FABRIC SHALL BE AS SPECIFIED IN AASHTO M 288 WITH A MINIMUM WIDTH OF 36 INCHES.
3. SILT FENCE SHALL BE INSTALLED ALONG THE CONTOURS OF THE SITE SO WATER CANNOT FLOW AROUND THE END OF THE FENCE.
4. IF JOINING TWO SECTION OF FILTER FABRIC, OVERLAP AT SUPPORT POSTS A MINIMUM OF 18 INCHES IN SUCH A MANNER THAT PREVENTS SILT FROM PASSING THROUGH THE FENCE.
5. REMOVE SEDIMENT FROM SILT FENCE WHEN IT REACHES 1/3 OF THE EXPOSED HEIGHT OF ANY SECTION, OR AS DIRECTED BY THE ENGINEER. THE ENGINEER MAY DIRECT THE INSTALLATION OF ADDITIONAL SILT FENCE IF REMOVING THE SEDIMENT DEPOSIT IS NOT FEASIBLE.
6. SILT FENCE SHALL BE INSPECTED EVERY 14 CALENDAR DAYS AND WITHIN 24 HOURS OF ANY STORM EVENT GREATER THAN 1" OF RAIN PER 24 HOUR PERIOD.

2 SILT FENCE INSTALLATION
N.T.S.

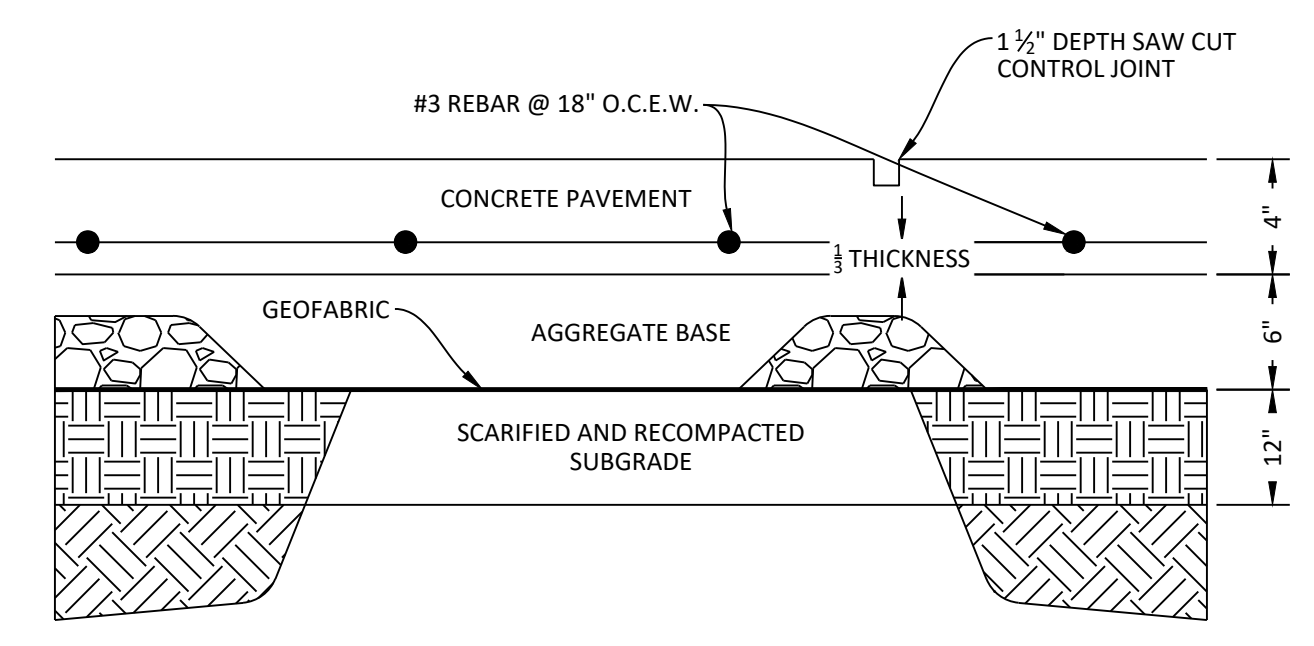


NOTES:
1. PROVIDE SAWCUT CONTROL JOINTS AT 8' MAXIMUM SPACING EACH WAY.
2. PROVIDE #3 REBAR @ 18" O.C. AT CONNECTION TO CURB & GUTTER, THICKENED EDGE SIDEWALK, EXISTING CONCRETE, AND CONSTRUCTION JOINTS.
3. PROVIDE 1/2" EXPANSION MATERIAL ADJACENT TO BUILDINGS AND ANY OTHER FIXED OBJECTS SUCH AS LIGHT POLE BASES, SIGN FOUNDATIONS, ETC. AND AT CONNECTIONS TO EXISTING CONCRETE.
4. NDDOT TYPE R1 FABRIC SHALL BE PLACED UNDER AGGREGATE BASE PER NDDOT SPECIFICATIONS.
5. REBAR SHALL BE SUPPORTED BY CHAIRS.
6. **NO CONCRETE CURING COMPOUND SHALL BE APPLIED ON THE EXTERIOR PLAYGROUND CONCRETE SURFACES.**


3 PLAYGROUND SURFACE PAD REINFORCED CONCRETE CROSS SECTION
N.T.S.

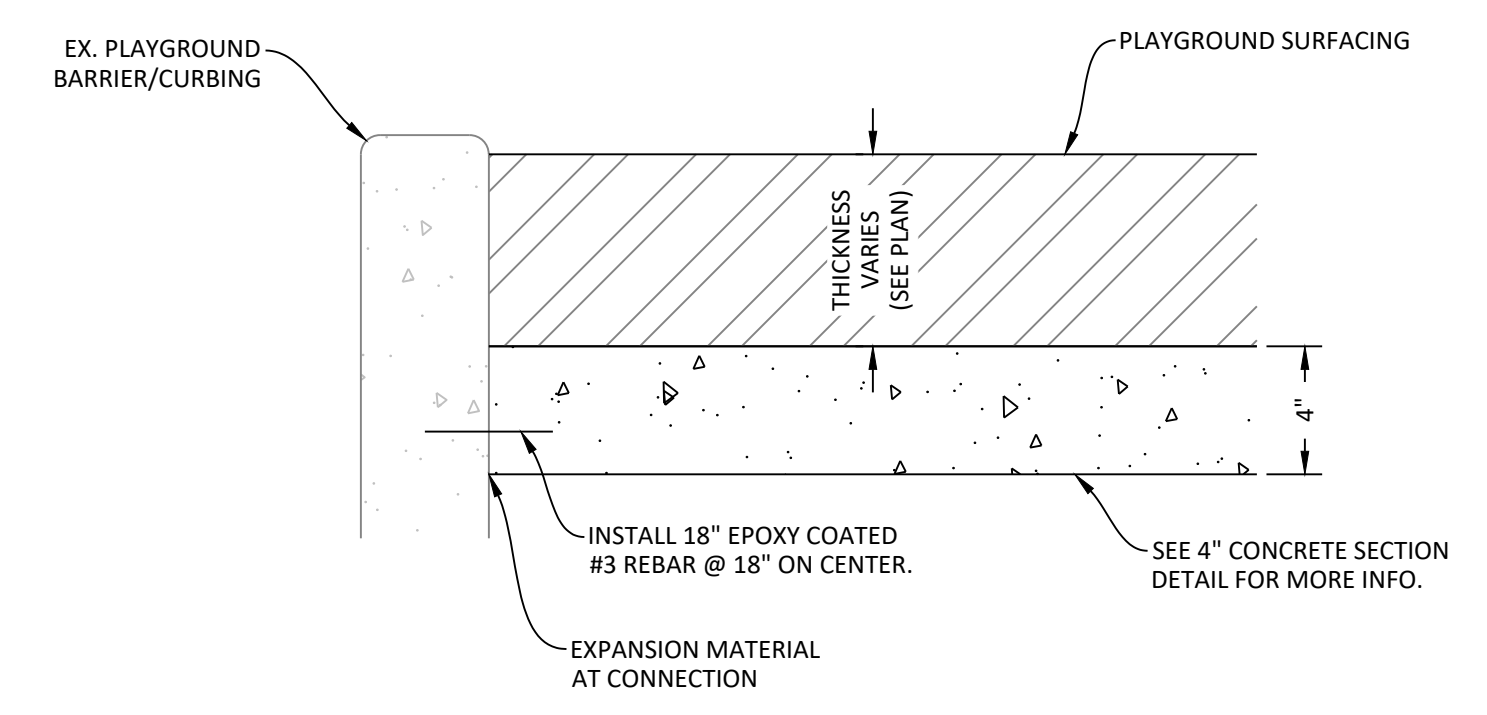

4 PLAYGROUND SURFACE PERIMETER DETAIL (BASE BID AREA)
N.T.S.

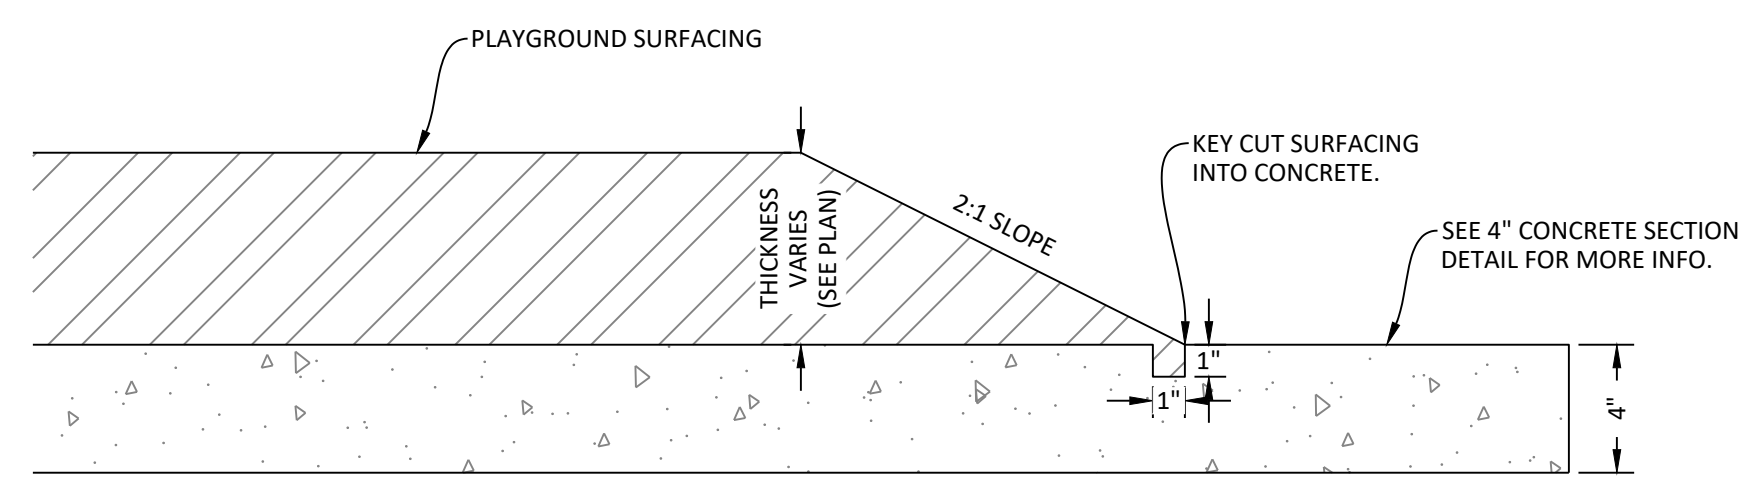


5 PLAYGROUND SURFACE PERIMETER DETAIL (ALT-1 AREAS)
N.T.S.

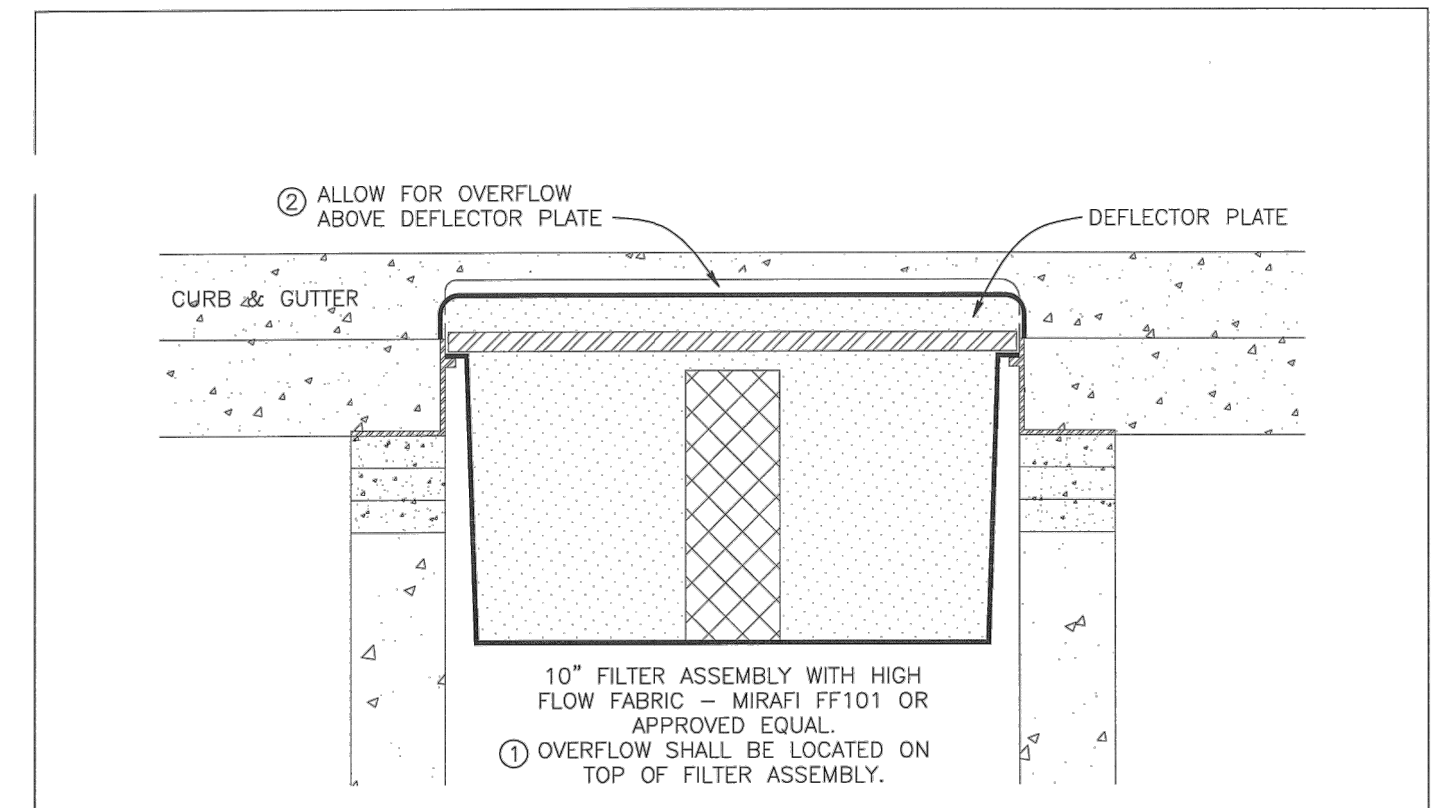


INSTALLATION:
- REMOVE THE INLET GRATE
- INSERT THE DEVICE INTO THE CASTING FRAME
- INSTALL GRATE INTO CASTING FRAME OVER TOP OF DEVICE

MAINTENANCE:
- CHECK REGULARLY & AFTER RAIN EVENTS. IF THE DEVICE IS FILLED WITH 1/3 OF ITS CAPACITY WITH SEDIMENT, EMPTY THE DEVICE.
- REMOVE DEBRIS AROUND THE INLET GRATE PRIOR TO REMOVING DEVICE

SECTION NO. 3300 | DRAWING NO. 6.4
REV.D. 2012
STORM SEWER INLET PROTECTION: TYPE C
CITY OF FARGO ENGINEERING DEPARTMENT
APPROVED *[Signature]* DATE 2-21-2012

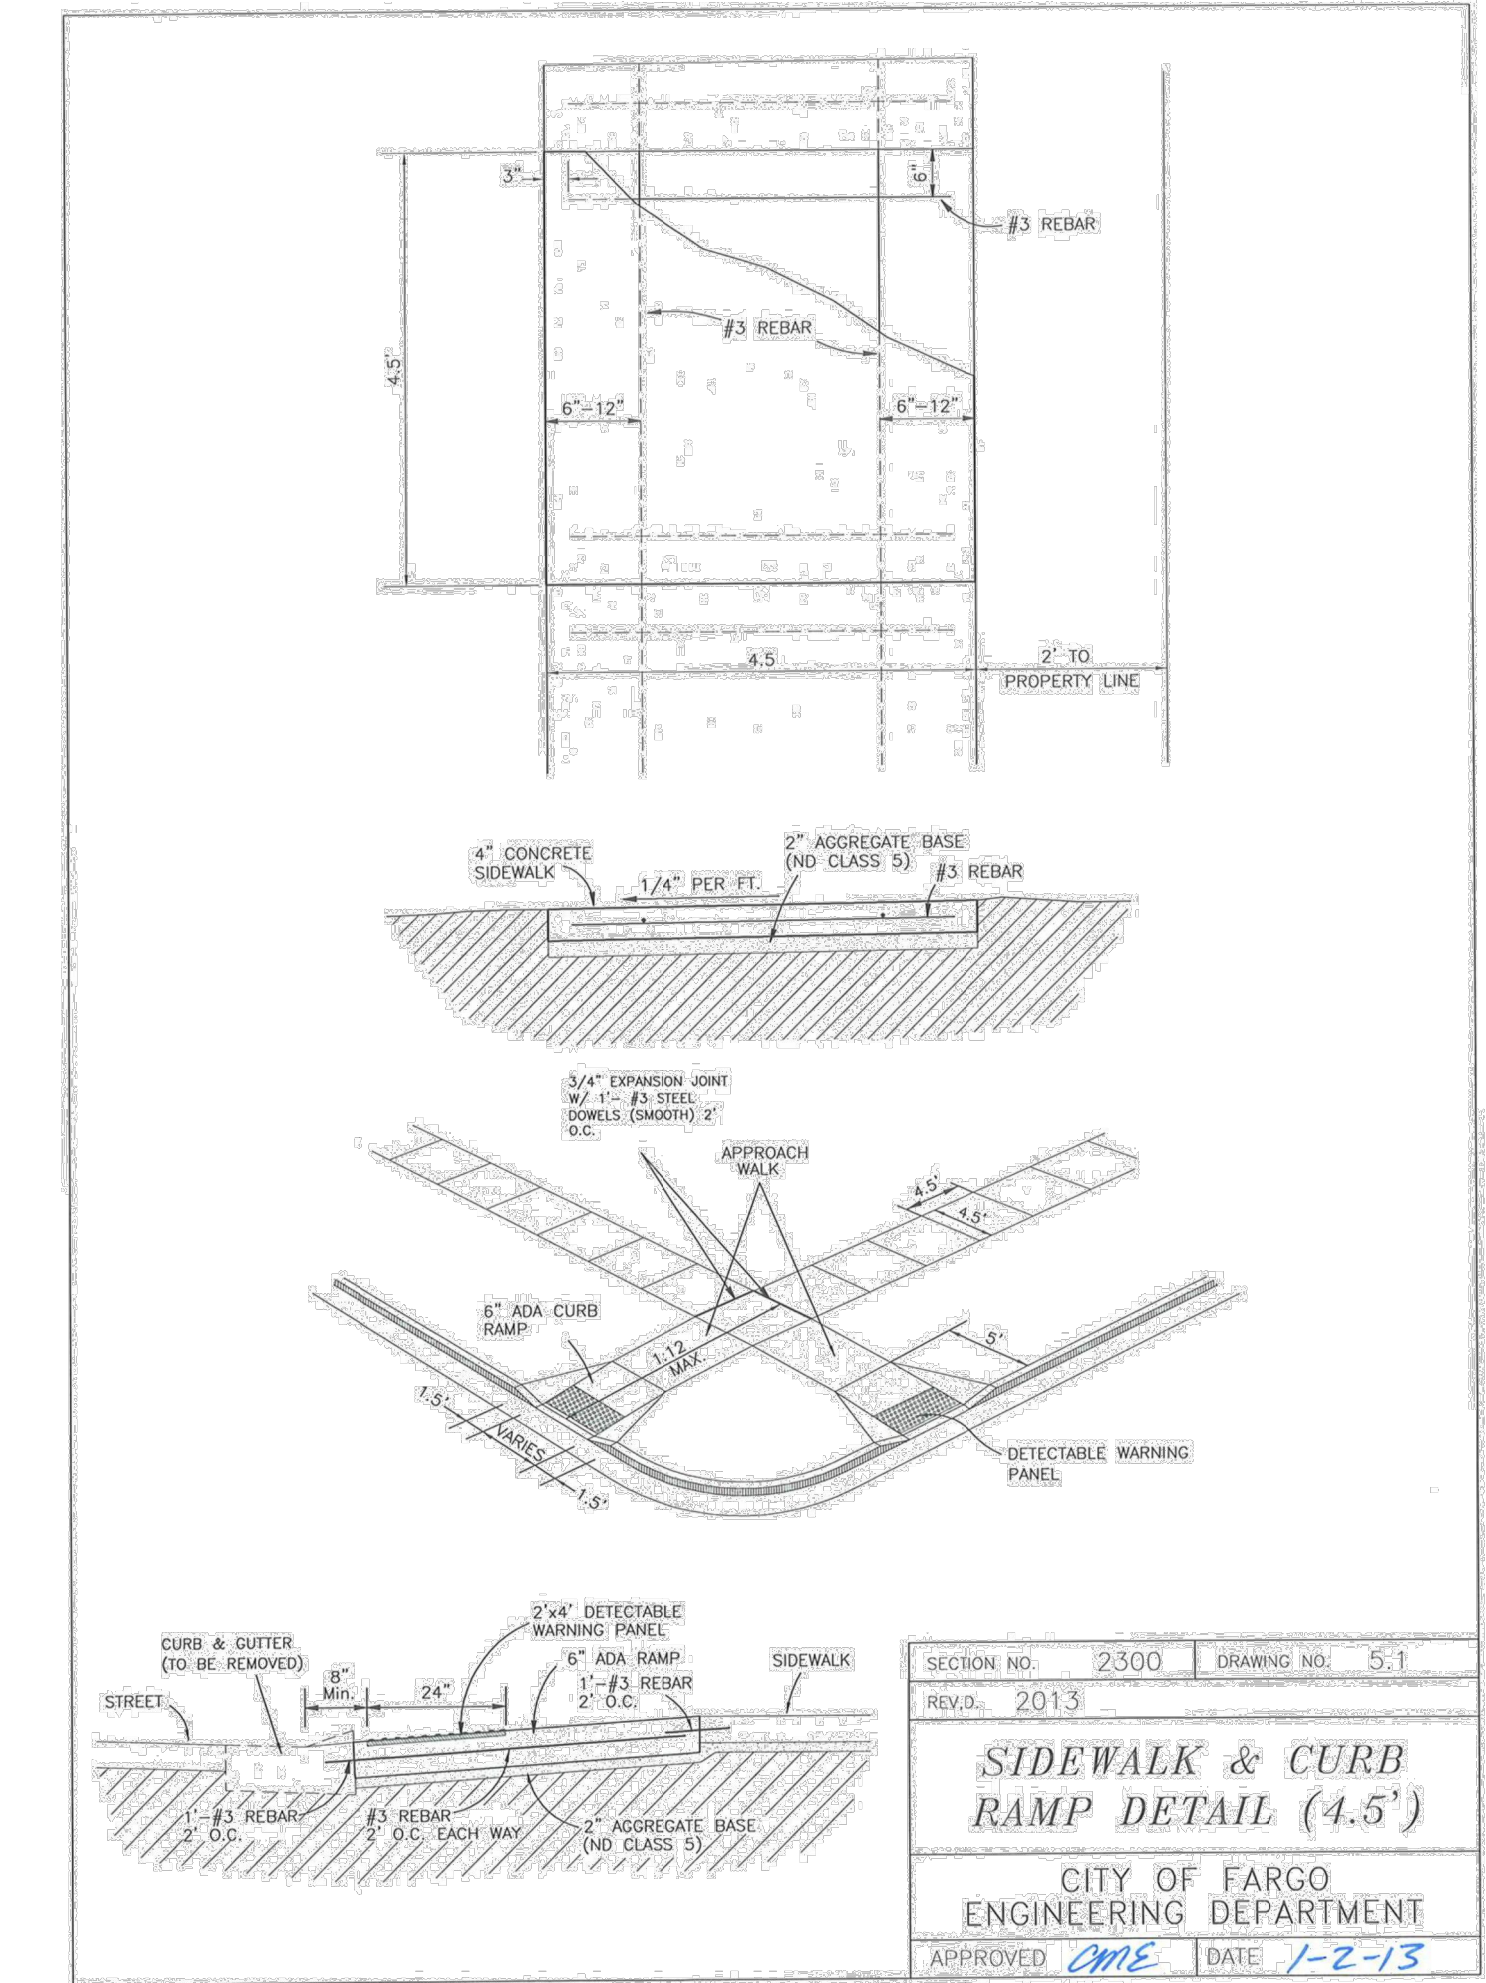


SECTION NO. 2300 | DRAWING NO. 5.1
REV. 2013
SIDEWALK & CURB RAMP DETAIL (4.5')
CITY OF FARGO ENGINEERING DEPARTMENT
APPROVED *[Signature]* DATE 1-2-13

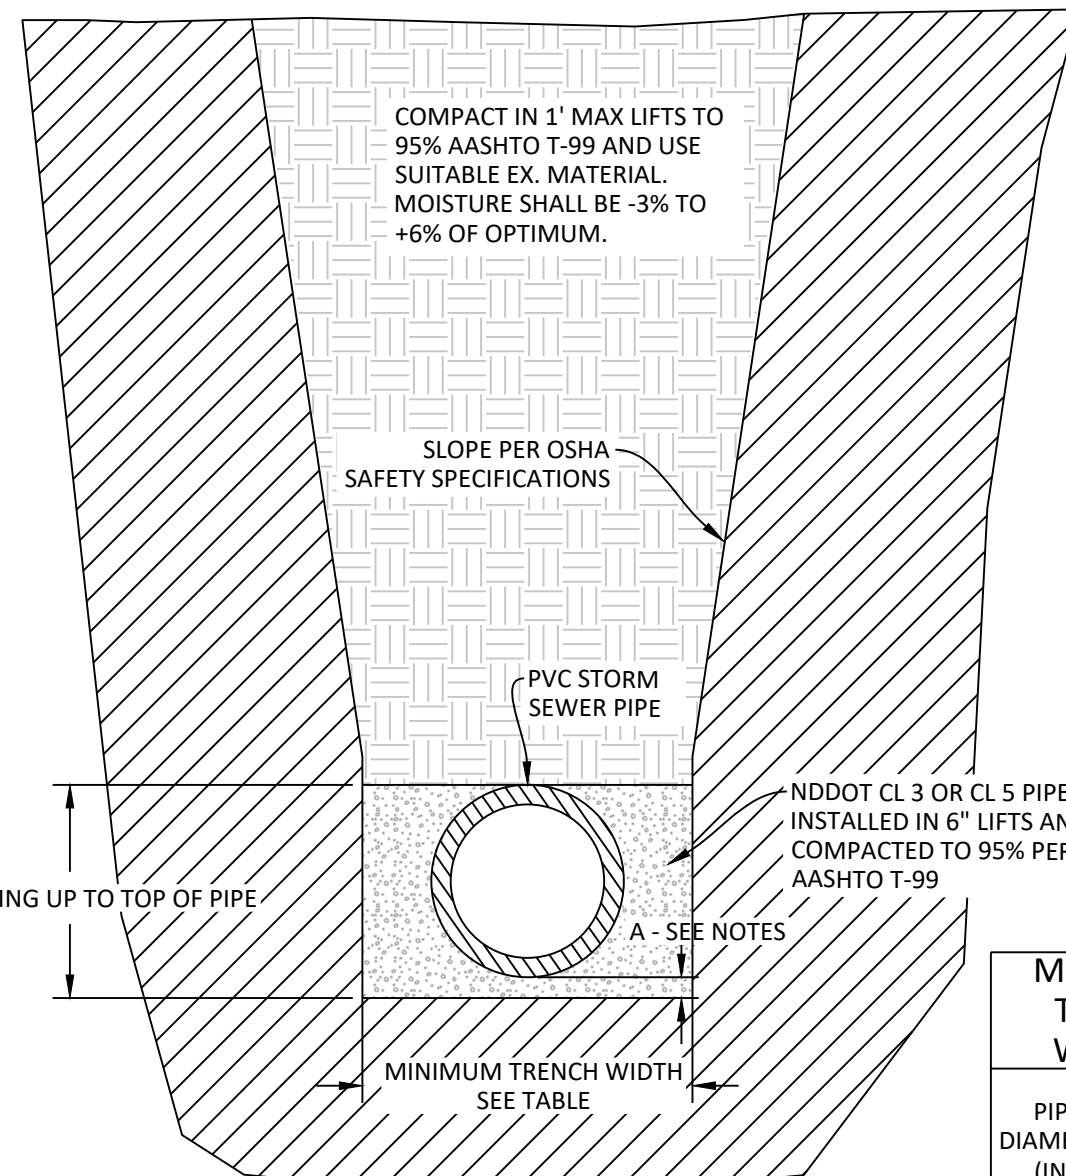

MINIMUM TRENCH WIDTHS	
PIPE DIAMETER (IN.)	MIN. TRENCH WIDTH (IN.)
4	21
6	23
8	26
10	28
12	30
15	34
18	39
24	47
30	56
36	63
42	72
48	80
60	96


- NOTES:
- BEDDING DEPTH BELOW PIPE (DIMENSION A ABOVE) SHALL BE 4" FOR 4"-36" PIPE AND 6" FOR 42"-60" PIPE.
 - IN CLAY SOILS, LAST 3' OF PIPE MEASURED FROM BACK OF FLARED END SECTION TO BE BEDDED IN CLAY AND NOT CLASS 5 OR CLASS 3 TO PREVENT SCOUR.

1 PVC STORM PIPE & CULVERT TRENCH BACKFILL
N.T.S.

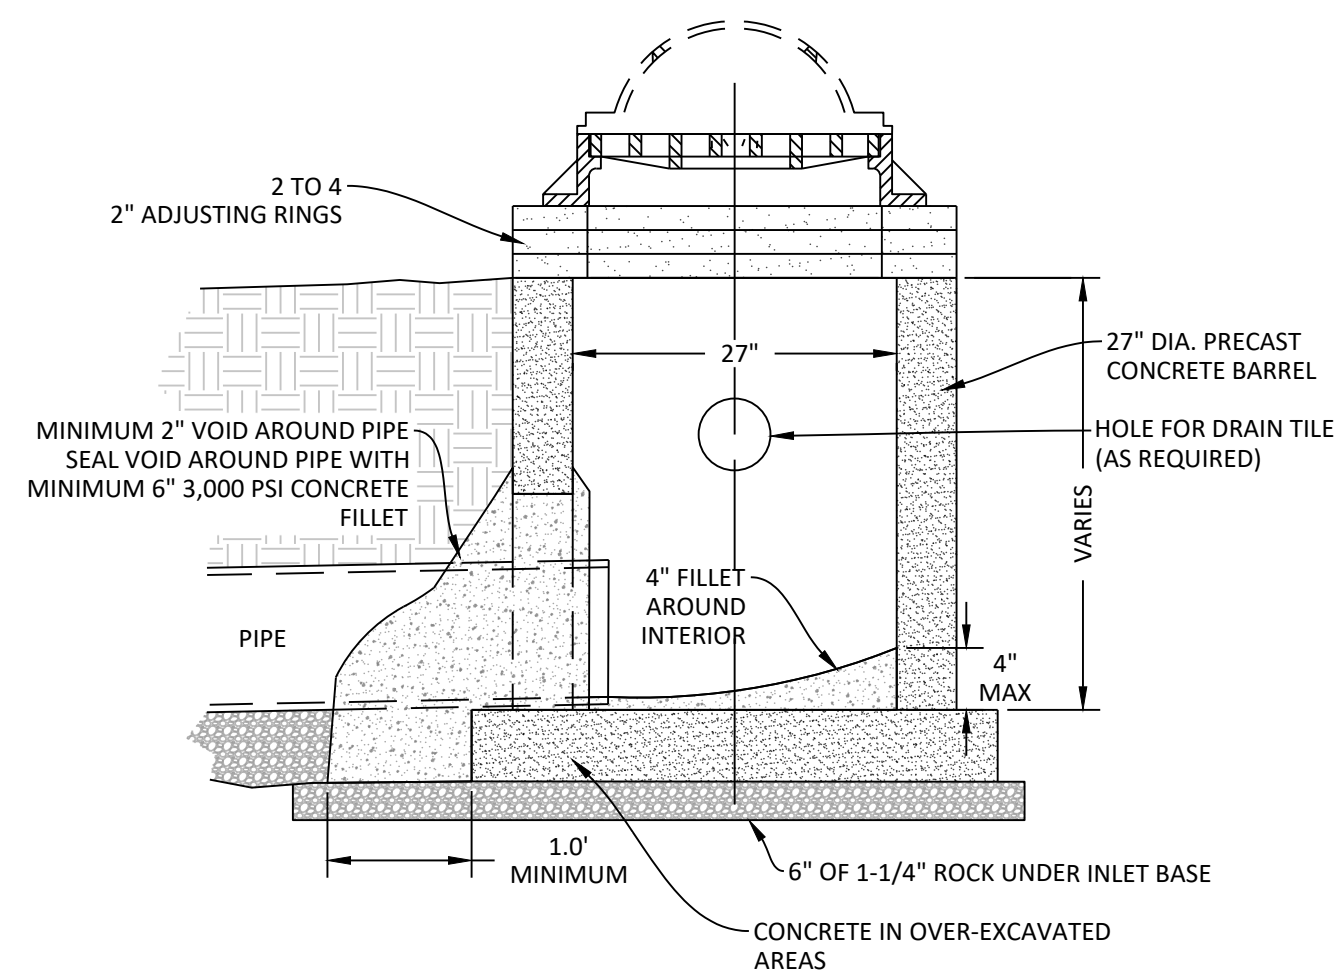

- NOTES:
- ALL ROUND MANHOLES SHALL MEET REQUIREMENTS OF ASTM C478.
 - LIFT HOLES TO BE MANUFACTURED WATER PROOF.
 - BACKFILL AROUND MANHOLE IN 1' MAX LIFTS TO 95% PER AASHTO T-99. USE EXISTING MATERIAL UNLESS NOTED OTHERWISE. MOISTURE SHALL BE -3% TO +6% OF OPTIMUM.
 - CASTING TYPE PER MANHOLE SCHEDULE.
 - CONTRACTOR MAY USE CONCRETE OR HDPE RINGS. IF HDPE RINGS ARE UTILIZED, SILICONE SEAL SHALL BE USED IN BETWEEN RINGS PER MANUFACTURER RECOMMENDATIONS. IF CONCRETE RINGS ARE USED, GROUT SHALL BE USED BETWEEN, OUTSIDE, AND INSIDE OF RINGS. GROUT SHALL MEET REQUIREMENTS OF ASTM C270.
 - REBAR AND WALL THICKNESS PER MANUFACTURERS RECOMMENDATION.
 - IF MANHOLE IS USED AS A CURB & GUTTER INLET, THE MANHOLE SHALL HAVE HOLE AVAILABLE FOR CONNECTION TO CURB & GUTTER DRAIN TILE AS REQUIRED.
 - BUTYL RUBBER GASKET ON ALL JOINTS. GASKET SHALL MEET ASTM C443 REQUIREMENTS.
 - DOGHOUSE TO BE CONCRETED INSIDE AND OUT WITH 3,000 PSI CONCRETE. CONCRETE SHALL BE VIBRATED AND TROWL FINISHED.
 - WHEN STRUCTURE IS INSTALLED IN THE CURB LINE, THE CONTRACTOR SHALL SET MANHOLE SO THAT BACK OF CASTING ALIGNS WITH CURB FLOW LINE.
 - (CLAY SOILS ONLY) IF IN PAVEMENT, STRUCTURE SHALL HAVE A MINIMUM HEIGHT OF SIX (6) FEET FROM RIM TO BOTTOM OF STRUCTURE. IF LOWEST INVERT IS ABOVE THIS, CONTRACTOR SHALL FILL BOTTOM VOID WITH 4,000 PSI CONCRETE AND FORM INVERTS ACCORDINGLY.

2 27" PAVEMENT/YARD INLET
N.T.S.

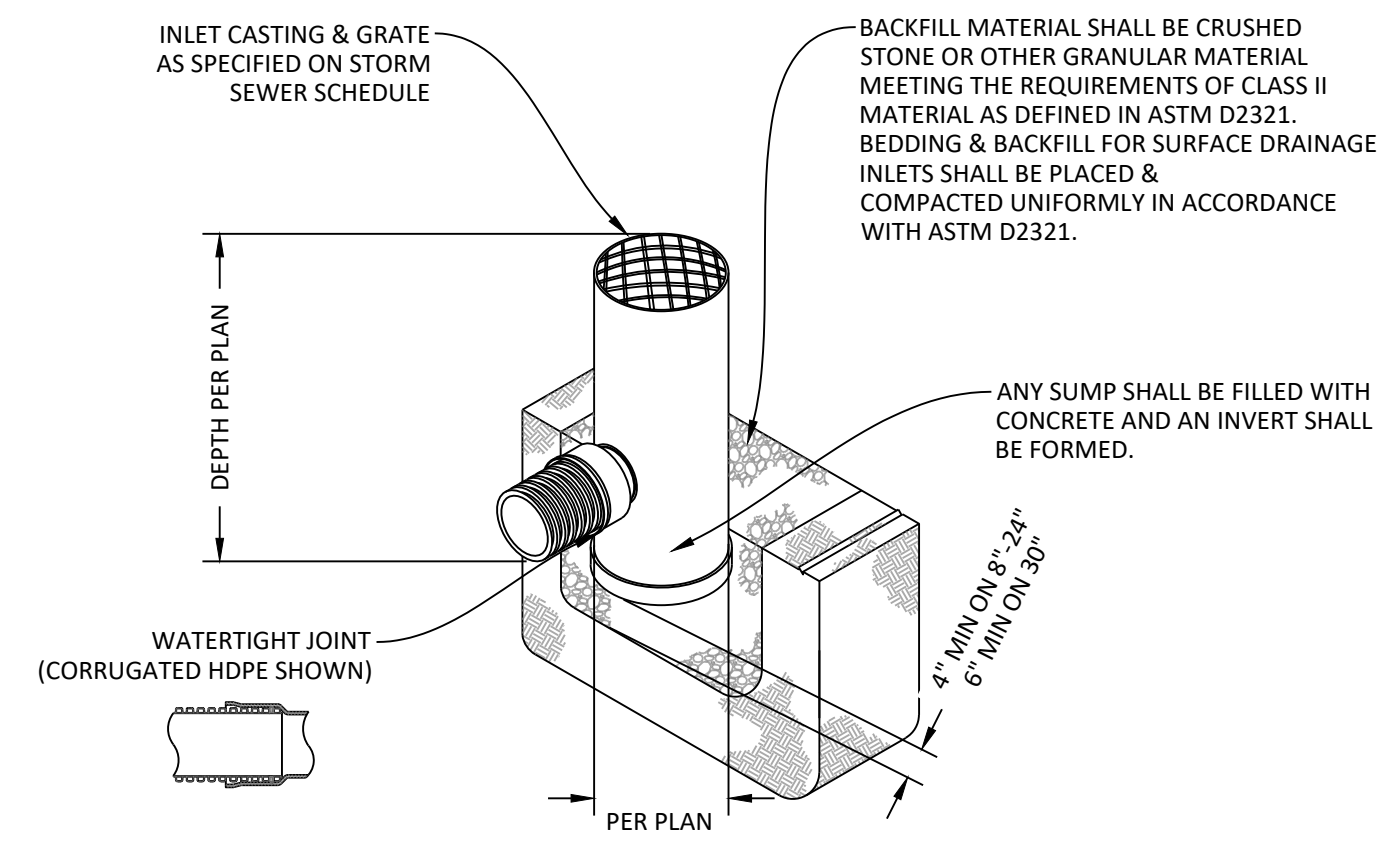

- NOTES:
- CONTRACTOR SHALL CONTACT MANUFACTURER (ADS) FOR CORRECT SIZING OF STRUCTURES AND FOR INSTALLATION INSTRUCTIONS AND RECOMMENDATIONS.

3 NYLOPLAST HDPE YARD INLET
N.T.S.



FARGO PUBLIC SCHOOLS
LONGFELLOW ELEMENTARY
20 29TH AVE NE
FARGO, ND 58102

MECHANICAL
MARTIN MECHANICAL DESIGN
1201 25TH AVE N
FARGO, ND 58102
(701) 233.7957 OFFICE

ELECTRICAL
CMTA
2201 12TH ST N STE E
FARGO, ND 58102
(701) 280.0500 OFFICE

CIVIL
LOWRY ENGINEERING
5306 51ST AVE S STE A
FARGO, ND 58104
(701) 235.0199 OFFICE



DRAWING HISTORY

NO.	DESCRIPTION	DATE
1	ADDENDUM #1	12/30/24

DRAWN BY: JT / KD JN: 24-060

DETAILS
LONGFELLOW

SHEET
LO-C8

LIST OF ABBREVIATIONS

Table with 2 columns: ABBREVIATION, DESCRIPTION. Includes entries like ACM - NON COMBUSTIBLE, ADA - AMERICANS DISABILITIES ACT, etc.


LIST OF ABBREVIATIONS

Table with 2 columns: ABBREVIATION, DESCRIPTION. Includes entries like NC - NON COMBUSTIBLE, NOM - NOMINAL, etc.


GENERAL NOTES

- PROJECT GENERAL NOTES DESCRIPTION
1. NOTIFY ARCHITECT PROMPTLY IF ANY CONDITIONS CONFLICT WITH THE CONSTRUCTION DOCUMENTS
2. FIELD VERIFY ALL EXISTING CONDITIONS AND DIMENSIONS PRIOR TO FABRICATION/CONSTRUCTION
3. CONTRACTORS TO VERIFY ALL EXISTING CONDITIONS, VISIT SITE AND FAMILIARIZE THEMSELVES WITH ALL EXISTING CONDITIONS.

SYMBOLS LEGEND

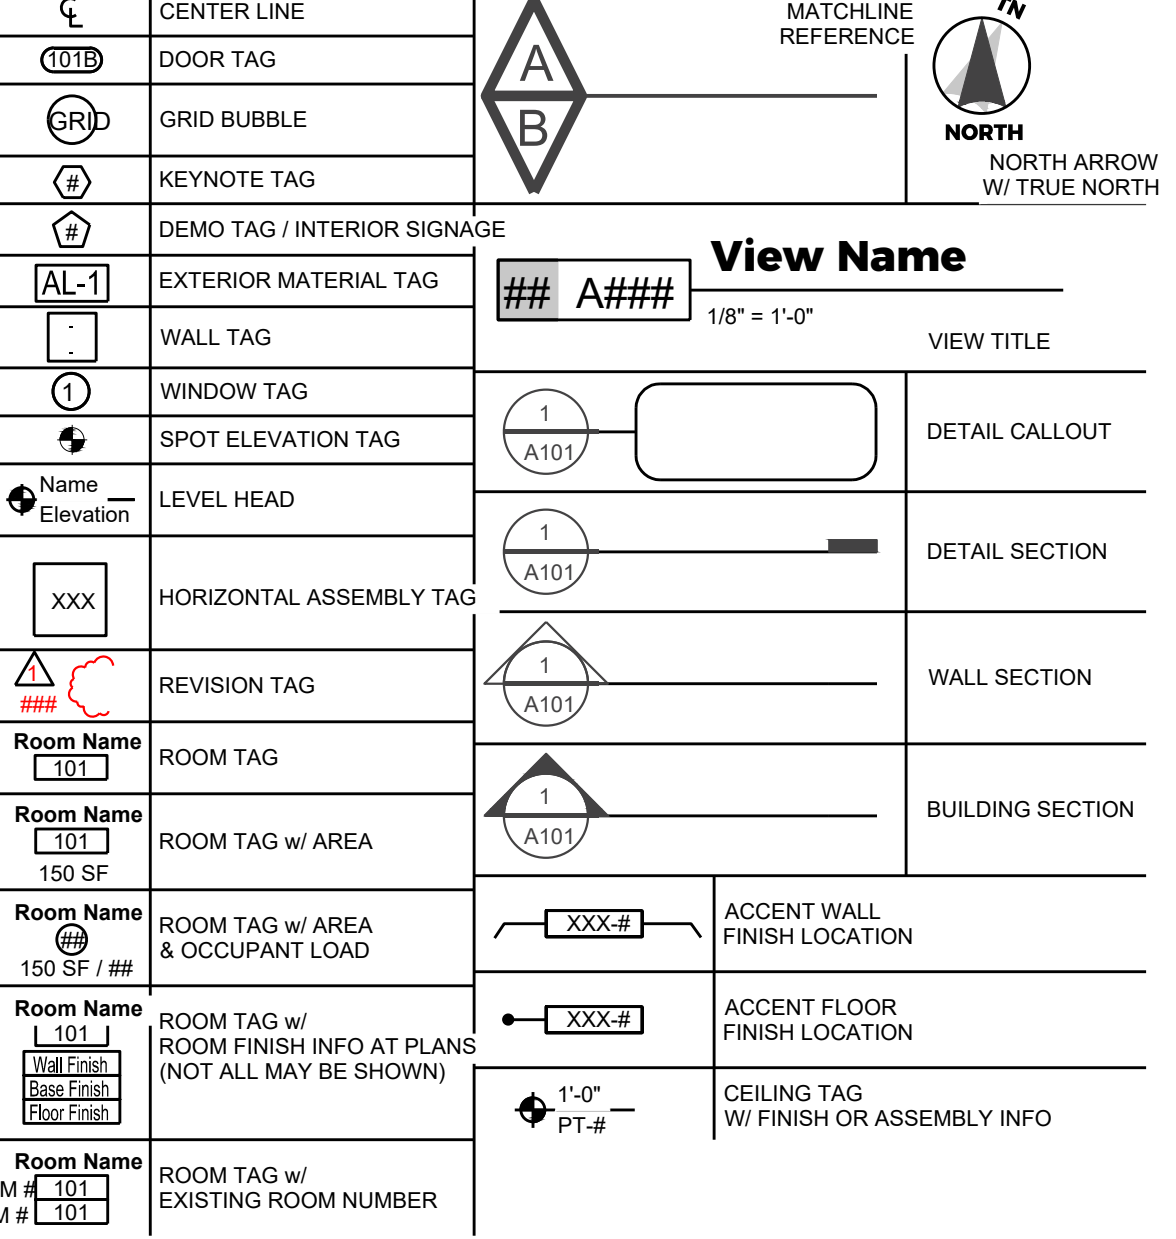


MATERIAL LEGEND

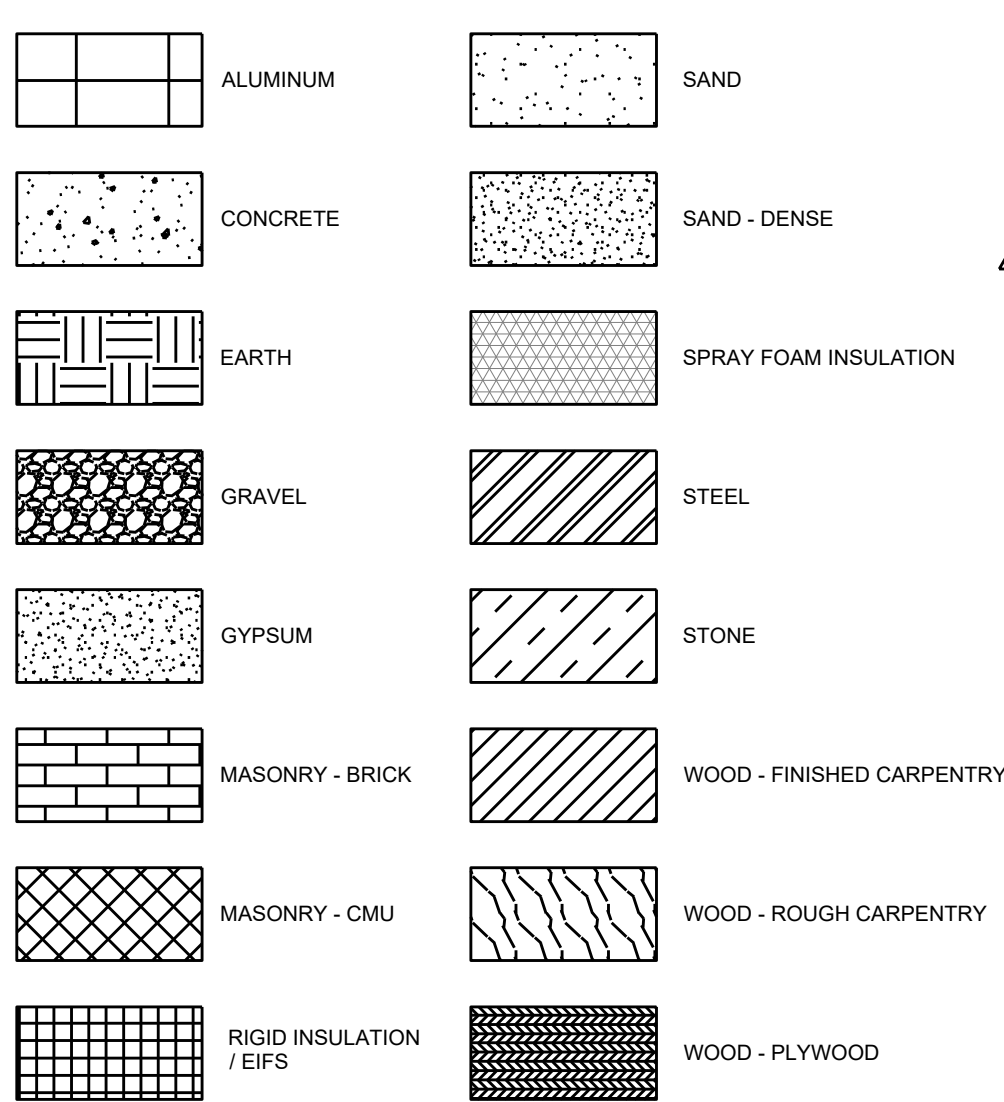


DRAWING INDEX

Table listing drawing sheets and their descriptions, organized by school type (Elementary, Middle, High) and sheet number.

EXTERIOR WALL TYPE TAG DESCRIPTION LEGEND

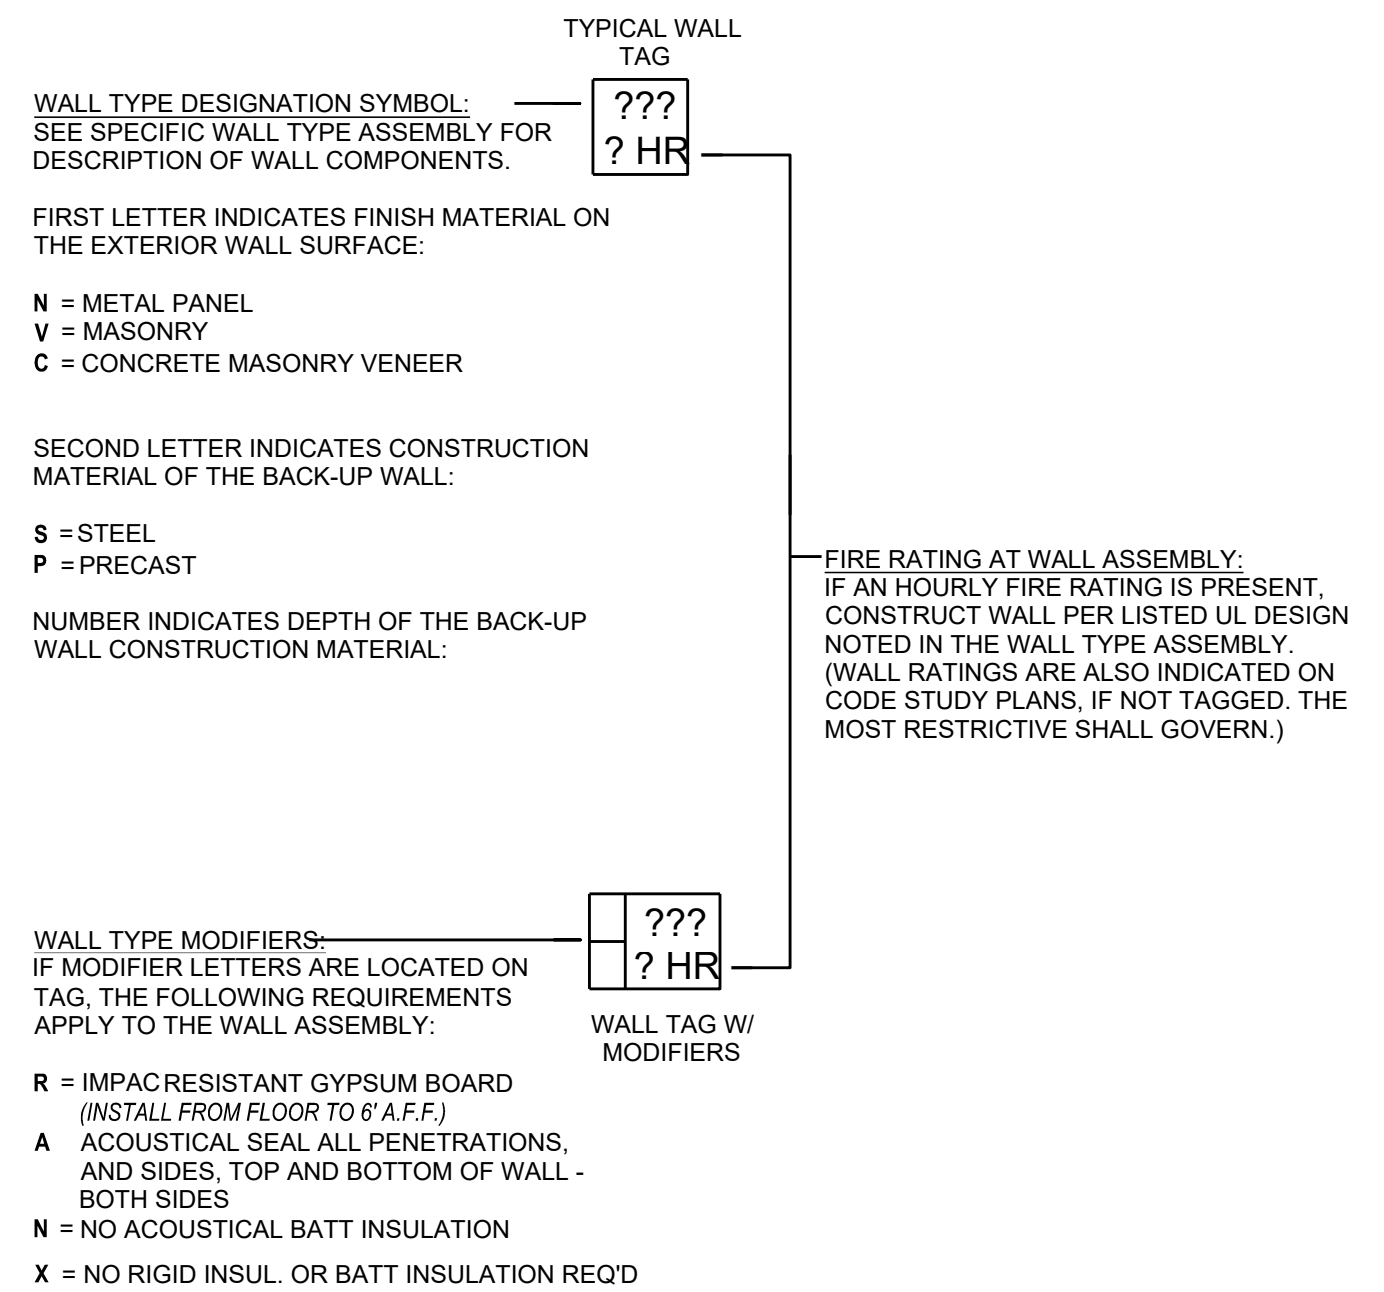

FLOOR SLAB ASSEMBLY - UNINSULATED

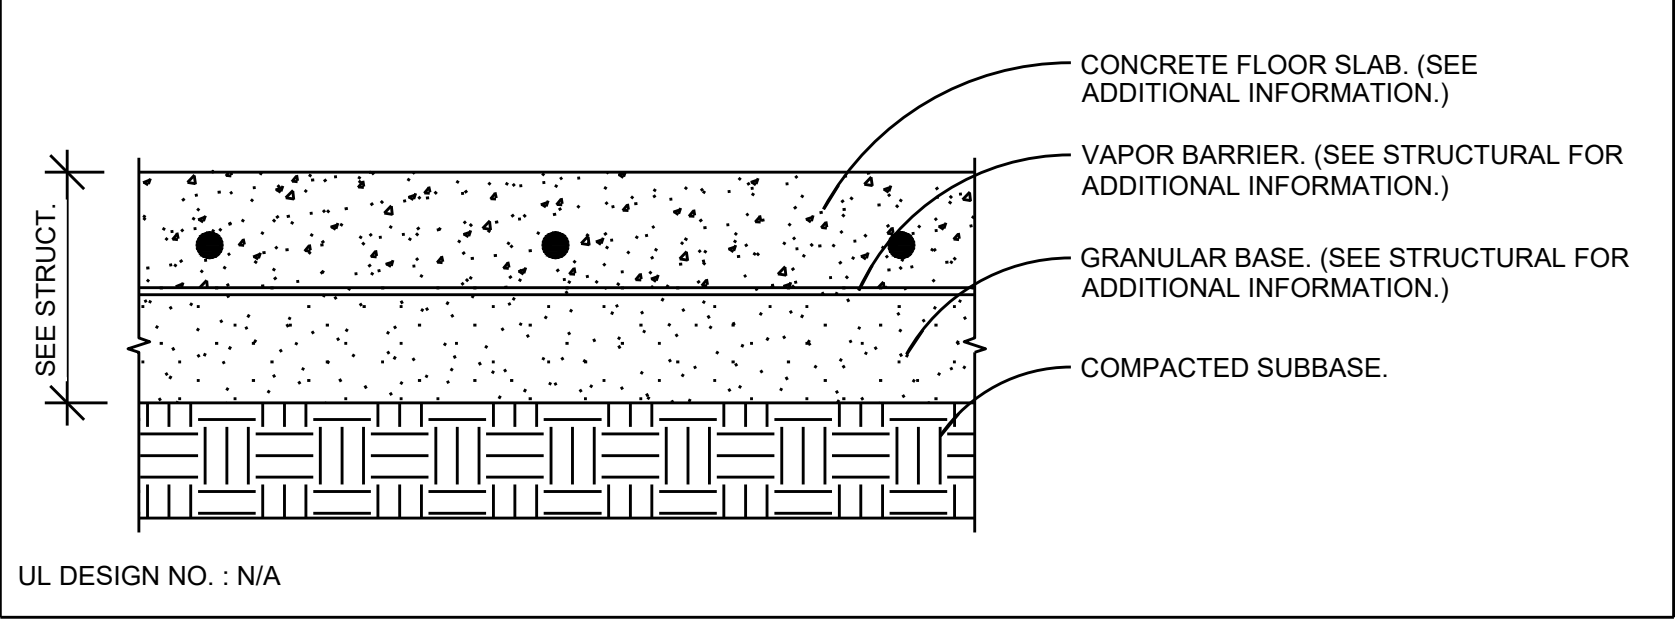

METAL PANEL/ STEEL STUD ASSEMBLIES

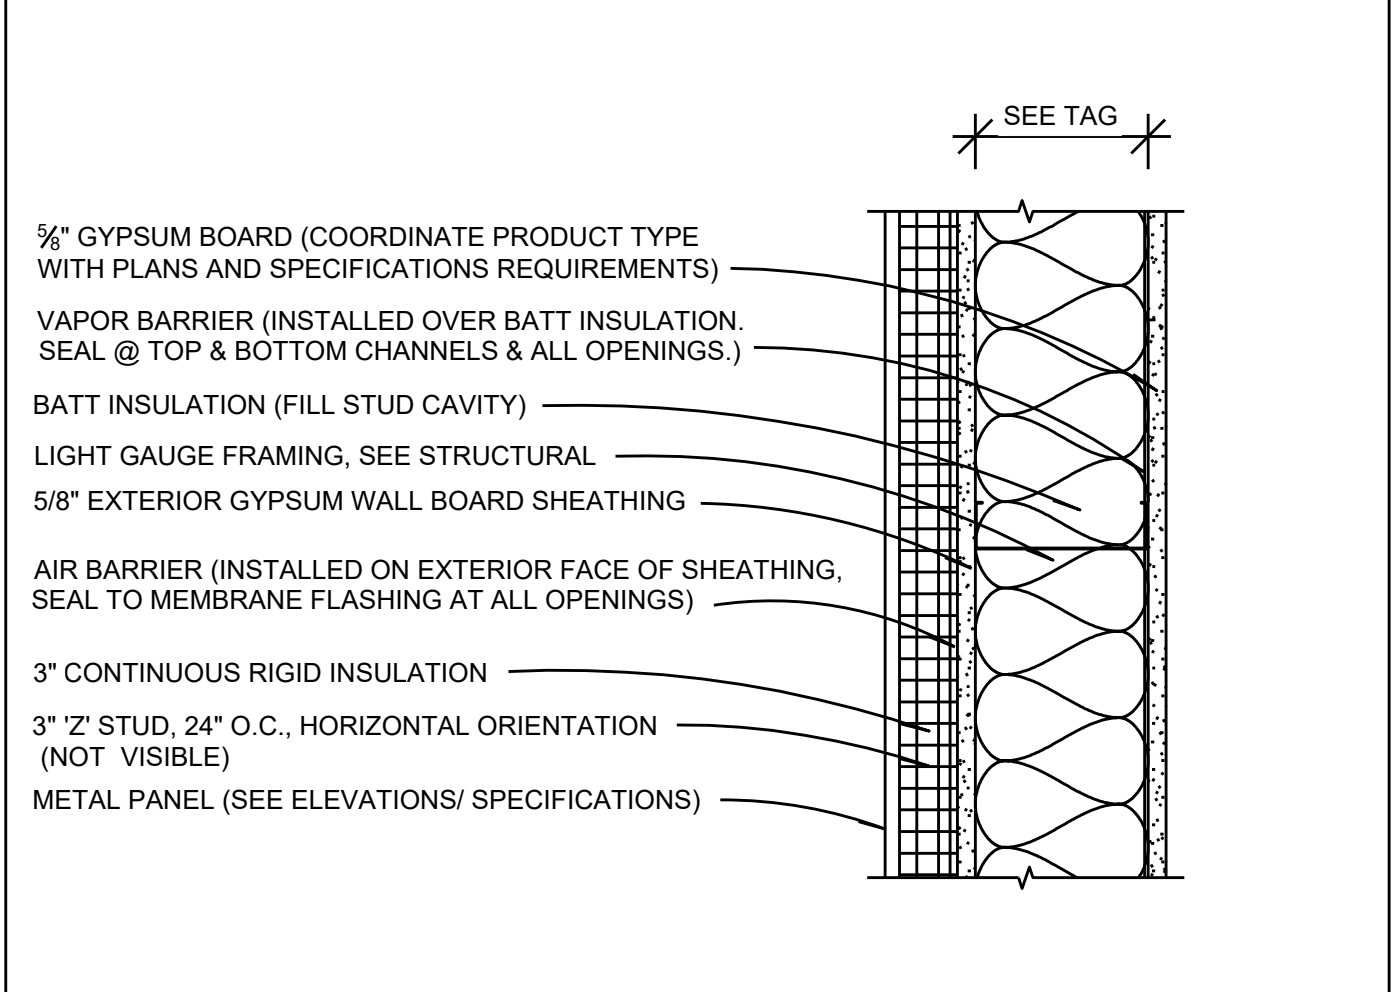


Table with columns: WALL TAG, STUD WIDTH, ASSEMBLY WIDTH, NOTES. Lists assembly types like NS3, NS6, NS8 with their dimensions.

GENERAL NOTES - FRAMED PARTITIONS

- ALL LOAD BEARING WALLS TO BE CONSTRUCTED PER STRUCTURAL ENGINEERS DESIGN REQUIREMENTS. SEE STRUCTURAL SHEETS FOR INFORMATION.
2. ALL PENETRATIONS THROUGH FIRE RATED ASSEMBLIES TO BE FIRE SAFE BY THE TRADE/ CONTRACTOR THAT CREATED THE PENETRATION.



STRUCTURAL HEYER ENGINEERING 4180 24TH AVENUE S FARGO, ND 58104 (701) 280.0949 OFFICE

MARTIN MECHANICAL DESIGN 1201 25TH AVE N FARGO, ND 58102 (701) 293.7957 OFFICE

MBN ENGINEERING 503 7TH ST N #200 FARGO, ND 58102 (701) 478.6336 OFFICE

LOWRY ENGINEERING 5306 51ST AVE S STE A FARGO, ND 58104 (701) 235.0199 OFFICE

LONGFELLOW ELEMENTARY, NORTH HIGH SCHOOL, OPERATIONS CENTER drawing sheets listed.

WASHINGTON ELEMENTARY drawing sheets listed.

DRAWING HISTORY table with columns: NO., DESCRIPTION, DATE. Shows construction documents and addendums.

DRAWN BY: TA/AO/AF/KD JN: 24-060

LIST OF ABBREVIATIONS

LIST OF ABBREVIATIONS DESCRIPTION
ACM - ASBESTOS CONTAINING MATERIAL
ACT - ACCOUSLID CEILING TILE
ADA - AMERICANS WITH DISABILITIES ACT
AFF - ABOVE FINISH FLOOR
AHU - AIR HANDLING UNIT
ALT - ALTERNATE
AC - ALTERNATING CURRENT
ALUM - ALUMINUM
ACI - AMERICAN CONCRETE INSTITUTE
AISC - AMERICAN INSTITUTE OF STEEL CONSTRUCTION
ANSI - AMERICAN NATIONAL STANDARDS INSTITUTE
ASHRAE - AMERICAN SOCIETY OF HEATING REF. AND AIR CONDITIONING ENGINEERS
ARCH - ARCHITECT
AE - ARCHITECT/ENGINEER
ASI - ARCHITECTURAL SUPPLEMENTAL INSTRUCTION
AWI - AMERICAN WOODWORKING INSTITUTE
BM - BEAM
BRG - BEARING
BD - BOARD
BOT - BOTTOM
BTU - BRITISH THERMAL UNITS
BLDG - BUILDING
BUR - BUILT UP ROOFING
CAB - CABINET
CB - CATCH BASIN
CPT - CARPET
CSMT - CASEMENT
CSWK - CASEWORK
CIP - CAST IN PLACE
CI - CAST IRON
CLG - CEILING
CT - CERAMIC TILE
CO - CLEAN OUT
CLR - CLEAR
CONC - CONCRETE
CMU - CONCRETE MASONRY UNIT
CJ - CONTROL JOINT
CG - CORNER GUARD
CUH - CABINET UNIT HEATER
DEMO - DEMOLITION
DEPT - DEPARTMENT
DTL - DETAIL
DIAG - DIAGONAL
DIA - DIAMETER
DM - DIMENSION
DW - DISHWASHER
DIST - DISTANCE
DOC - DOCUMENT
DR - DOOR
DWG - DRAWING
DF - DRINKING FOUNTAIN
EA - EACH
ELEC - ELECTRIC
ELEV - ELEVATOR/ELEVATOR
EWC - ELECTRIC WATER COOLER
EQ - EQUAL
EQUIP - EQUIPMENT
EXIST - EXISTING
EP - EPOXY PAINT
EJ - EXPANSION JOINT
EIFS - EXTERIOR INSULATION FINISH SYSTEM
FIN - FINISH
FLR - FLOOR
FEC - FIRE EXTINGUISHER CABINET
FHC - FIRE HOSE CABINET
FD - FLOOR DRAIN
FTG - FOOTING
FF - FINISH FLOOR
FFE - FURNITURE, FIXTURE, AND EQUIPMENT
FND - FOUNDATION
FWC - FABRIC WALL COVERING
GC - GENERAL CONTRACTOR
GALV - GALVANIZED
GEN - GENERAL
GL - GLASS GLAZING
GWB - GYPSUM WALL BOARD
HCP - HANDICAP
HDW - HARDWARE
HDWD - HARDWOOD
HM - HOLLOW METAL
HORIZ - HORIZONTAL
HT - HEIGHT
HB - HOSE BIB
INSUL - INSULATION
IBC - INTERNATIONAL BUILDING CODE
JAN - JANITOR
LAM - LAMINATE
LAV - LAVATORY
MAS - MASONRY
MB - MARKER BOARD
MDF - MEDIUM DENSITY FIBERBOARD
ML - MATCHLINE
MTL STD - METAL STUD
MTL - METAL
MH - MANHOLE
MECH - MECHANICAL
NIC - NOT IN CONTRACT

LIST OF ABBREVIATIONS

LIST OF ABBREVIATIONS DESCRIPTION
NC - NON COMBUSTIBLE
NOM - NOMINAL
NTS - NOT TO SCALE
OH - OVERHEAD
OC - ON CENTER
OFCI - OWNER FURNISHED CONTRACTOR
OFI - OWNER FURNISHED OWNER INSTALLED
OSB - ORIENTED STRAND BOARD
PT - PAINT
PREV - PREVIOUS
PB - PARTICLE BOARD
PC - PRECAST
PLYWD - PLYWOOD
PLAM - PLASTIC LAMINATE
PLAST - PLASTER
PTD - PAPER TOWEL DISPENSER
PREV - PREVIOUS
REIN - REINFORCEMENT
REQD - REQUIRED
REV - REVERSE
RM - ROOM
RO - ROUGH OPENING
RAD - RADIUS
RTU - ROOF TOP UNIT
SD - SOAP DISPENSER
SIM - SIMILAR
SHT - SHEET
SPEC - SPECIFICATIONS
SECT - SECTION
SD - SMOKE DETECTOR
SG - SQUARE
SUSP - SUSPEND
TC - THIN COAT
TPD - TOILET PAPER DISPENSER
TP - TOILET PARTITION
TRTD - TREATED
TS - TRANSITION STRIP
TYP - TYPICAL
TEMP - TEMPORARY/TEMPERATURE
TO - TOP OF
UL - UNDERWRITERS LABORATORIES
UNO - UNLESS NOTED OTHERWISE
VCT - VINYL COMPOSITION TILE
WDW - WINDOW
W - WITH
WD - WOOD
CPT-1 - CARPET TILE
QT - QUARRY TILE
VB - VINYL BASE
VWC - VINYL WALL COVERING
SV - SHEET VINYL
OTS - OPEN TO STRUCTURE
CBP - CEMENT BACKER BOARD
MIR - MIRROR
BO - BY OWNER
BRK - BRICK
CMU-G - CONCRETE MASONRY UNIT (GLAZED)
CMU-S - CONCRETE MASONRY UNIT (STANDARD FIVE SCORED)
CMU-B - CONCRETE MASONRY UNIT (BURNISHED)
CONC-S - SEALED CONCRETE
PRF - PREFINISHED
CS - CAST STONE
EXP - EXPOSED
FRP - FIBERGLASS REINFORCED PANEL
PT-E - PAINT- EPOXY
LVT - LUXURY VINYL TILE
FRT - FRY REGLET REVEAL TRIM
SDT - STATIC DISSIPATIVE TILE
RSTR - RUBBER STAIR TREADS-RISERS
SC - SPECIAL COATING-SEE SPECS
OWB - OPERABLE WALL PANEL
RB - RUBBER BASE
WOM - WALK-OFF MAT
SLT - SLATE
SS - SOLID SURFACE
ST - STONE
SWU - SOUND-ABSORBING WALL UNIT
STN - STAIN
VP - VINYL PLANK FLOORING
VT - VINYL TILE FLOORING
WRS - WINDOW ROLLER SHADES
CPT-AS - CARPET-ANT-STATIC
CPT-ESD - CARPET-ELECTROSTATIC DISCHARGE
MTLP - METAL PROFILE TRIM
PWP - PREFINISHED WALL PANEL
CTR - COUNTER
TBWP - TRAFFIC BEARING WATER PROOFING
RAF - RESILIENT RUBBER FLOORING
GB - GRAB BAR
EHD - ELECTRIC HAND DRYER
WR - WASTE RECEPTACLE
SND - SANITARY NAPKIN DISPOSAL
SCD - SEAT COVER DISPENSER
SNV - SANITARY NAPKIN VENDING MACHINE
MBH - MOP/ BROOM HOLDER
RH - ROBE HOOK
BCS - BABY CHANGING STATION
SCR - SHOWER CURTAIN ROD
LVR - LOUVER

GENERAL NOTES

- PROJECT GENERAL NOTES DESCRIPTION**
- NOTIFY ARCHITECT PROMPTLY IF ANY CONDITIONS CONFLICT WITH THE CONSTRUCTION DOCUMENTS
 - FIELD VERIFY ALL EXISTING CONDITIONS AND DIMENSIONS PRIOR TO FABRICATION/CONSTRUCTION
 - CONTRACTORS TO VERIFY ALL EXISTING CONDITIONS, VISIT SITE AND FAMILIARIZE THEMSELVES WITH ALL EXISTING CONDITIONS.
 - DIMENSIONS AND ELEVATIONS AS SHOWN ON THE DRAWINGS MUST BE FIELD VERIFIED AND COORDINATED
 - COORDINATE ALL PENETRATIONS THRU FOUNDATION W/APPROPRIATE TRADES.
 - PROVIDE A SAFE MEANS OF EGRESS THROUGH AND/OR AROUND THE BUILDING AND SITE AT ALL TIMES DURING THE CONSTRUCTION PHASE. SIDEWALKS FRONTING THE BLDG SHALL REMAIN USABLE AND CLEARED OF MUD OR OTHER DEBRIS. CONTRACTOR WILL MAINTAIN A CLEAR AND REASONABLE WORK AREA TO BE COORDINATED WITH BUILDING MANAGER/OWNERS REPRESENTATIVE.
 - CONTRACTOR SHALL VERIFY AND PROVIDE ANY ROUGH-IN CONSTRUCTION REQUIRED FOR OWNER-INSTALLED EQUIPMENT CALLED OUT IN DRAWINGS OR SPECIFICATIONS UNLESS OTHERWISE NOTED
 - MINIMUM SLIP RESISTANCE OF FLOOR SURFACES-WALKING SURFACES (GENERAL): 0.5 STATIC COEFFICIENT OF FRICTION-ACCESSIBLE ROUTES; 0.6 STATIC COEFFICIENT OF FRICTION-RAMP; 0.8 STATIC COEFFICIENT OF FRICTION
 - ALL DIRECTIONAL REFERENCES IN DRAWINGS SHALL REFER TO PLAN NORTH
 - ALL JOINTS & PENETRATIONS SHALL BE FIRE SAFED & FIRE SEALED AS REQUIRED TO COMPLY WITH APPLICABLE BUILDING CODES.
 - KEYNOTES ARE USED TO ASSIST IN NOTING AND INDICATE REPETITIVE INSTANCES.
 - SUSPENDED CEILING HEIGHTS ARE DIMENSIONED FROM FINISHED FLOOR.
 - COORDINATE EXACT LOCATIONS OF LIGHT FIXTURES, ACCESS PANELS, SPRINKLER HEADS, HVAC DUCTS, CEILING DIFFUSERS/GRILLES AND ANY ADDITIONAL CEILING ITEMS WITH MECHANICAL AND ELECTRICAL CONTRACTORS AND ARCHITECT. ALL SPRINKLER HEADS SHALL BE PLACED IN THE CENTER OF CEILING TILES. NOTIFY ARCHITECT PROMPTLY IF ANY LOCATIONS CONFLICT.

SYMBOLS LEGEND

	CENTER LINE		MATCHLINE REFERENCE
	DOOR TAG		NORTH ARROW W/ TRUE NORTH
	GRID BUBBLE		
	KEYNOTE TAG		
	DEMO TAG / INTERIOR SIGNAGE		
	EXTERIOR MATERIAL TAG		View Name 1/8" = 1'-0"
	WALL TAG		
	WINDOW TAG		
	SPOT ELEVATION TAG		
	LEVEL HEAD		
	HORIZONTAL ASSEMBLY TAG		
	REVISION TAG		
	ROOM TAG		
	ROOM TAG w/ AREA		
	ROOM TAG w/ AREA & OCCUPANT LOAD		
	ROOM TAG w/ ROOM FINISH INFO AT PLANS (NOT ALL MAY BE SHOWN)		
	ROOM TAG w/ EXISTING ROOM NUMBER		

MATERIAL LEGEND

	ALUMINUM		SAND
	CONCRETE		SAND - DENSE
	EARTH		SPRAY FOAM INSULATION
	GRAVEL		STEEL
	GYPSUM		STONE
	MASONRY - BRICK		WOOD - FINISHED CARPENTRY
	MASONRY - CMU		WOOD - ROUGH CARPENTRY
	RIGID INSULATION / EIFS		WOOD - PLYWOOD

DRAWING INDEX

SHEET #	SHEET NAME
GENERAL	
MN-G001	General Notes / Drawing Index
MN-G002	ANSI 117.1 - 2021 Standards w/ 2020 MN Accessibility Code
TROLLWOOD PERFORMING ARTS	
T-C1	Cover Sheet Trollwood
T-C2	General Notes & Legend Trollwood
T-C3	Survey Overlay & Demolition Plan Trollwood
T-C4	Overall Site Plan Trollwood
T-C5	Grading & Utility Plan Trollwood
T-C6	Erosion & Sediment Control Plan Trollwood
T-C7	Details Trollwood
T-C8	Details Trollwood
T-A000	Trollwood Performing Arts Overall Site Plan
T-A001	Trollwood Performing Arts Site Plan - Enlarged
T-A101	Trollwood Performing Arts Portable Classroom Plans
T-M100	Main Floor Plumbing Demo & Remodel - Trollwood
T-E101	Trollwood Performing Arts Portable Classroom Plans - Electrical



FARGO PUBLIC SCHOOLS

STRUCTURAL
HEYER ENGINEERING
4180 24TH AVENUE S
FARGO, ND 58104
(701) 280.0949 OFFICE

MECHANICAL
MARTIN MECHANICAL DESIGN
1201 25TH AVE N
FARGO, ND 58102
(701) 293.7957 OFFICE

ELECTRICAL
MBN ENGINEERING
503 7TH ST N #200
FARGO, ND 58102
(701) 478.6336 OFFICE

ELECTRICAL
CMTA
2201 12TH ST N STE E
FARGO, ND 58102
(701) 280.0500 OFFICE

CIVIL
LOWRY ENGINEERING
5306 51ST AVE S STE A
FARGO, ND 58104
(701) 235.0199 OFFICE

ARCHITECT:
I HEREBY CERTIFY THAT THIS PLAN, SPECIFICATION, OR REPORT WAS PREPARED BY ME OR UNDER MY DIRECT SUPERVISION AND THAT I AM A DULY LICENSED ARCHITECT UNDER THE LAWS OF THE STATE OF MINNESOTA.

SIGNATURE:
PRINTED NAME: TODD BLIXT
DATE: 12/18/24
LICENSE NUMBER: 62763

DRAWING HISTORY

NO.	DESCRIPTION	DATE
1	ADDENDUM #1	12/30/24

DRAWN BY: TA/AO/AF/KD JN: 24-060

General Notes / Drawing Index

SHEET
MN-G001




FARGO PUBLIC SCHOOLS
TROLLWOOD PERFORMING ARTS
801 50TH AVE S
MOORHEAD, MN 56560

STRUCTURAL
HEYER ENGINEERING
4180 24TH AVENUE S
FARGO, ND 58104
(701) 280.0949 OFFICE

MECHANICAL
MARTIN MECHANICAL DESIGN
1201 25TH AVE N
FARGO, ND 58102
(701) 293.7957 OFFICE

ELECTRICAL
CMTA
2201 12TH ST N STE E
FARGO, ND 58102
(701) 280.0500 OFFICE

CIVIL
LOWRY ENGINEERING
5306 51ST AVE S STE A
FARGO, ND 58104
(701) 235.0199 OFFICE

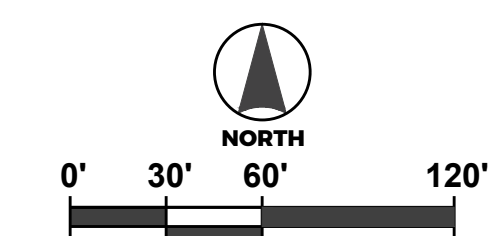

ARCHITECT:
I HEREBY CERTIFY THAT THIS PLAN, SPECIFICATION, OR REPORT WAS PREPARED BY ME OR UNDER MY DIRECT SUPERVISION AND THAT I AM A DULY LICENSED ARCHITECT UNDER THE LAWS OF THE STATE OF MINNESOTA.

SIGNATURE: *[Signature]*
PRINTED NAME: TODD BLIXT
DATE: 12/18/24
LICENSE NUMBER: 62763

DRAWING HISTORY

NO.	DESCRIPTION	DATE
1	CONSTRUCTION DOCUMENTS	12/18/24
1	ADDENDUM #1	12/30/24

DRAWN BY: TA/AQ/AF/KD JN: 24-060

Trollwood Performing Arts Site Plan - Enlarged

SHEET

T-A001



GENERAL NOTES - SITE PLAN

- CONTRACTOR TO SAND AND PREPARE EXISTING GLULAM ARCHES AS NECESSARY AT EACH END OF THE FOUR (4) EXISTING ARCHES. CRACKS GREATER THAN OR EQUAL TO 1/8" THICKNESS TO BE FILLED WITH EPOXY. REMOVAL OF (E) STEEL STRUTS NOT REQUIRED. PROVIDE CAULK AROUND TOP AND SIDES OF (E) STRUTS. BOTTOM OF STRUTS TO REMAIN UNCALKED. CONTRACTOR TO RESTAIN AND RESEAL ARCH AS NECESSARY ONCE CRACK INFILL HAS OCCURRED. SUBMIT PROPOSED EPOXY MATERIALS FOR APPROVAL PRIOR TO COMMENCING WORK. NOTIFY ARCHITECT/ENGINEER OF ANY DISCREPANCIES DISCOVERED.
REMOVE AND REINSTALL SEATING AS NEEDED TO ACCESS GLULAM ARCHES FOR REFINISHING.

KEYNOTES - SITE PLAN

- REPLACE ASPHALT PARKING LOT AND EXISTING DRAINAGE
- SEE CIVIL
- REPLACE ASPHALT WITH CONCRETE PAVEMENT, CURB & GUTTER
- SEE CIVIL
- REMOVE ADA PARKING SIGN AND BASE
- SEE CIVIL FOR NEW SIGN LOCATIONS
- INSTALL GROUND PROTECTION MESH AT DRIVE LANES
- SEE SPECIFICATIONS FOR MORE INFORMATION
- SAND AND REMOVE EXISTING STAIN & VARNISH FROM WOOD LAMINATE ARCH. FILL CRACKS & WOOD CHECKS GREATER THAN 1/8" IN WIDTH. APPLY STAIN & CLEAR COAT FINISH.
- USE AN EPOXY WITH A VISCOUS, TOOTH PASTE LIKE CONSISTENCY. AS THINNER, WATERY EPOXIES CAN BE DIFFICULT TO CONTROL AND MAY SEEP EXCESSIVELY.
- APPLY TAPE TO THE TOP AND BOTTOM OF THE CRACKS (CHECKS) TO PROTECT THE WOOD AND PREVENT THE EPOXY FROM SPREADING.
- TROWEL THE VISCOUS EPOXY INTO THE CRACKS CAREFULLY FOR BETTER CONTAINMENT AND A CLEANER APPLICATION.
- SEE SPECIFICATIONS FOR DETAILS



FARGO PUBLIC SCHOOLS
TROLLWOOD PERFORMING ARTS
801 50TH AVE S
MOORHEAD, MN 56560

STRUCTURAL

HEYER ENGINEERING
4180 24TH AVENUE S
FARGO, ND 58104
(701) 280.0949 OFFICE

MECHANICAL

MARTIN MECHANICAL DESIGN
1201 25TH AVE N
FARGO, ND 58102
(701) 293.7957 OFFICE

ELECTRICAL

CMTA
2201 12TH ST N STE E
FARGO, ND 58102
(701) 280.0500 OFFICE


CIVIL

LOWRY ENGINEERING
5306 51ST AVE S STE A
FARGO, ND 58104
(701) 235.0199 OFFICE


- GENERAL NOTES - FLOOR PLAN**
- CONTRACTOR TO MOVE ITEMS IN PORTABLE CLASSROOMS IN ORDER TO REPLACE FLOORING. COORDINATE WITH OWNER AS NEEDED FOR RELOCATION.
 - SEE SPECIFICATIONS FOR OTHER ACCESSORIES TO REPLACE WITH FLOORING. (WALL BASE & TRANSITION STRIP)

KEYNOTES - FLOOR PLAN


- REPLACE DOMESTIC WATER HEATER LOCATED IN PORTABLE CLASSROOM - SEE MECHANICAL AND ELECTRICAL
- REPLACE HANDRAILS AND GUARDRAILS AT PORTABLE CLASSROOMS
- REPLACE FLUORESCENT LIGHTING FIXTURES LOCATED IN PORTABLE CLASSROOMS - SEE ELECTRICAL
- REPLACE CARPET AT PORTABLE CLASSROOMS - SEE SPECIFICATIONS FOR MORE DETAILS
- REPLACE TRIM ON CORNERS OF PORTABLE CLASSROOM. COLOR AND MATERIAL TO MATCH EXISTING.
- REPLACE VINYL FLOORING AT PORTABLE CLASSROOM - SEE SPECIFICATIONS FOR MORE DETAILS.

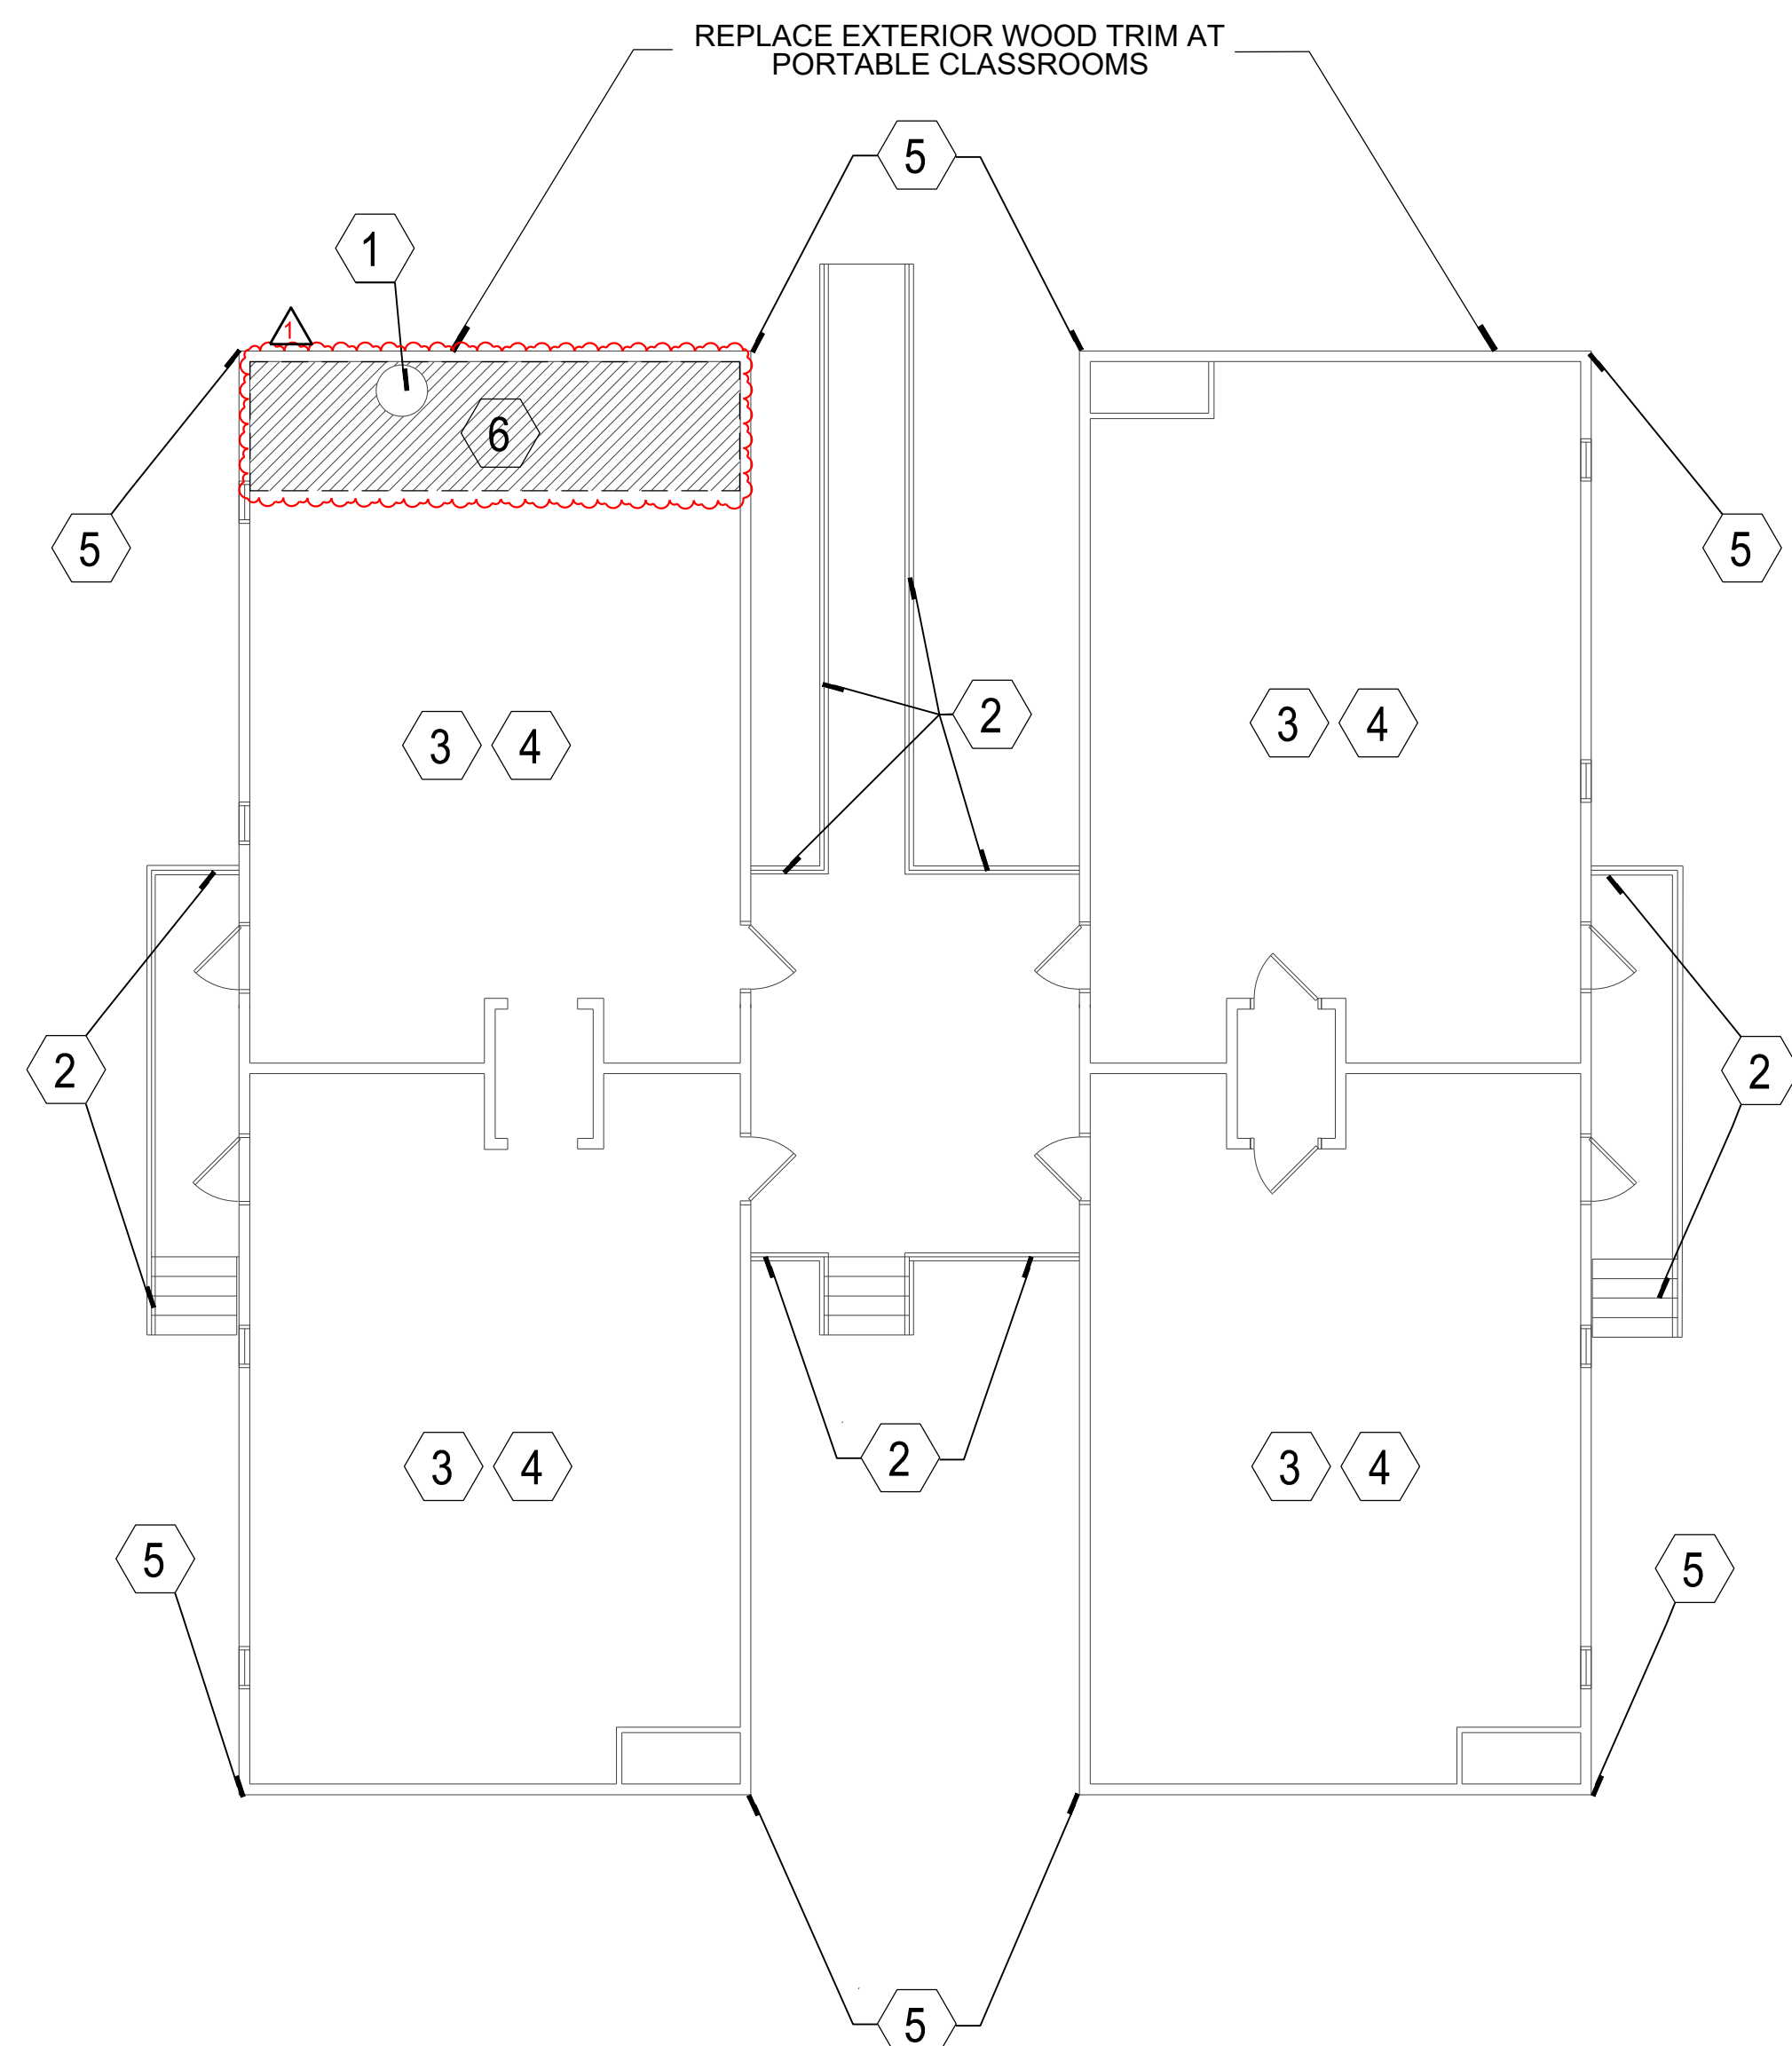


1 T-A101 Trollwood Perform - Portable Classroom Plans
1/2" = 1'-0"

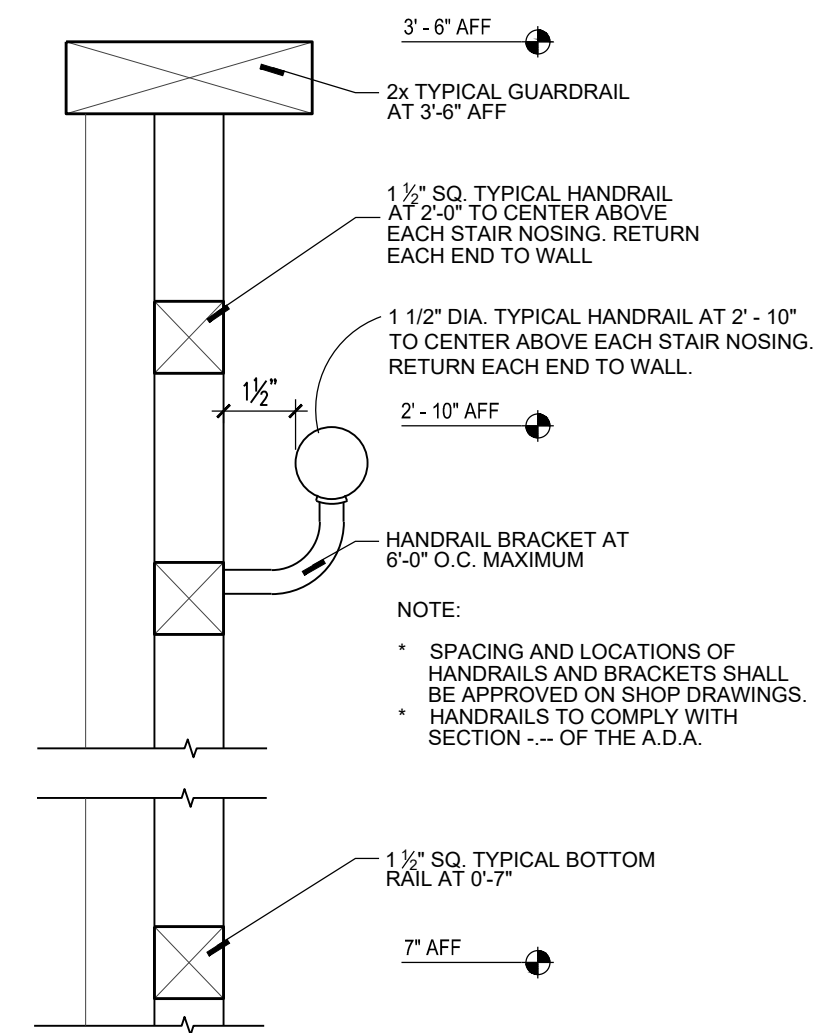


2 T-A101 Vertical Rail Detail
3" = 1'-0"

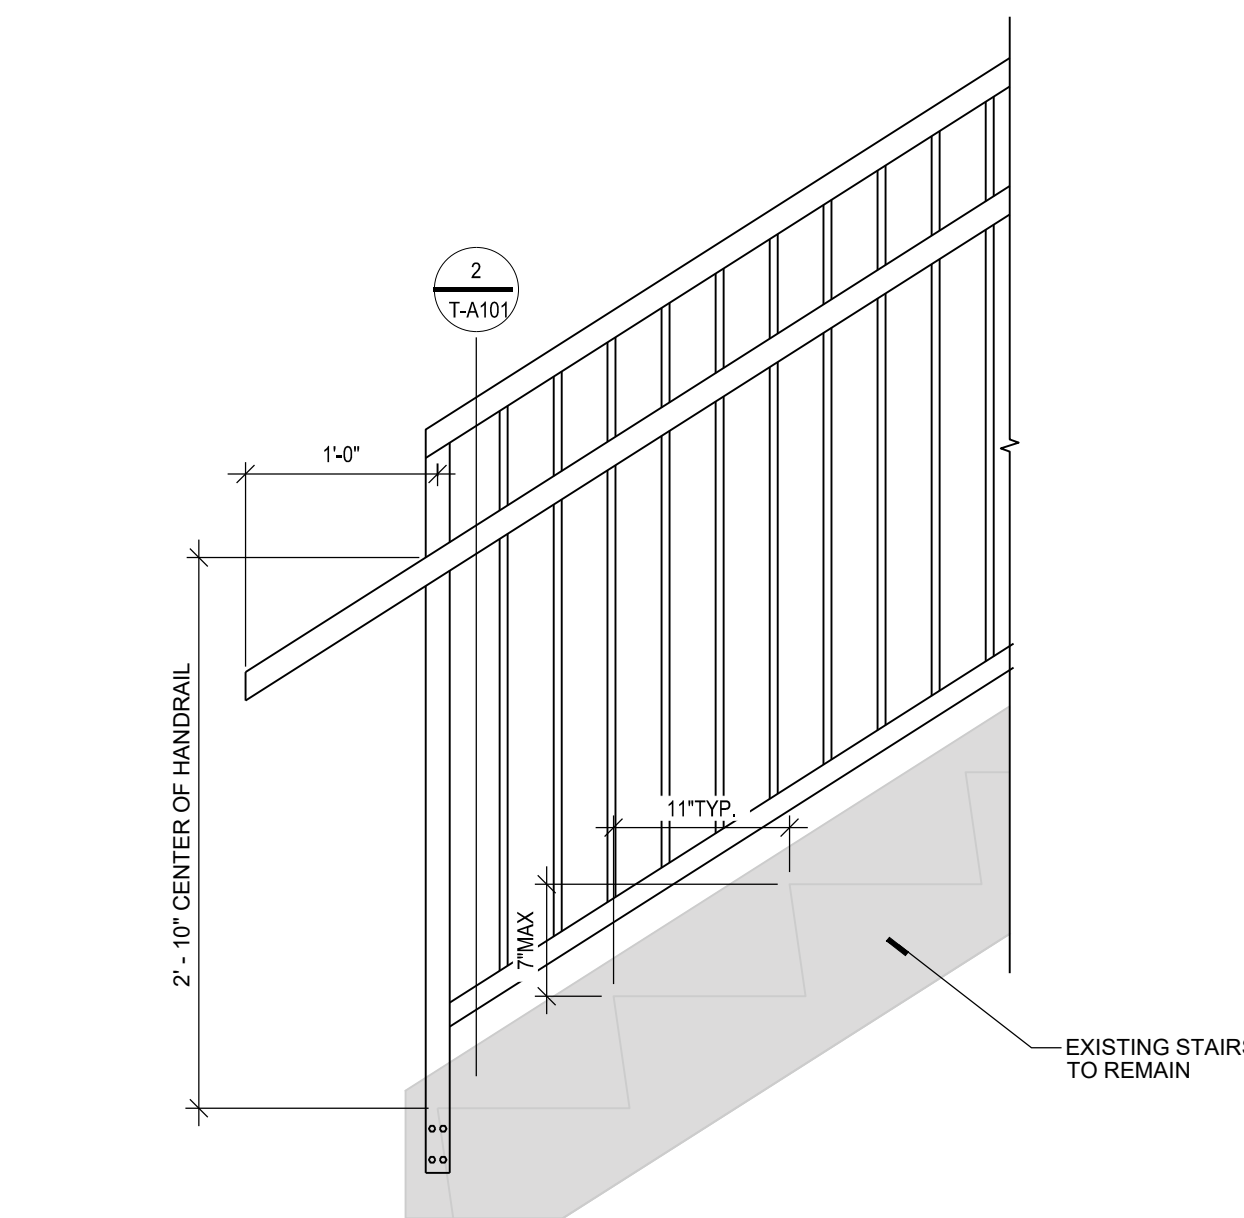


3 T-A101 Bottom Landing - Vertical Pipe
1" = 1'-0"

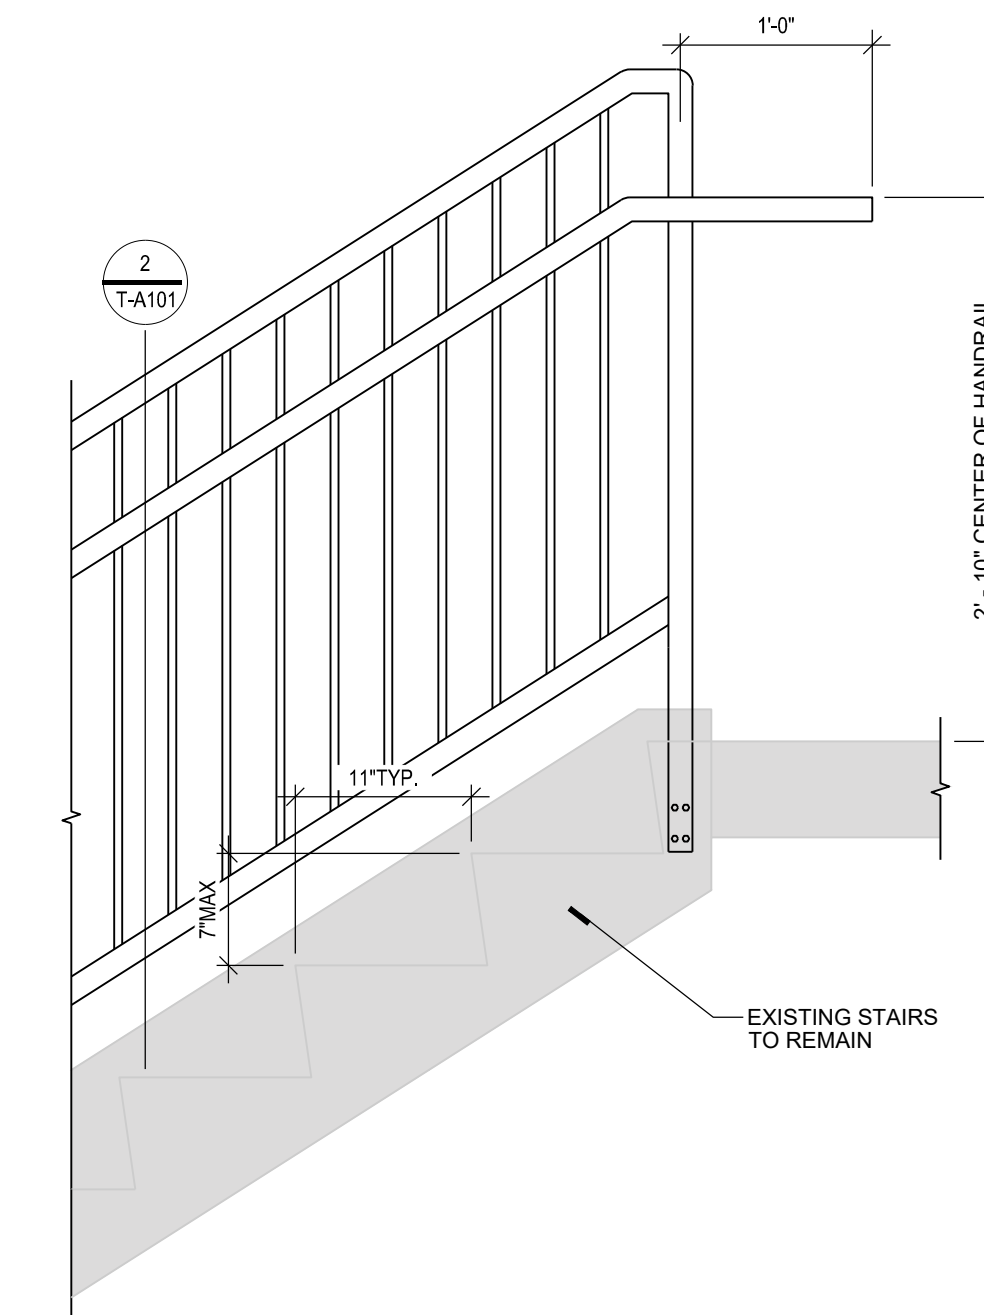

4 T-A101 Bottom Landing - Vertical Pipe
1" = 1'-0"

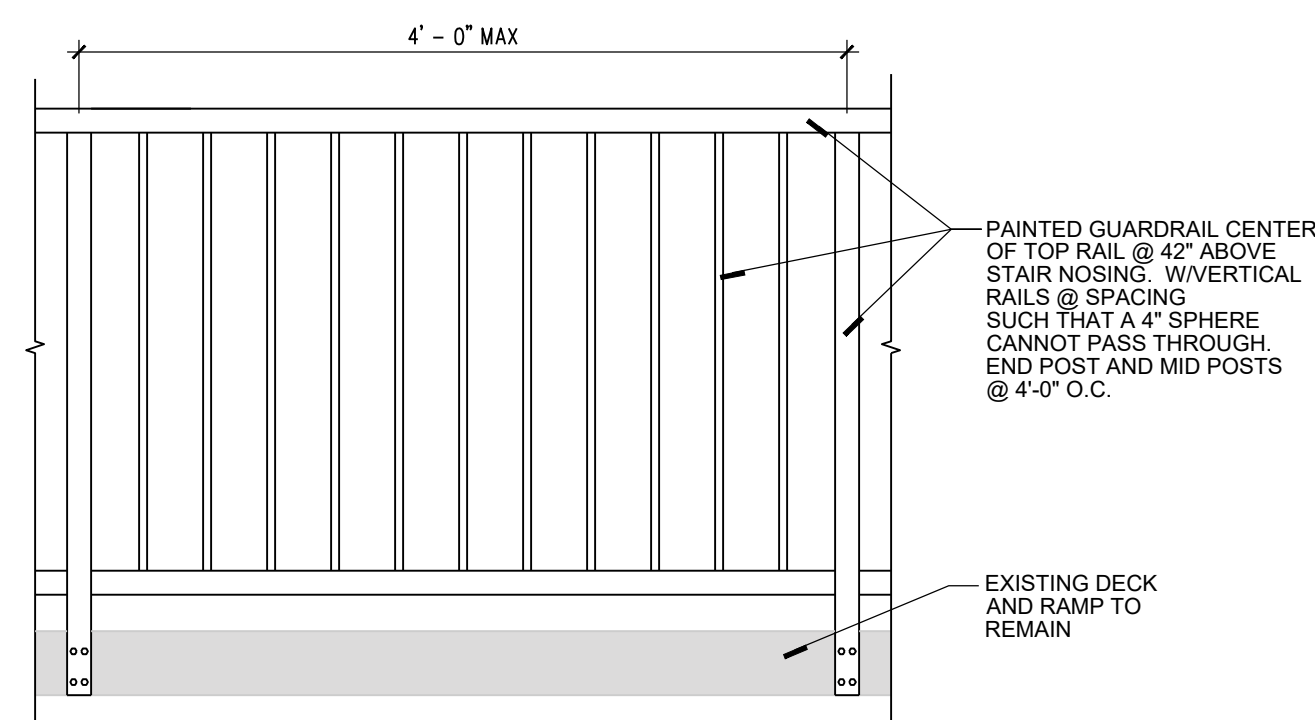

5 T-A101 Guardrail Detail - Vertical 36"
1" = 1'-0"

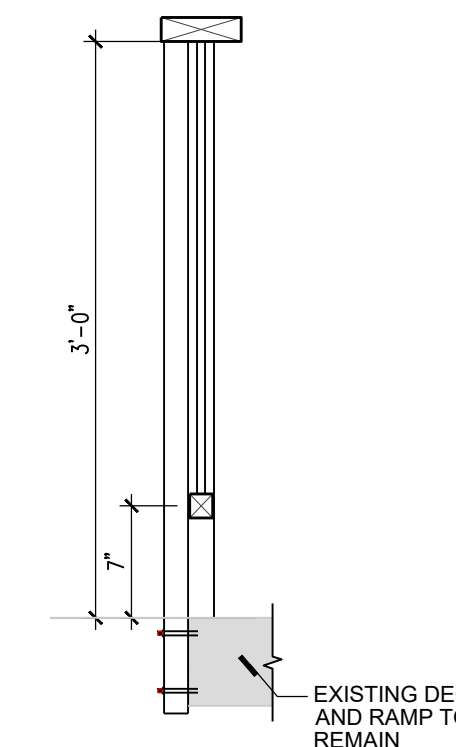

ARCHITECT:
I HEREBY CERTIFY THAT THIS PLAN, SPECIFICATION, OR REPORT WAS PREPARED BY ME OR UNDER MY DIRECT SUPERVISION AND THAT I AM A DULY LICENSED ARCHITECT UNDER THE LAWS OF THE STATE OF MINNESOTA.
SIGNATURE: *[Signature]*
PRINTED NAME: TODD BLUNT
DATE: 12/18/24
LICENSE NUMBER: 62763

DRAWING HISTORY

NO.	DESCRIPTION	DATE
	CONSTRUCTION DOCUMENTS	12/18/24
1	ADDENDUM #1	12/30/24

DRAWN BY: TA/AQ/AF/KD JN: 24-060



Trollwood Performing Arts Portable Classroom Plans

SHEET

T-A101



1 CE-A00 Centennial Elementary Site Plan - Enlarged
1" = 50'-0"

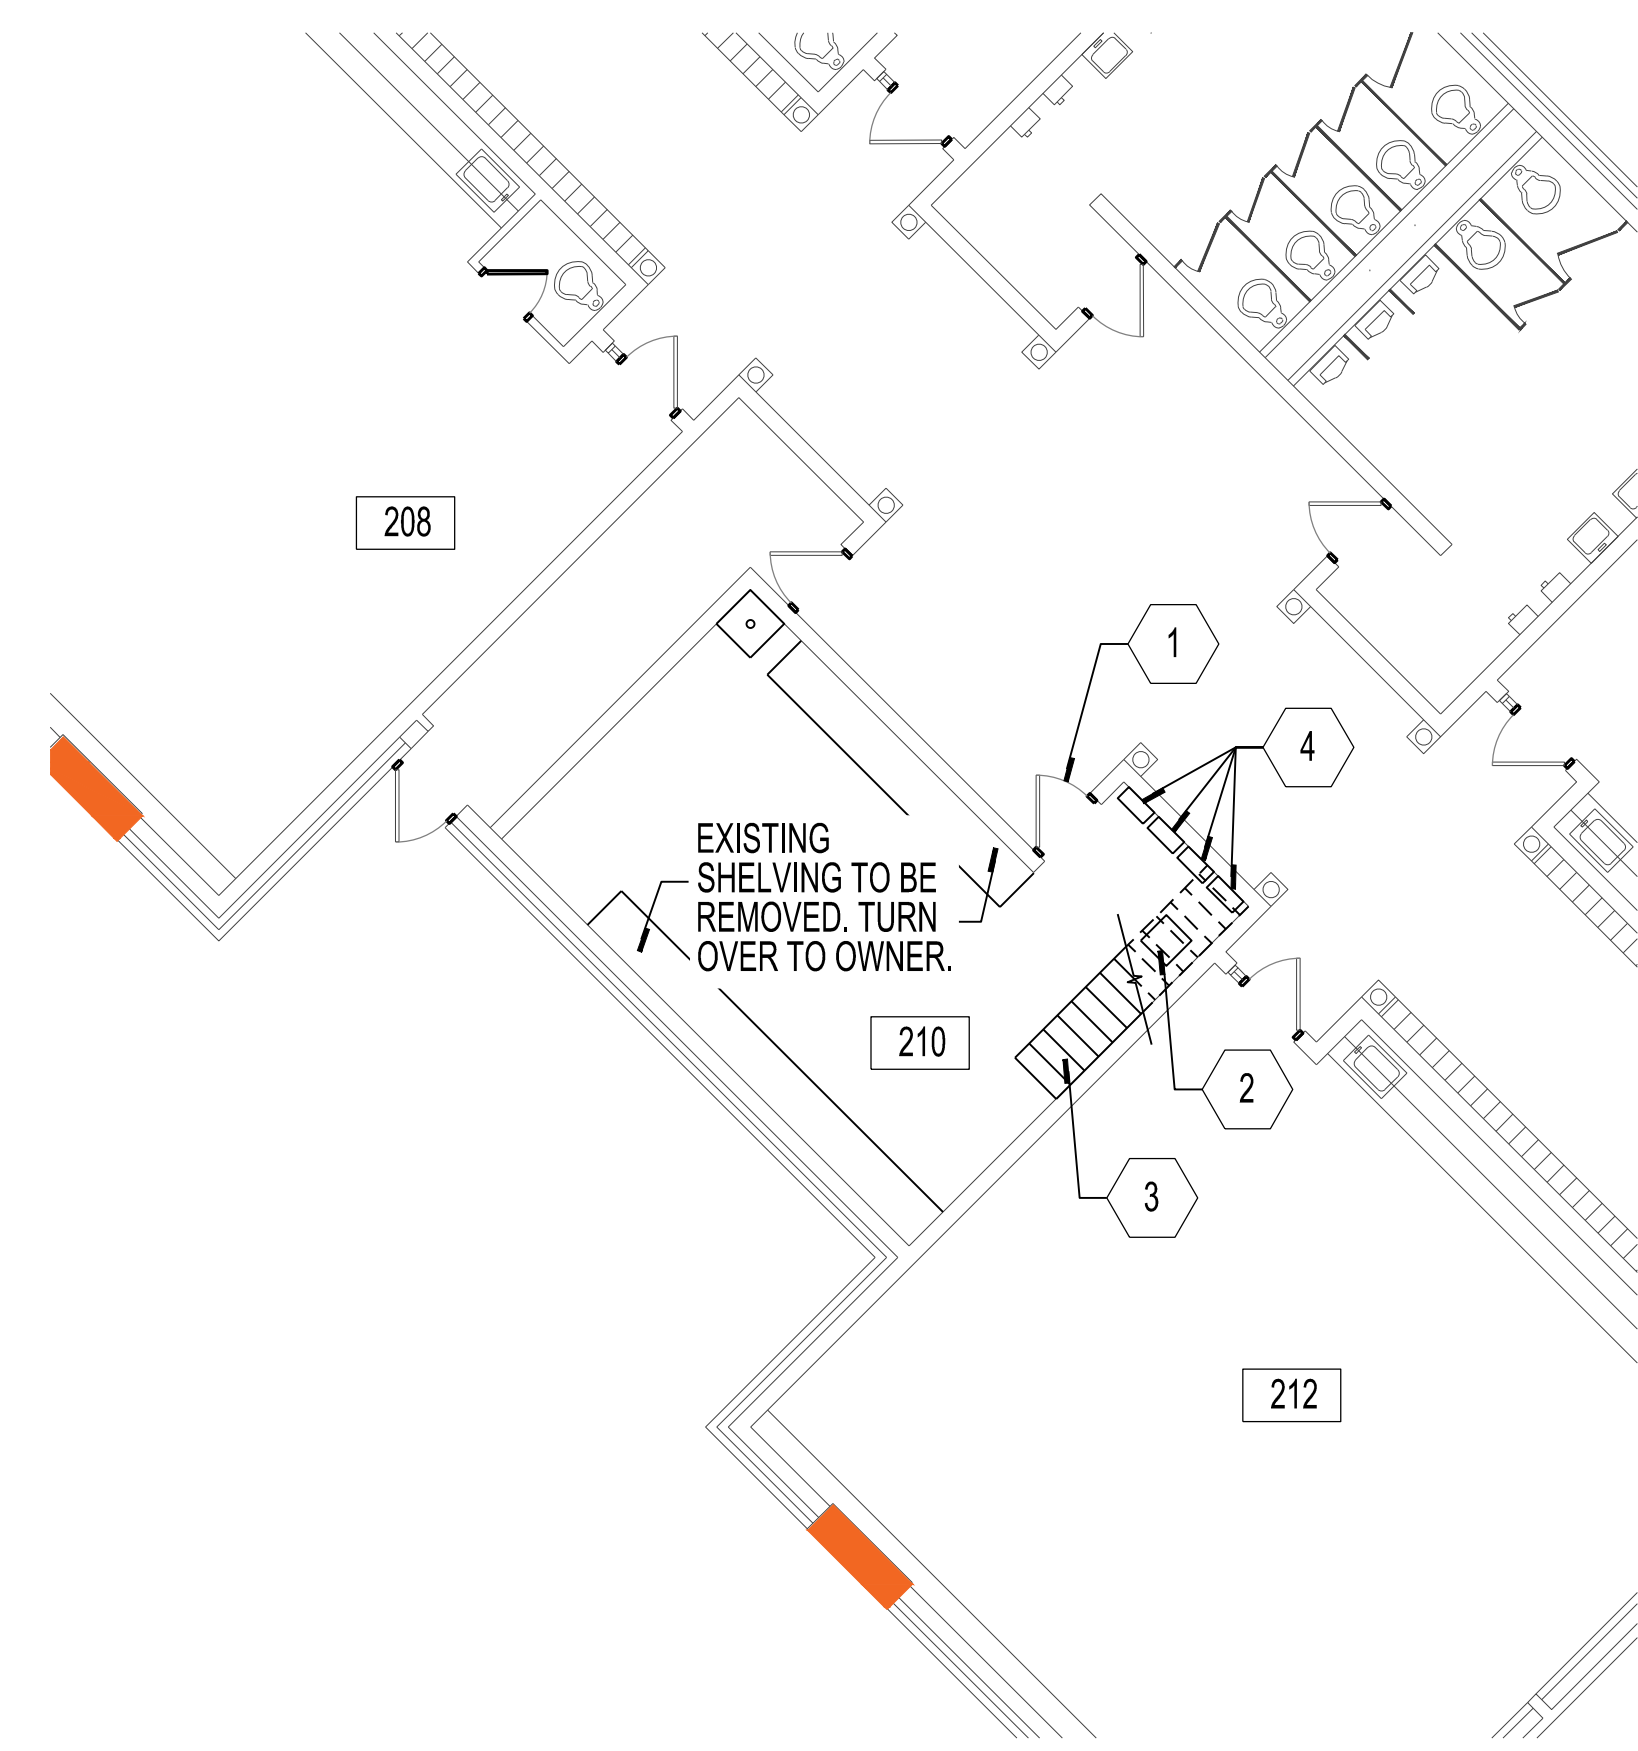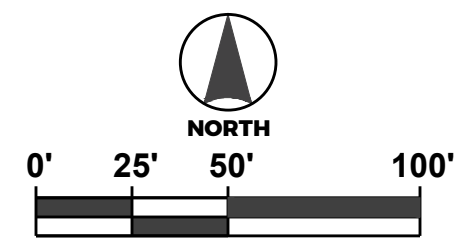

2 CE-A00 Centennial Elementary - Enlarged Floor Plan
1/2" = 1'-0"

GENERAL NOTES - SITE PLAN

1. INTENT IS TO REPLACE THE WINDOW AND REUSE BLOCKING. ONLY REPLACE BLOCKING IF NECESSARY ON A CASE BY CASE BASIS. TAKE CARE WHEN REMOVING EXISTING WINDOW AND REINSTALLING NEW WINDOW TO NOT DAMAGE SURROUNDING WALLS INCLUDING BUT NOT LIMITED TO FINISHES, RADIATORS, AND BRICK.
2. PATCH AND TOUCH UP PAINT AT JAMB AND HEAD AFTER NEW WINDOW INSTALLATION.
3. PATCH AND TOUCH UP PAINT AT DOOR WHEN REINSTALLED.

KEYNOTES - SITE PLAN & FLOOR PLAN

- ① EXISTING DOOR AND FRAME TO BE REMOVED TO ALLOW FOR THE INSTALLATION OF AHU SECTIONS INTO ROOM. REPLACE IN SAME LOCATION FOLLOWING INSTALLATION.
- ② EXISTING DATA RACK TO BE REMOVED TO ALLOW FOR THE INSTALLATION OF AHU SECTIONS INTO ROOM. REPLACE IN SAME LOCATION FOLLOWING INSTALLATION.
- ③ EXISTING METAL STAIRS TO BE REMOVED TO ALLOW FOR THE INSTALLATION OF AHU SECTIONS INTO ROOM. REPLACE IN SAME LOCATION FOLLOWING INSTALLATION.
- ④ EXISTING ELECTRICAL PANEL



4000 GARDEN VIEW DRIVE, SUITE 101
GRAND FORKS, ND 58201
P. 701.772.4266 | F. 701.772.4275
WWW.ICONARCHITECTS.COM




FARGO PUBLIC SCHOOLS
CENTENNIAL ELEMENTARY
4201 25TH ST S
FARGO, ND 58104

STRUCTURAL
HEYER ENGINEERING
4180 24TH AVENUE S
FARGO, ND 58104
(701) 280.0949 OFFICE

MECHANICAL
MBN ENGINEERING
503 7TH ST N #200
FARGO, ND 58102
(701) 478.6336 OFFICE

ELECTRICAL
CMTA
2201 12TH ST N STE E
FARGO, ND 58102
(701) 280.0500 OFFICE

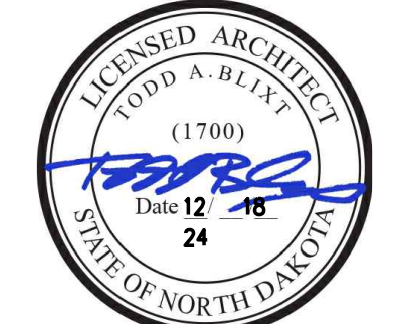

DRAWING HISTORY

NO.	DESCRIPTION	DATE
1	CONSTRUCTION DOCUMENTS	12/18/24
1	ADDENDUM #1	12/30/24

DRAWN BY: TA/AO/AF/KD JN: 24-060

Centennial Elementary Site Plan - Enlarged

SHEET
CE-A001